


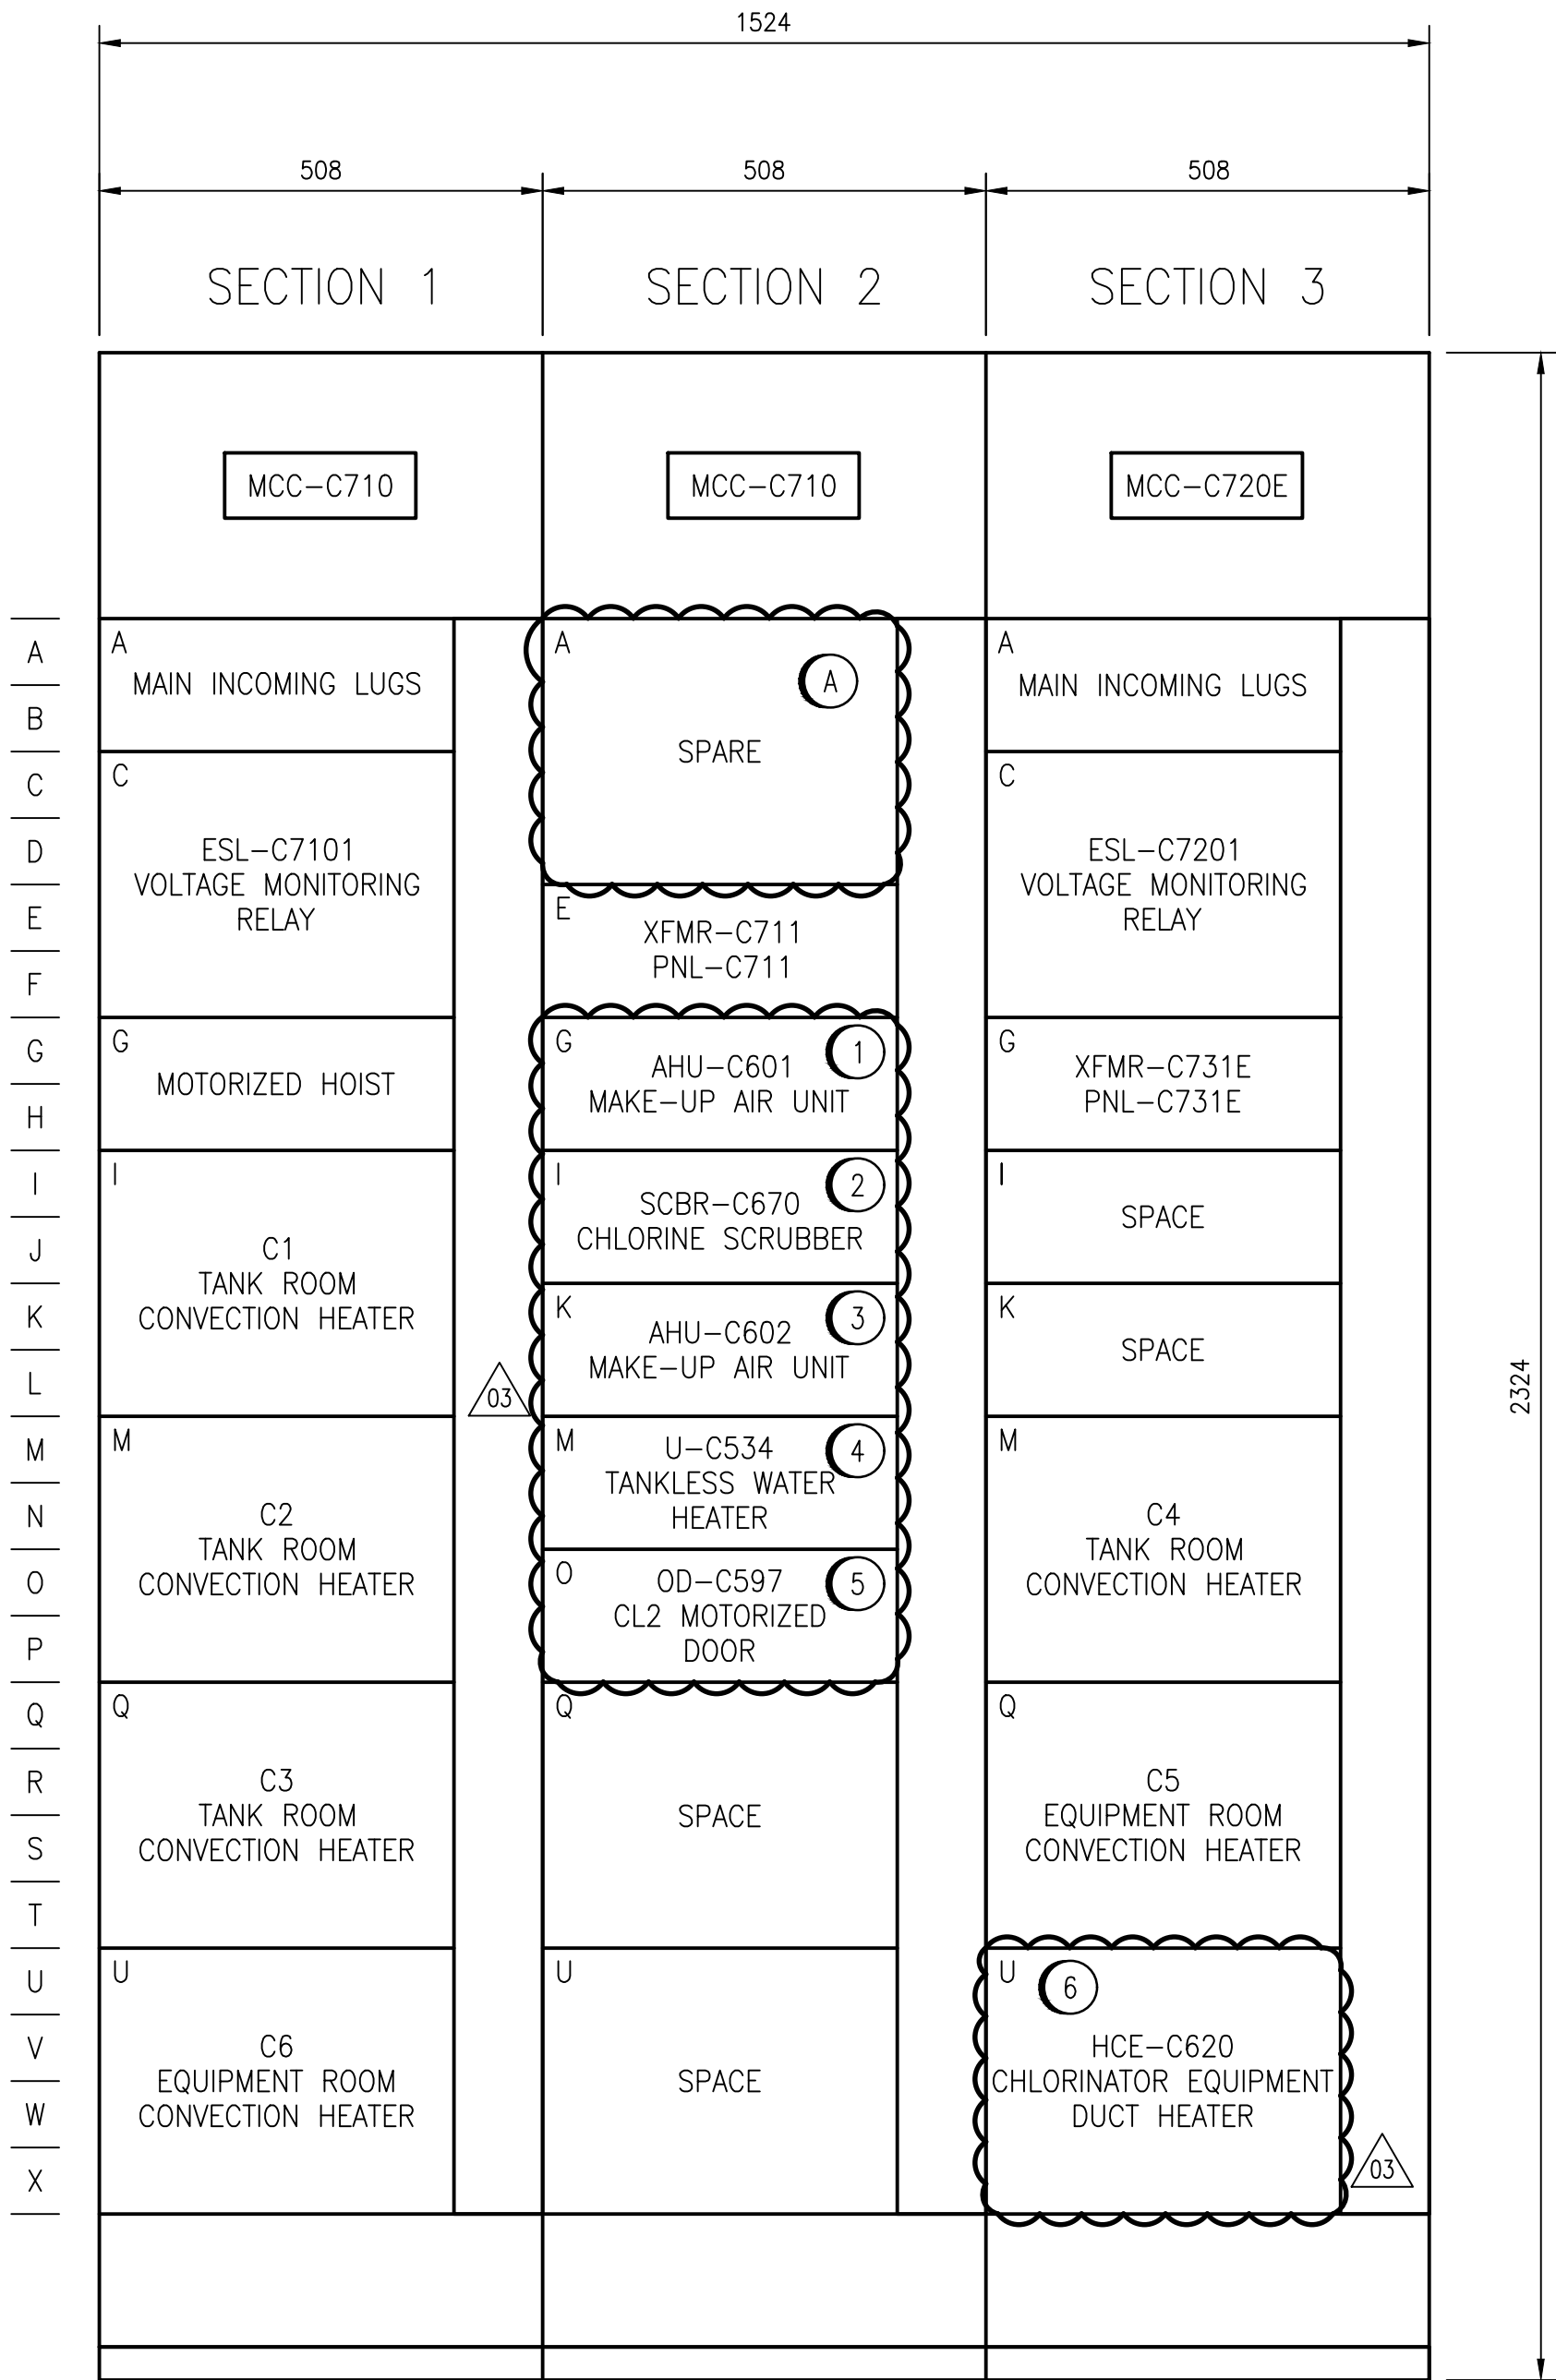

MCC-C710 AND MCC-C720E LAYOUT  
SCALE: 1:8

DEMOLITION NOTES:

- (A) DEMOLISH EXISTING FAN FN4 AND ALL CONDUIT AND CABLING ASSOCIATED WITH POWER AND CONTROLS. SEAL ALL HOLES LEFT BY DEMOLITION. RENAME MCC BUCKET AS SPARE. PROVIDE NEW LAMACOID INDICATING SPARE.

SPECIFIC NOTES:

- (1) PROVIDE NEW MCC BUCKET C/W WITH 100A CIRCUIT BREAKER TO FEED NEW AIR HANDLING UNIT, AHU-C601. REFER TO SCHEMATIC DRAWING 1-0640C-E0018 FOR MORE DETAILS. PROVIDE NEW LAMACOID.
- (2) PROVIDE NEW MCC BUCKET C/W WITH 90A CIRCUIT BREAKER TO FEED NEW CHLORINE SCRUBBER, SCBR-C670. REFER TO INTERCONNECTION DRAWING 1-0640C-E0025 FOR MORE DETAILS. PROVIDE NEW LAMACOID.
- (3) PROVIDE NEW MCC BUCKET C/W WITH 45A CIRCUIT BREAKER TO FEED NEW AIR HANDLING UNIT, AHU-C602. REFER TO SCHEMATIC DRAWING 1-0640C-E0019 FOR MORE DETAILS. PROVIDE NEW LAMACOID.
- (4) PROVIDE NEW MCC BUCKET C/W WITH 125A CIRCUIT BREAKER TO FEED NEW CHLORINE TANKLESS WATER HEATER, U-C534.PROVIDE NEW LAMACOID
- (5) PROVIDE NEW MCC BUCKET C/W WITH 15A CIRCUIT BREAKER TO FEED NEW OVERHEAD MOTORIZED DOOR, OD-C597. PROVIDE NEW LAMACOID.
- (6) PROVIDE NEW MCC BUCKET C/W WITH 15A CIRCUIT BREAKER TO FEED NEW ELECTRIC DUCT HEATER, HCE-C620. MODIFY MCC ACCORDINGLEY IF MCC BUCKET PROVIDED BY VENDOR IS DIFFERENT SIZE.

|               |                                                             |
|---------------|-------------------------------------------------------------|
| 1-0640C-E0012 | ELECTRICAL - HAZARDOUS LOCATION, CHLORINE BLDG GROUND LEVEL |
| 1-0640C-E0006 | PANELBOARD SCHEDULES                                        |
| 1-0640C-E0003 | SINGLE LINE, MCC-C710 & MCC-C720E                           |
| 1-0640C-A0002 | LOOP DIAGRAM, MCC-C710 VOLTAGE PRESENT                      |
| 1-0640C-A0001 | LOOP DIAGRAM, MCC-C720E VOLTAGE PRESENT                     |

|                |                    |
|----------------|--------------------|
| DRAWING NUMBER | REFERENCE DRAWINGS |
|----------------|--------------------|




|                                   |                    |                                     |                                                  |                              |                                                                                         |              |               |                          |                                                                                                  |                                                          |        |       |
|-----------------------------------|--------------------|-------------------------------------|--------------------------------------------------|------------------------------|-----------------------------------------------------------------------------------------|--------------|---------------|--------------------------|--------------------------------------------------------------------------------------------------|----------------------------------------------------------|--------|-------|
| EQUIPMENT ID:<br>MCC-C710         |                    |                                     | VOLTS:<br>600V                                   | RATING:<br>600A              | PHASE:<br>3P                                                                            | WIRE:<br>3 W | MAIN BREAKER: | MAIN BREAKER TYPE:<br>-- | MAIN BREAKER SETTINGS:<br>LTPU: 600A INST: --<br>LTD: -- GFPU: --<br>STPU: -- GFD: --<br>STD: -- |                                                          |        |       |
| DESCRIPTION:<br>NON-ESSENTIAL MCC |                    |                                     | LOCATION:<br>ELECTRICAL ROOM – CHLORINE BUILDING |                              |                                                                                         |              |               |                          |                                                                                                  |                                                          |        |       |
| UNIT<br>LOC'N                     | LOAD               |                                     | MOTOR LOAD                                       |                              | NON-MOTOR LOAD                                                                          |              | STARTER       |                          |                                                                                                  | CIRCUIT PROTECTION                                       |        | NOTES |
|                                   | ID                 | DESCRIPTION                         | HP                                               | KW<br>FLA                    | KW<br>KVA                                                                               | NEMA SIZE    | TYPE          | OVERLOAD                 | RATING                                                                                           | TYPE                                                     |        |       |
| 1A                                | MAIN INCOMING LUGS | FROM MCC-M720                       |                                                  | 5.6                          |                                                                                         |              |               |                          |                                                                                                  |                                                          |        |       |
| 1C                                | ESL-C7101          | VOLTAGE MONITORING RELAY            |                                                  |                              |                                                                                         |              |               |                          |                                                                                                  |                                                          |        |       |
| 1G                                | HOIST              | MOTORIZED HOIST                     | 7.5                                              | --                           |                                                                                         |              |               |                          |                                                                                                  | 30A                                                      | TM, 3P |       |
| 1I                                | C1                 | TANK ROOM CONVECTION HEATER         |                                                  |                              | 5                                                                                       |              | 1             |                          |                                                                                                  | 15A                                                      | TM, 3P |       |
| 1M                                | C2                 | TANK ROOM CONVECTION HEATER         |                                                  |                              | 5                                                                                       |              | 1             |                          |                                                                                                  | 15A                                                      | TM, 3P |       |
| 1Q                                | C3                 | TANK ROOM CONVECTION HEATER         |                                                  |                              | 5                                                                                       |              | 1             |                          |                                                                                                  | 15A                                                      | TM, 3P |       |
| 1U                                | C6                 | EQUIPMENT ROOM CONVECTION HEATER    |                                                  |                              | 5                                                                                       |              | 1             |                          |                                                                                                  | 15A                                                      | TM, 3P |       |
| 2A                                | SPARE              | SPARE                               |                                                  |                              |                                                                                         |              |               |                          |                                                                                                  | 15A                                                      | TM, 3P |       |
| 2E                                | XFMR-C711          | PNL-C711 TRANSFORMER                |                                                  |                              |                                                                                         |              |               |                          |                                                                                                  | 40A                                                      | TM, 3P |       |
| 2G                                | AHU-C601           | MAKE-UP AIR UNIT 1                  | 119                                              | 114.5                        |                                                                                         |              |               |                          |                                                                                                  | 150A                                                     | TM, 3P |       |
| 2I                                | XFMR-C670          | XFMR-C670 (SCBR-C670)               | 40                                               | 52                           |                                                                                         |              |               |                          |                                                                                                  | 90A                                                      | TM, 3P |       |
| 2K                                | AHU-C602           | MAKE-UP AIR UNIT 2                  | 35                                               | 33.7                         |                                                                                         |              |               |                          |                                                                                                  | 45A                                                      | TM, 3P |       |
| 2M                                | U-C534             | TANKLESS WATER HEATER               |                                                  |                              | 102                                                                                     |              |               |                          |                                                                                                  | 125A                                                     | TM, 3P |       |
| 2O                                | OD-C597            | CL2 ROOM MOTORIZED DOOR             | 3                                                |                              |                                                                                         |              |               |                          |                                                                                                  | 15A                                                      | TM, 3P |       |
| 2S                                | SPACE              |                                     |                                                  |                              |                                                                                         |              |               |                          |                                                                                                  |                                                          |        |       |
| 2U                                | SPACE              |                                     |                                                  |                              |                                                                                         |              |               |                          |                                                                                                  |                                                          |        |       |
| TOTAL CONNECTED LOAD:<br>-- KVA   |                    | TOTAL DEMAND LOAD – SUMMER:<br>--VA | TOTAL DEMAND LOAD – WINTER:<br>-- KVA            | LEGEND:<br>FVNR<br>TM<br>MMC | FULL VOLTAGE NON-REVERSING<br>THERMAL MAGNETIC<br>MOTOR MANAGEMENT CONTROLLER (TESYS T) |              |               |                          | MCP<br>3P<br>MCS                                                                                 | MOTOR CIRCUIT PROTECTOR<br>3 POLE<br>MOULDED CASE SWITCH |        |       |

MCC-C710 SCHEDULE  
SCALE: NTS

|                               |                    |                                        |                                                  |                 |              |                |               |                          |                                                                                                            |          |                    |        |       |
|-------------------------------|--------------------|----------------------------------------|--------------------------------------------------|-----------------|--------------|----------------|---------------|--------------------------|------------------------------------------------------------------------------------------------------------|----------|--------------------|--------|-------|
| EQUIPMENT ID:<br>MCC--C720E   |                    |                                        | VOLTS:<br>600V                                   | RATING:<br>600A | PHASE:<br>3P | WIRE:<br>3 W   | MAIN BREAKER: | MAIN BREAKER TYPE:<br>-- | MAIN BREAKER SETTINGS:<br>LTPU: 600A    INST: -<br>LTD: -        GFPU: -<br>STPU: -       GFD: -<br>STD: - |          |                    |        |       |
| DESCRIPTION:<br>ESSENTIAL MCC |                    |                                        | LOCATION:<br>ELECTRICAL ROOM - CHLORINE BUILDING |                 |              |                |               |                          |                                                                                                            |          |                    |        |       |
| LOAD                          |                    |                                        |                                                  |                 |              |                |               |                          |                                                                                                            |          |                    |        |       |
| UNIT<br>LOC'N                 | ID                 | DESCRIPTION                            | MOTOR LOAD                                       |                 |              | NON-MOTOR LOAD |               | STARTER                  |                                                                                                            |          | CIRCUIT PROTECTION |        | NOTES |
|                               |                    |                                        | HP                                               | KW              | FLA          | KW             | KVA           | NEMA SIZE                | TYPE                                                                                                       | OVERLOAD | RATING             | TYPE   |       |
| 3A                            | MAIN INCOMING LUGS | FROM MCC-M730E                         |                                                  |                 |              |                |               |                          |                                                                                                            |          |                    |        |       |
| 3C                            | ESL-C7201          | VOLTAGE MONITORING RELAY               |                                                  |                 |              |                |               |                          |                                                                                                            |          |                    |        |       |
| 3G                            | XFMR-C731E         | PNL-C731E TRANSFORMER                  |                                                  |                 |              |                | 15            |                          |                                                                                                            |          | 15A                | TM, 3P |       |
| 3I                            | SPACE              |                                        |                                                  |                 |              |                |               |                          |                                                                                                            |          |                    |        |       |
| 3K                            | SPACE              |                                        |                                                  |                 |              |                |               |                          |                                                                                                            |          |                    |        |       |
| 3M                            | C4                 | TANK ROOM CONVECTION HEATER            |                                                  |                 |              | 5              |               | 1                        |                                                                                                            |          | 15A                | TM, 3P |       |
| 3Q                            | C5                 | EQUIPMENT ROOM CONVECTION HEATER       |                                                  |                 |              | 5              |               | 1                        |                                                                                                            |          | 15A                | TM, 3P |       |
| 3U                            | HCE-C620           | CHLORINATOR EQUIPMENT ROOM VENT HEATER |                                                  |                 |              | 9              |               |                          |                                                                                                            |          | 15A                | TM, 3P |       |
|                               |                    |                                        |                                                  |                 |              |                |               |                          |                                                                                                            |          |                    |        |       |
|                               |                    |                                        |                                                  |                 |              |                |               |                          |                                                                                                            |          |                    |        |       |
MCC-C720E SCHEDULE  
SCALE: NTS

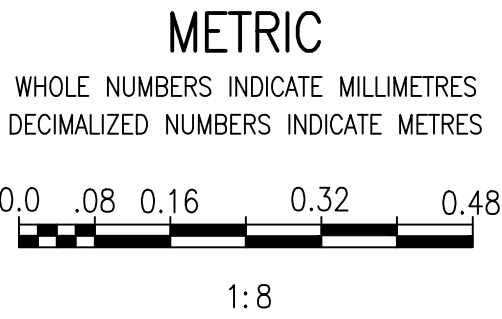

|                                       |  |  |  |  |  |                                                                                                                                                                 |  |                                         |  |                                                                                                                                                                                                                                                                                                                                          |  |  |  |
|---------------------------------------|--|--|--|--|--|-----------------------------------------------------------------------------------------------------------------------------------------------------------------|--|-----------------------------------------|--|------------------------------------------------------------------------------------------------------------------------------------------------------------------------------------------------------------------------------------------------------------------------------------------------------------------------------------------|--|--|--|
|                                       |  |  |  |  |  | <br>148 Nature Park Way, Winnipeg, Manitoba<br>Canada R3P 0X7 204-786-8080 |  | ENGINEER'S SEAL                         |  |  <b>THE CITY OF WINNIPEG</b><br>WATER AND WASTE DEPARTMENT                                                                                                                                                                                          |  |  |  |
|                                       |  |  |  |  |  |                                                                                                                                                                 |  |                                         |  |                                                                                                                                                                                                                                                                                                                                          |  |  |  |
|                                       |  |  |  |  |  | DESIGNED BY:<br>S. BOGHOSIAN                                                                                                                                    |  | CHECKED BY:<br>K. SAPIAK                |  | <div>MCPHILLIPS PUMPING STATION</div> <div>ELECTRICAL AND HVAC UPGRADES, MCC REPLACEMENT</div> <div>ELECTRICAL PANEL LAYOUT</div> <div>CHLORINE BUILDING</div> <div>MCC-C710/MCC-C720E LAYOUT AND SCHEDULE</div> <div>CITY DRAWING NUMBER<br/>1-0640C-E0004</div> <div>SHEET<br/>001</div> <div>REV.<br/>03</div> <div>SIZE<br/>A1</div> |  |  |  |
|                                       |  |  |  |  |  | DRAWN BY:<br>S. BOGHOSIAN                                                                                                                                       |  | APPROVED BY:<br>D. BECKER               |  |                                                                                                                                                                                                                                                                                                                                          |  |  |  |
|                                       |  |  |  |  |  | SCALE:<br>AS SHOWN                                                                                                                                              |  | ISSUED FOR CONSTRUCTION<br>BY: A. WEISS |  |                                                                                                                                                                                                                                                                                                                                          |  |  |  |
| 03 ISSUED FOR TENDER AND CONSTRUCTION |  |  |  |  |  | 2025/04/30                                                                                                                                                      |  | VE' VE'                                 |  |                                                                                                                                                                                                                                                                                                                                          |  |  |  |
| 02 AS-BUILT - 1070-2019 TENDER        |  |  |  |  |  | 2023/03/17                                                                                                                                                      |  | - VE'                                   |  |                                                                                                                                                                                                                                                                                                                                          |  |  |  |
| 01 MCC LAYOUT MODIFICATION            |  |  |  |  |  | 2020/06/08                                                                                                                                                      |  | CD VE'                                  |  |                                                                                                                                                                                                                                                                                                                                          |  |  |  |
| 00 ISSUED FOR TENDER AND CONSTRUCTION |  |  |  |  |  | 2019/10/18                                                                                                                                                      |  | SB KS'                                  |  |                                                                                                                                                                                                                                                                                                                                          |  |  |  |
| NO. REVISIONS                         |  |  |  |  |  | DATE                                                                                                                                                            |  | DESIGN                                  |  | CHECK                                                                                                                                                                                                                                                                                                                                    |  |  |  |