


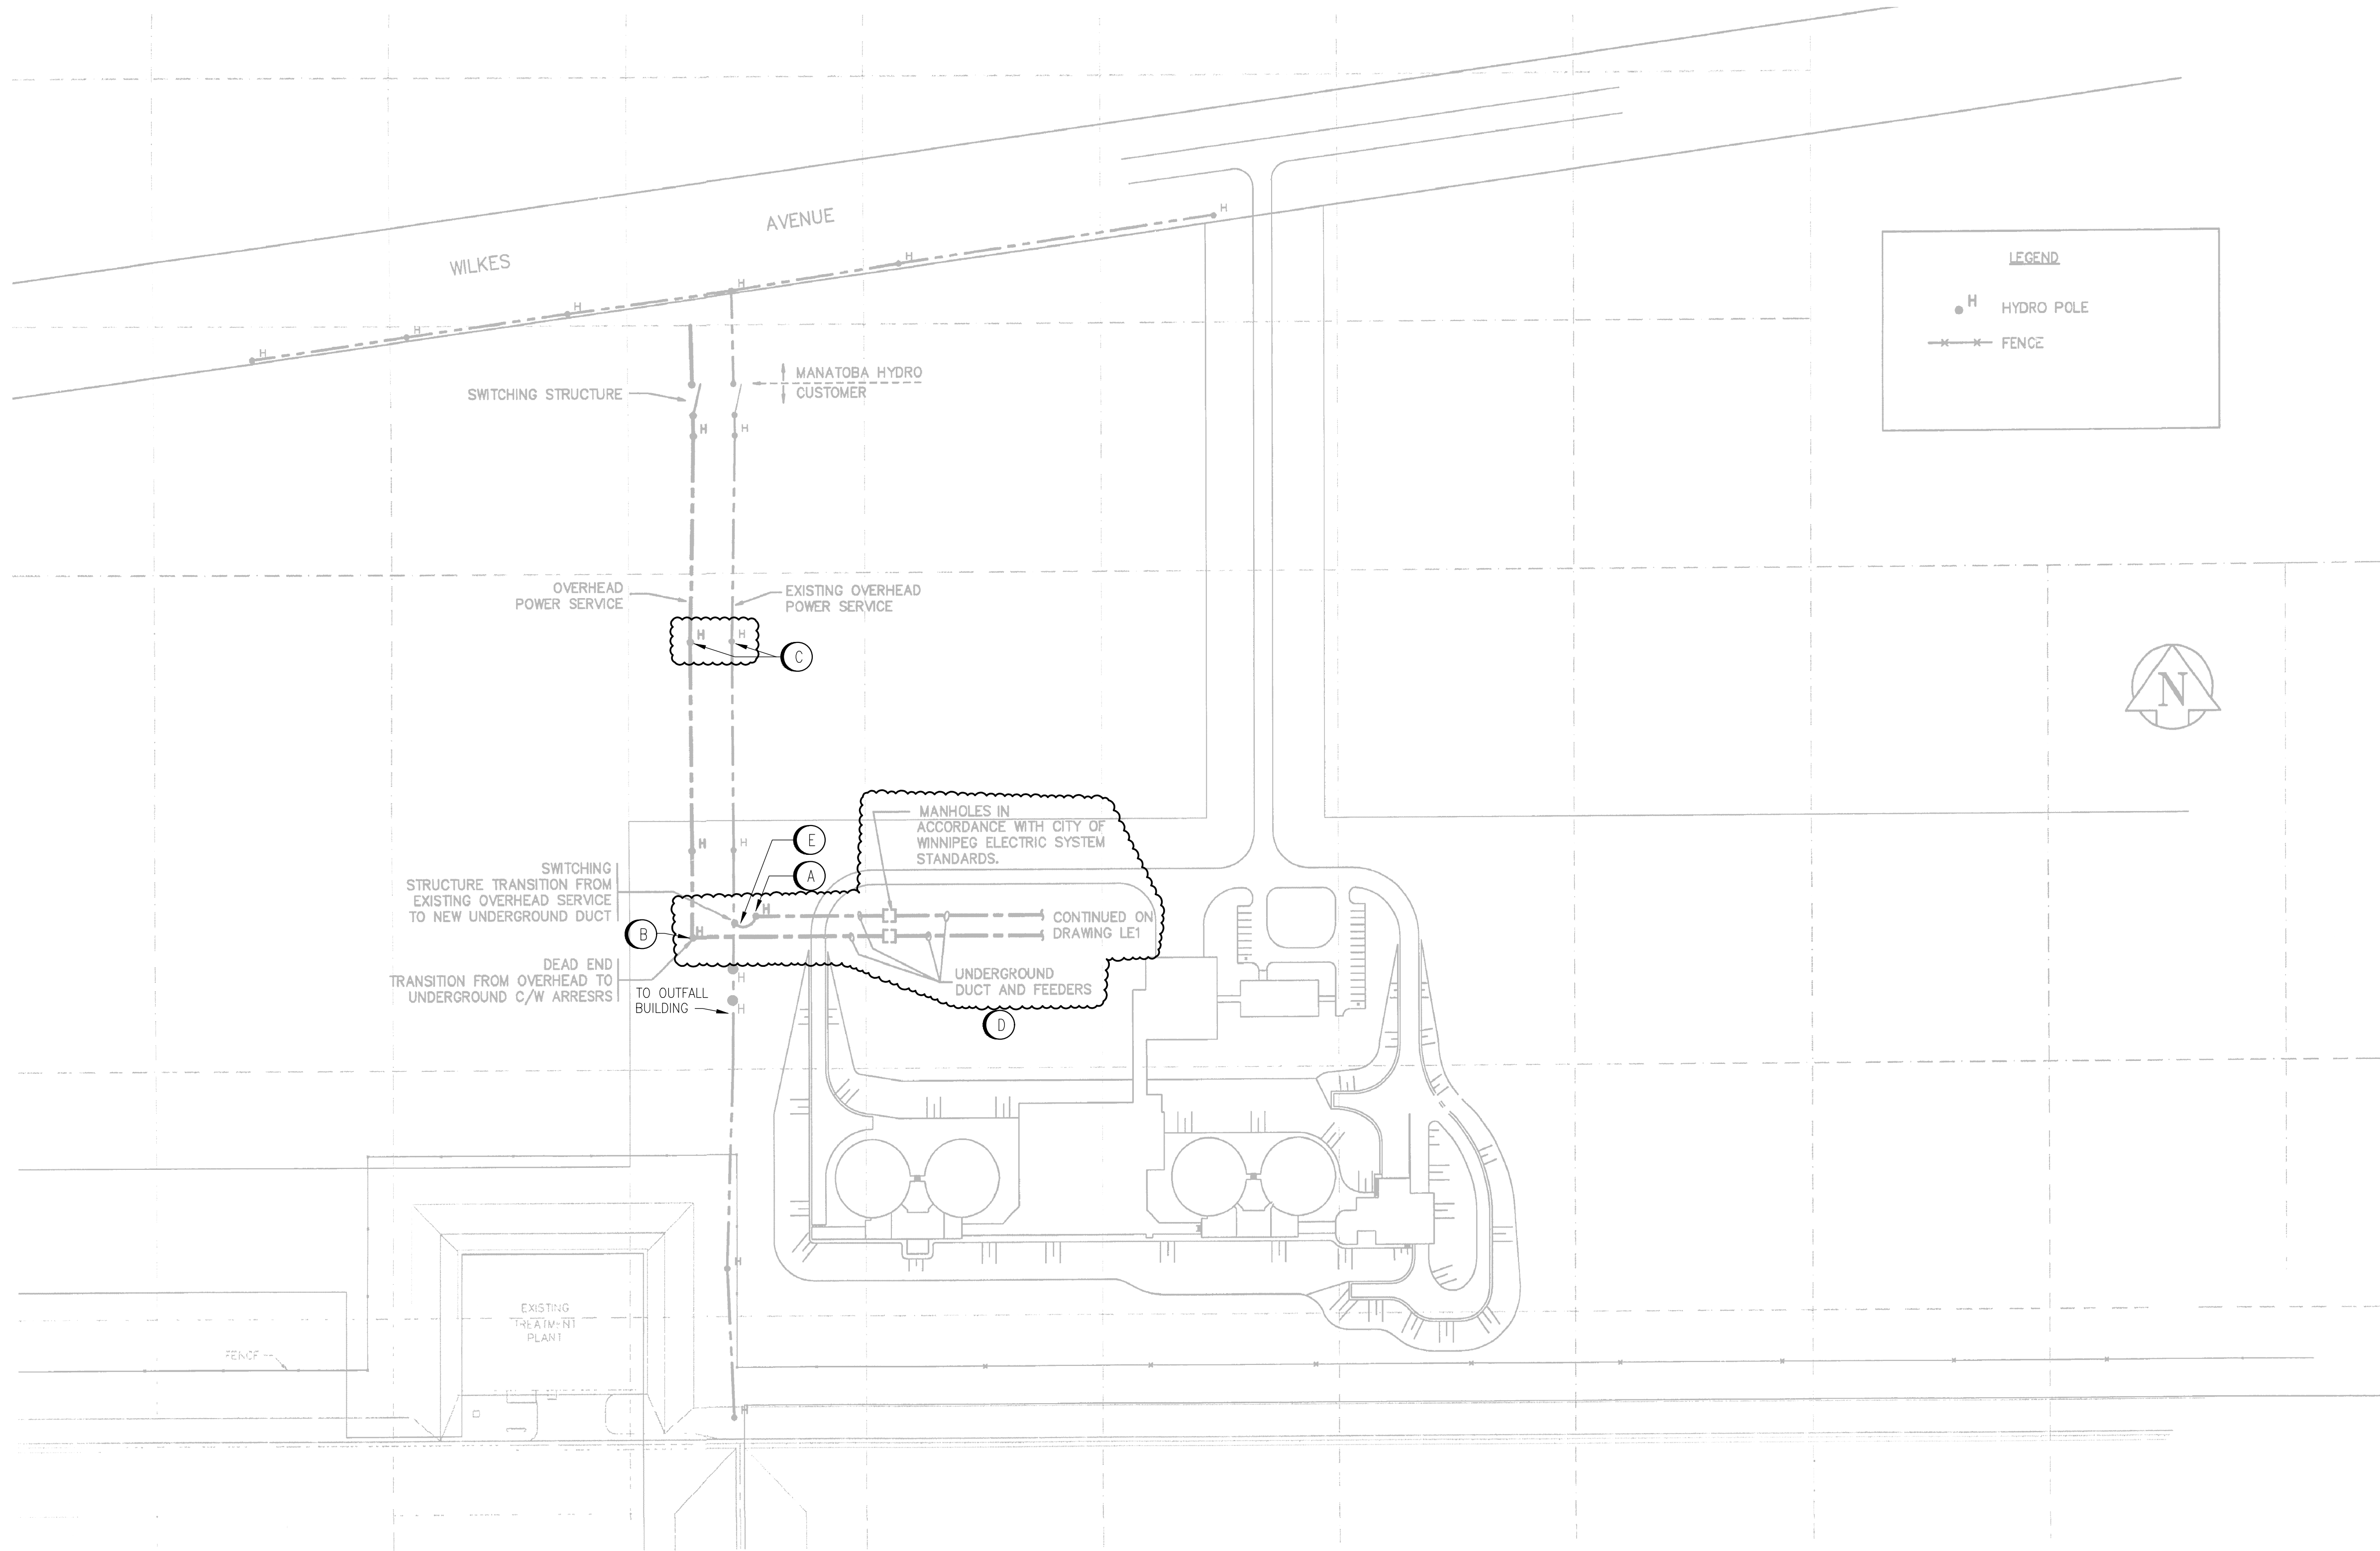

GENERAL NOTES:

1. CLOUDED PORTION OF THIS DRAWING INDICATES WORK TO BE COMPLETED. REFER TO DEMOLITION NOTES.
2. EXISTING CONDITIONS SHOWN ARE BASED ON RECORD DRAWINGS AND INFORMATION PROVIDED BY CITY OF WINNIPEG. INFORMATION IS FOR REFERENCE ONLY AND MAY NOT BE COMPLETE OR ACCURATE. CONTRACTOR SHALL VERIFY ALL DIMENSIONS, RATINGS, AND EXISTING CONDITIONS PRIOR TO TENDER AND MAKE ALLOWANCES AS REQUIRED.

DEMOLITION NOTES:

- A DISCONNECT AND REMOVE EXISTING 15KV GANG OPERATED SWITCH AND FUSES, INCLUDING ALL ASSOCIATED MOUNTING SUPPORTS.
- B DISCONNECT AND REMOVE EXISTING 15KV POLE MOUNTED FUSES.
- C DISCONNECT AND REMOVE EXISTING 15KV GANG OPERATED SWITCHES. RETAIN CROSSARM FOR RE-USE.
- D DISCONNECT AND REMOVE EXISTING 15KV FEEDERS FROM THE TRANSFORMERS TO POLE MOUNTED FUSES. ABANDON EXISTING MANHOLES AND UNDERGROUND DUCTS.
- E TEMPORARY DISCONNECT 15KV FEEDER ASSOCIATED WITH THE RANNOCK SUBSTATION FEEDER AND 2.5MVA TRANSFORMER AT THE POINT IN WHICH IT BRANCHES OUT OF MAIN OVERHEAD LINES TO MINIMIZE OUTAGES IN THE OUTFALL BUILDING.

DEMOLITION

