


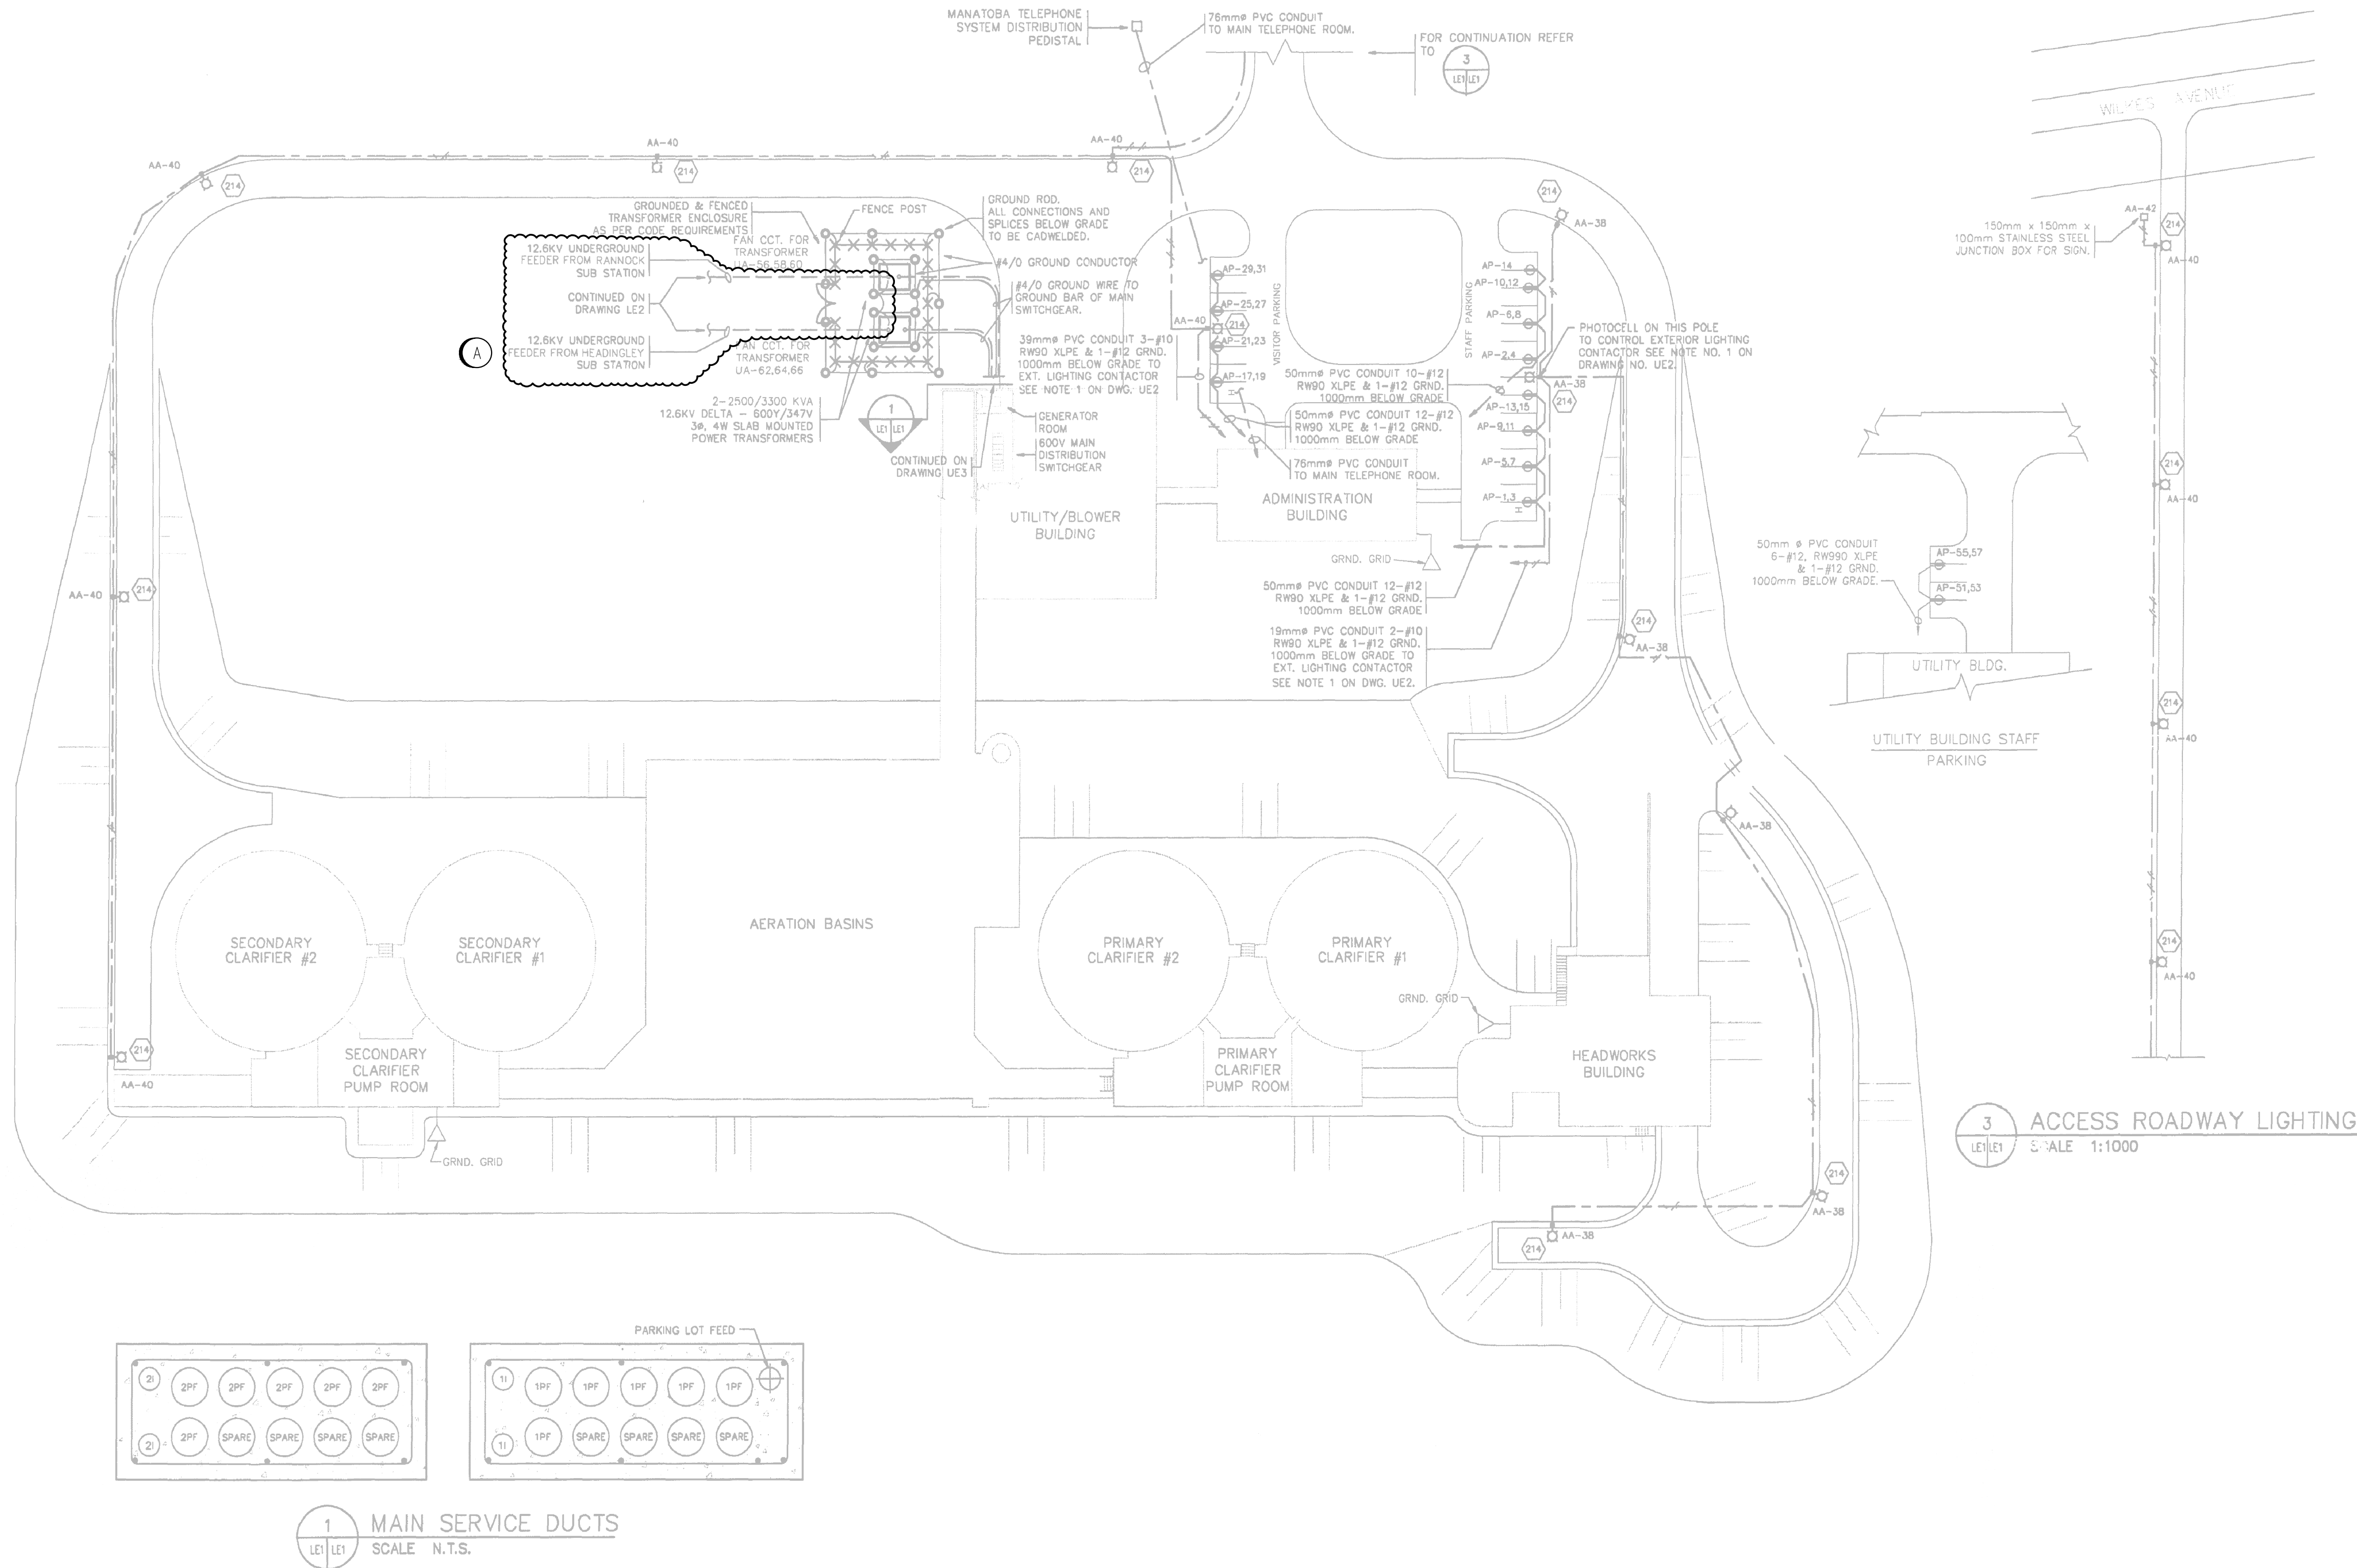

GENERAL NOTES:

1. CLOUED PORTION OF THIS DRAWING INDICATES WORK TO BE COMPLETED. REFER TO DEMOLITION NOTES.
2. EXISTING CONDITIONS SHOWN ARE BASED ON RECORD DRAWINGS AND INFORMATION PROVIDED BY CITY OF WINNIPEG. INFORMATION IS FOR REFERENCE ONLY AND MAY NOT BE COMPLETE OR ACCURATE. CONTRACTOR SHALL VERIFY ALL DIMENSIONS, RATINGS, AND EXISTING CONDITIONS PRIOR TO TENDER AND MAKE ALLOWANCES AS REQUIRED.

DEMOLITION NOTES:

1. DISCONNECT AND REMOVE EXISTING UNDERGROUND FEEDERS BACK TO POLE MOUNTED FUSES. REFER TO DRAWING 1-0103-EGAD-YD01 FOR UPSTREAM POLE LOCATION.

DEMOLITION

**ENGINEERS
GEOSCIENTISTS
MANITOBA**
Certificate of Authorization
AtkinsRéalis Canada Inc.
No. 4489

AtkinsRéalis 148 Nature Park Way, Winnipeg, Manitoba Canada R3P 0X7 204-786-8080				THE CITY OF WINNIPEG WATER AND WASTE DEPARTMENT	
DESIGNED BY: A. ENTZ ARAUJO		CHECKED BY: V. ELIMBAN		 2026-05-04	
DRAWN BY: A. NADRES		APPROVED BY: V. ELIMBAN			
SCALE: 1:500		ISSUED FOR CONSTRUCTION BY: B. SOLOWAY			
DATE: 2026/02/23		DATE: 2026/05/01			
00 ISSUED FOR CONSTRUCTION		2026/05/01		CITY DRAWING NUMBER 1-0103-EGAD-YD02	
NO. REVISIONS		DATE DESIGN CHECK		SHEET REV. SIZE 001 00 A1	