

- REVISIONS AS PER ADDENDUM 1 SUMMARY DOCUMENT
- ISSUED FOR SITE REVIEW FEBRUARY 04, 2004
 - ISSUED FOR 70% REVIEW MARCH 04, 2004
 - ISSUED FOR 90% PRE-TENDER REVIEW APRIL 2004
 - ISSUED FOR TENDER MAY 14, 2004
 - ISSUED FOR ADDENDUM 1 JUNE 16, 2004

REVISIONS AS PER ADDENDUM 1 SUMMARY DOCUMENT

DATE: 05/14/04

SCALE: 1/8" = 1'-0"

Drawings and specifications, as instruments of service are the property of the architect. The copyright in the same being reserved to him. No reproduction may be made without the permission of the architect and when made, must bear his name. Attention is directed to the contractor that the contractor shall verify dimensions and data noted herein with conditions on the site and is held responsible for reporting any discrepancy to the architect for adjustment. This drawing shall not be used for building purposes until counterchecked by:

THE CITY OF WINNIPEG

OFFICE ADDITION AND RENOVATION
 1155 PACIFIC AVENUE
 WINNIPEG, MANITOBA




MAIN FLOOR PLAN PART B **A2.6R1**

CONSTRUCTION - KEYNOTES:
 FOR DRAWINGS A2.5 AND A2.7


SEE DRAWING A2.5 FOR CONTINUATION

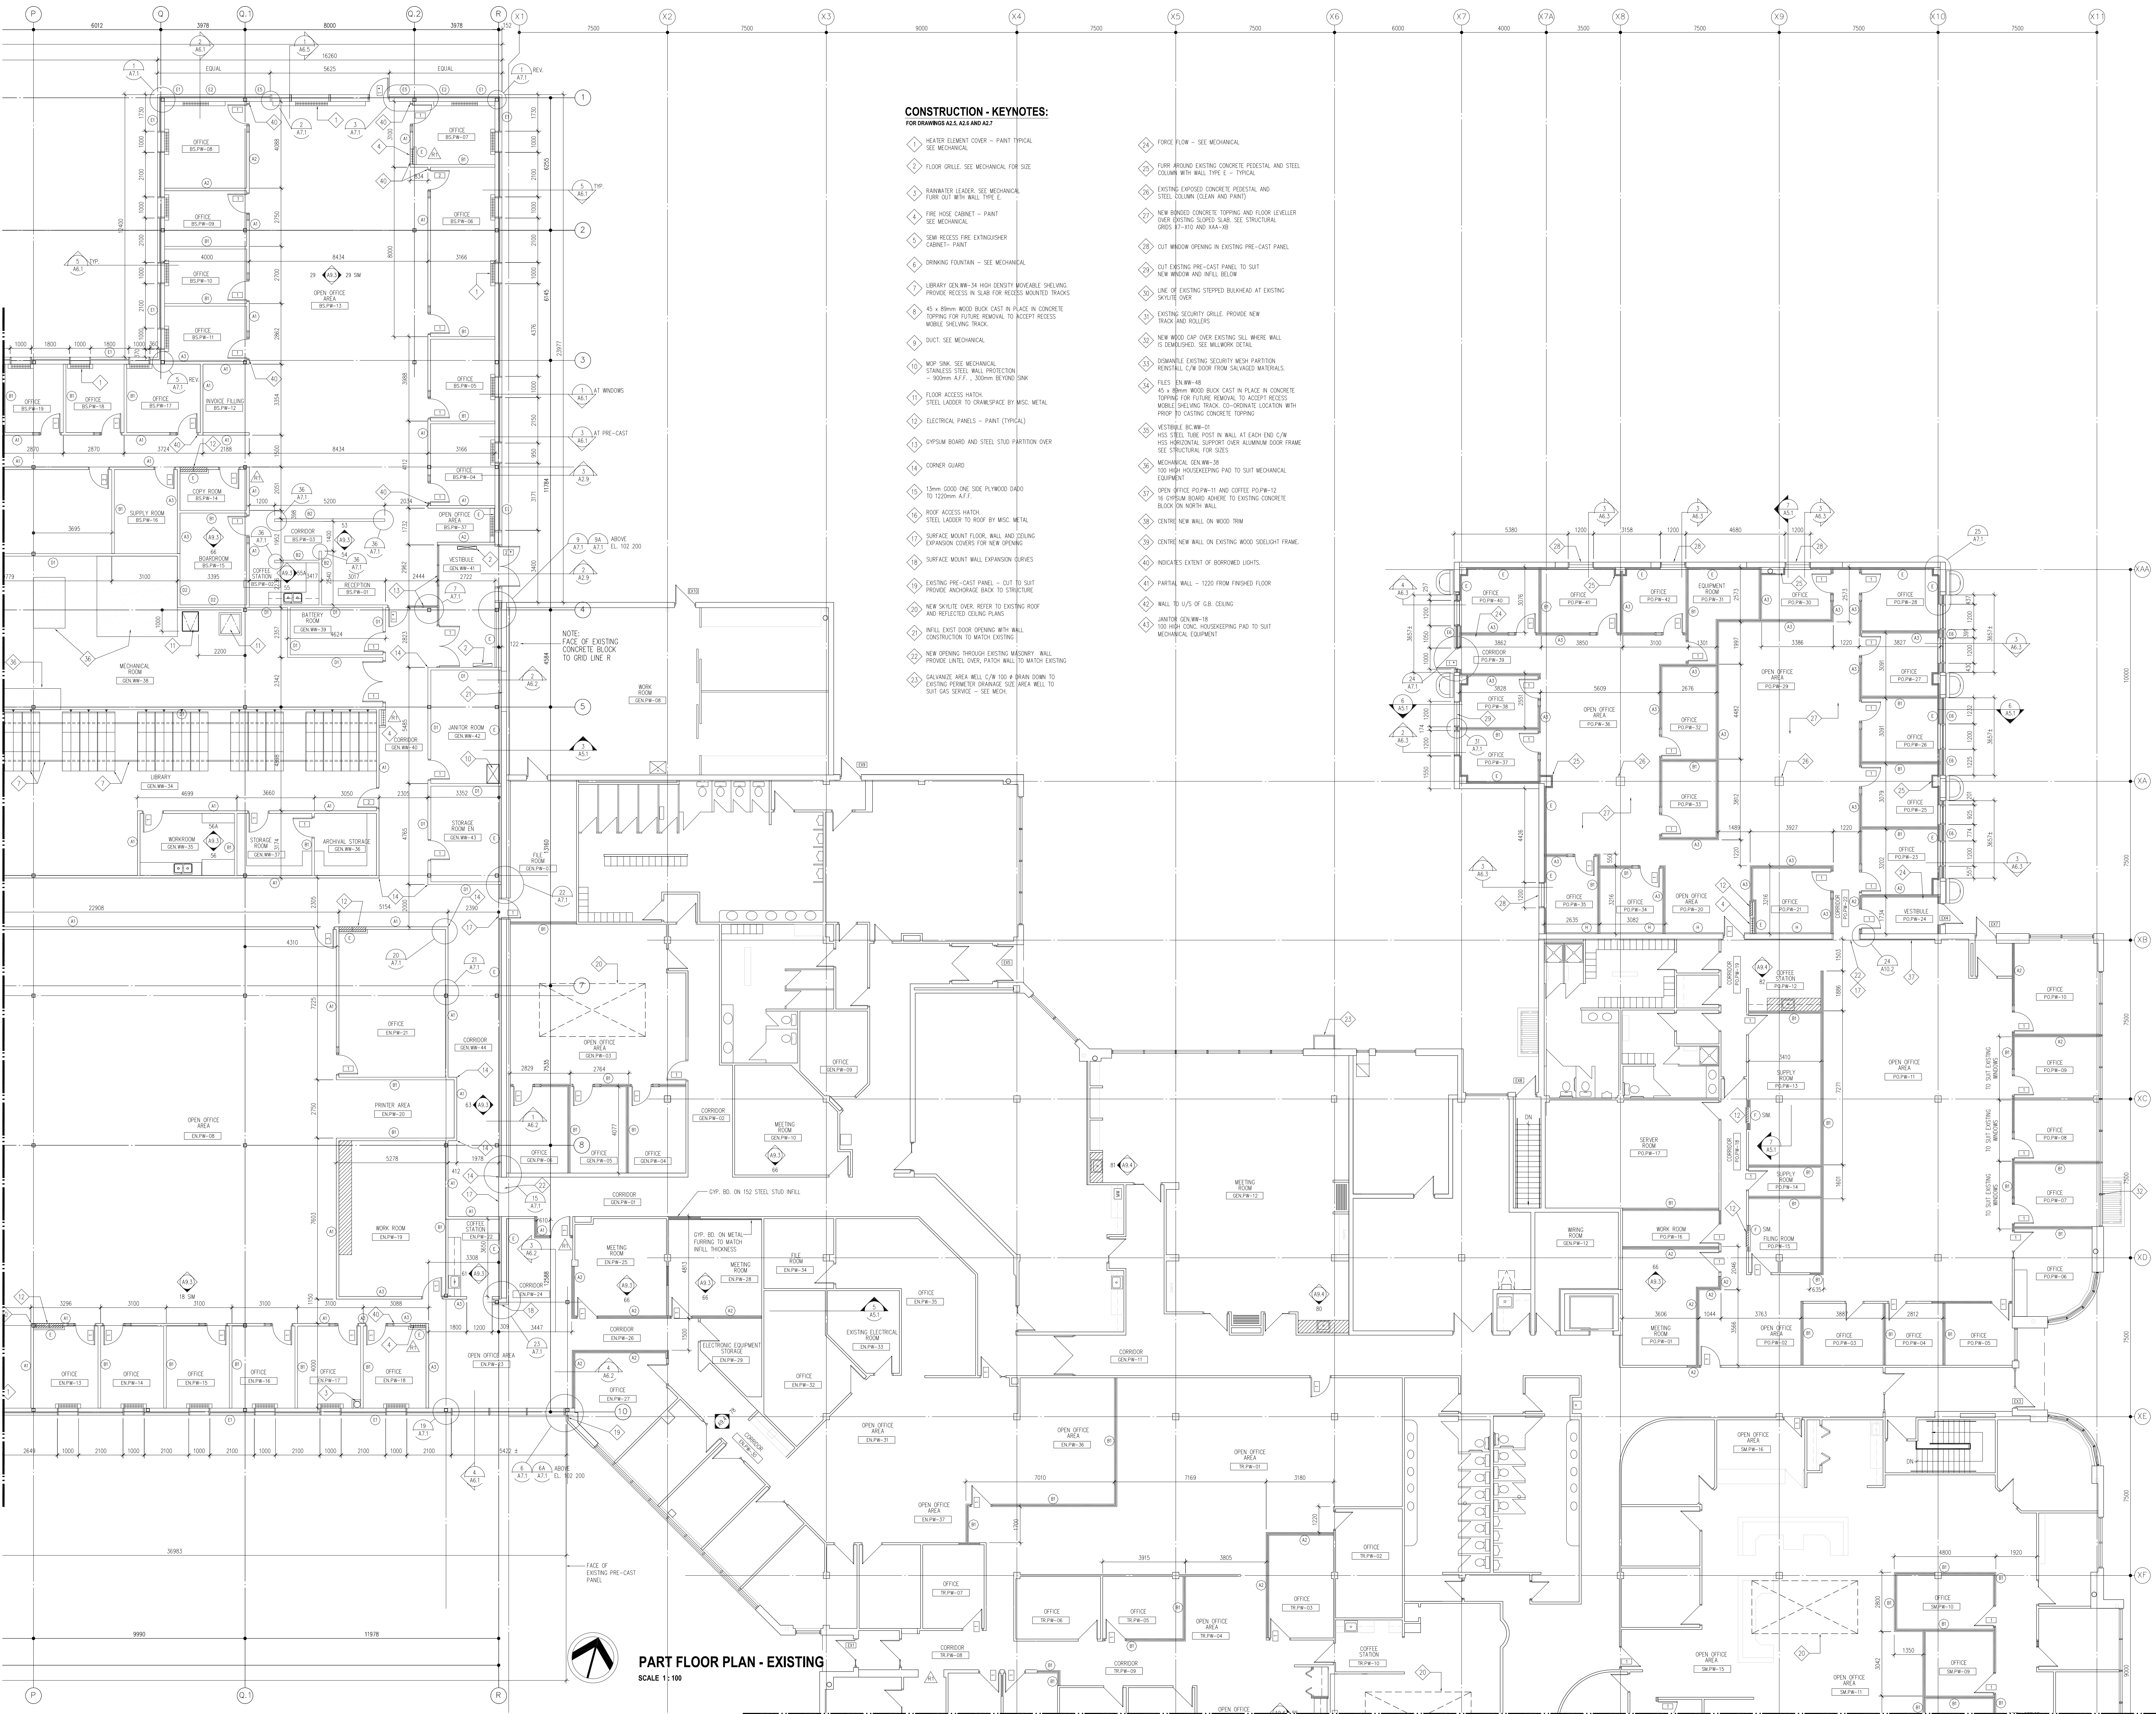

PART FLOOR PLAN - EXISTING
 SCALE 1:100

SEE DRAWING A2.7 FOR CONTINUATION