




SHEET: COW-A1 (03/2005)

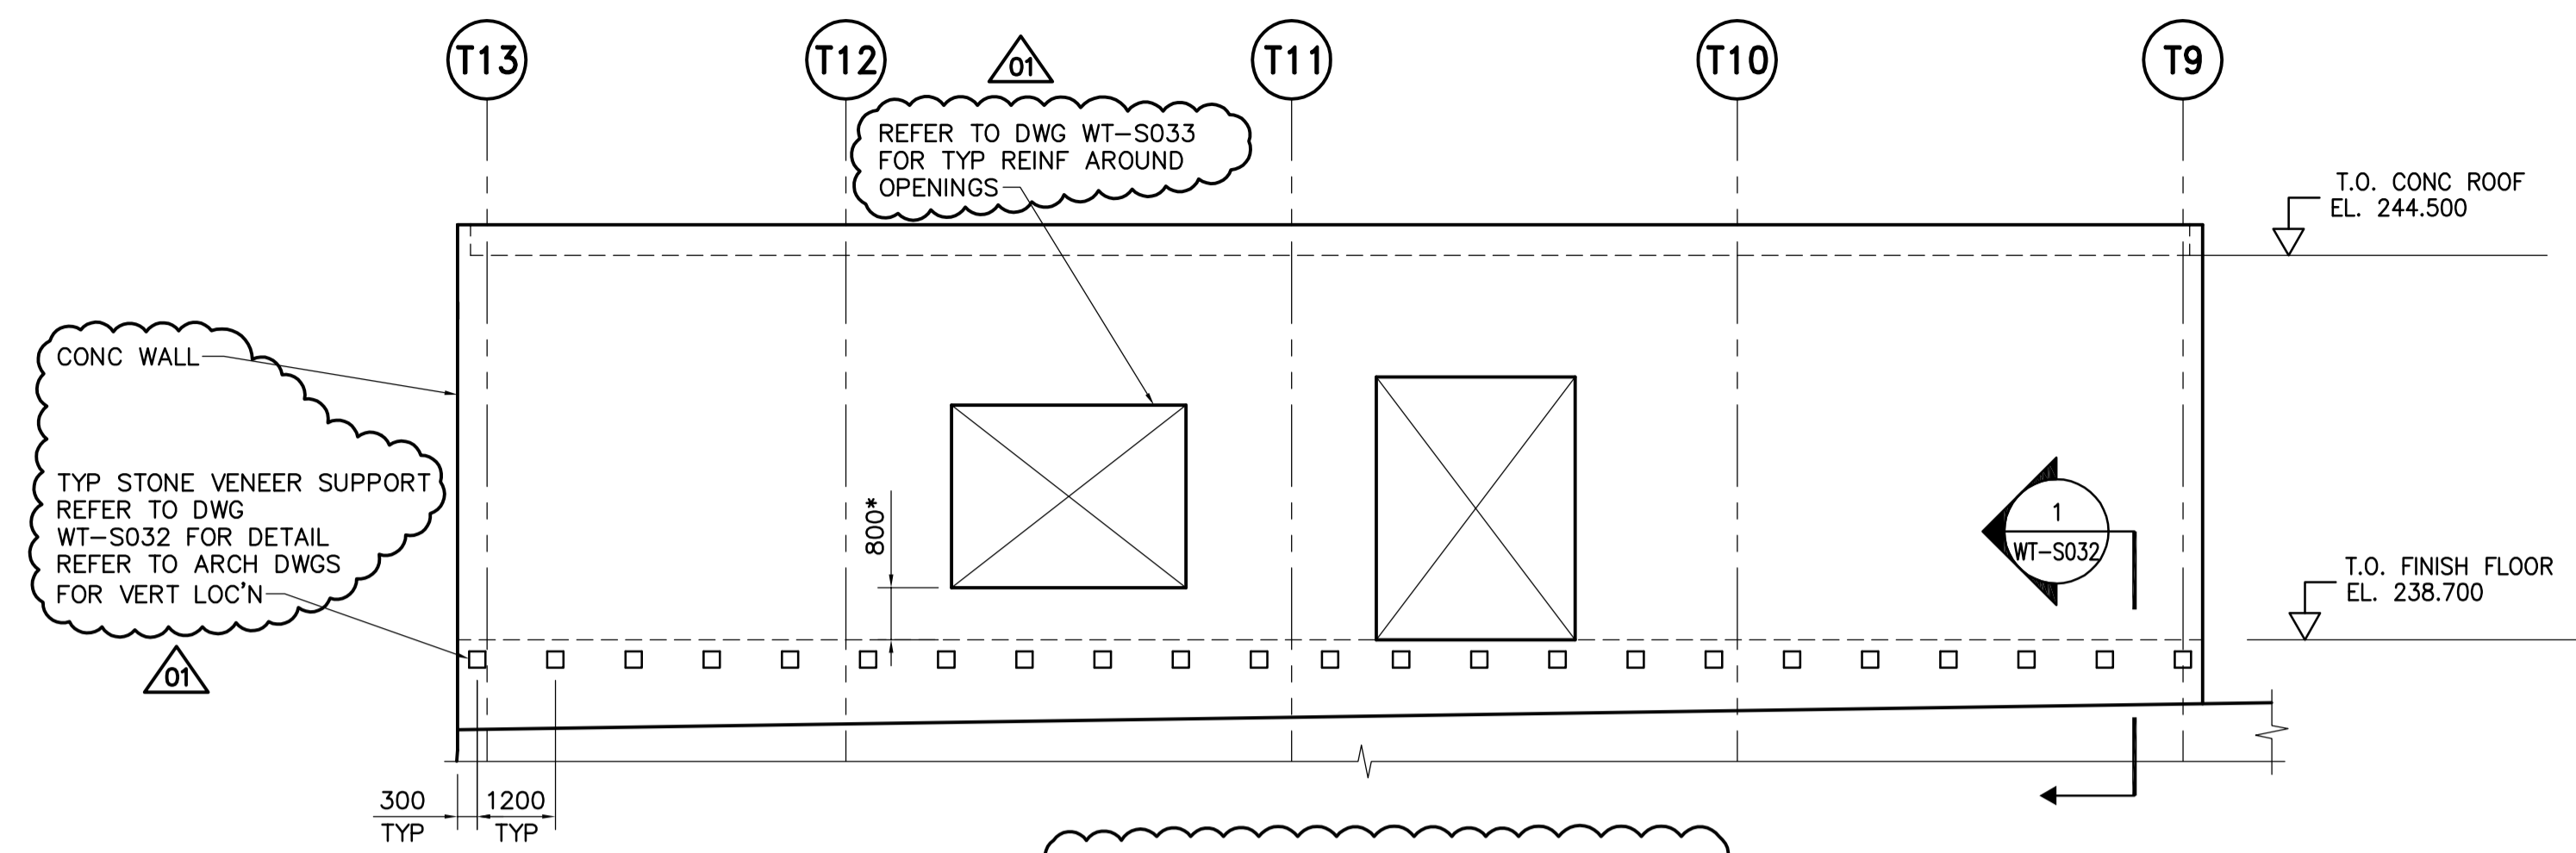


NORTH INLET BUILDING ELEVATION
1:100
* - COORDINATE WITH MECH. & PROCESS
NIC

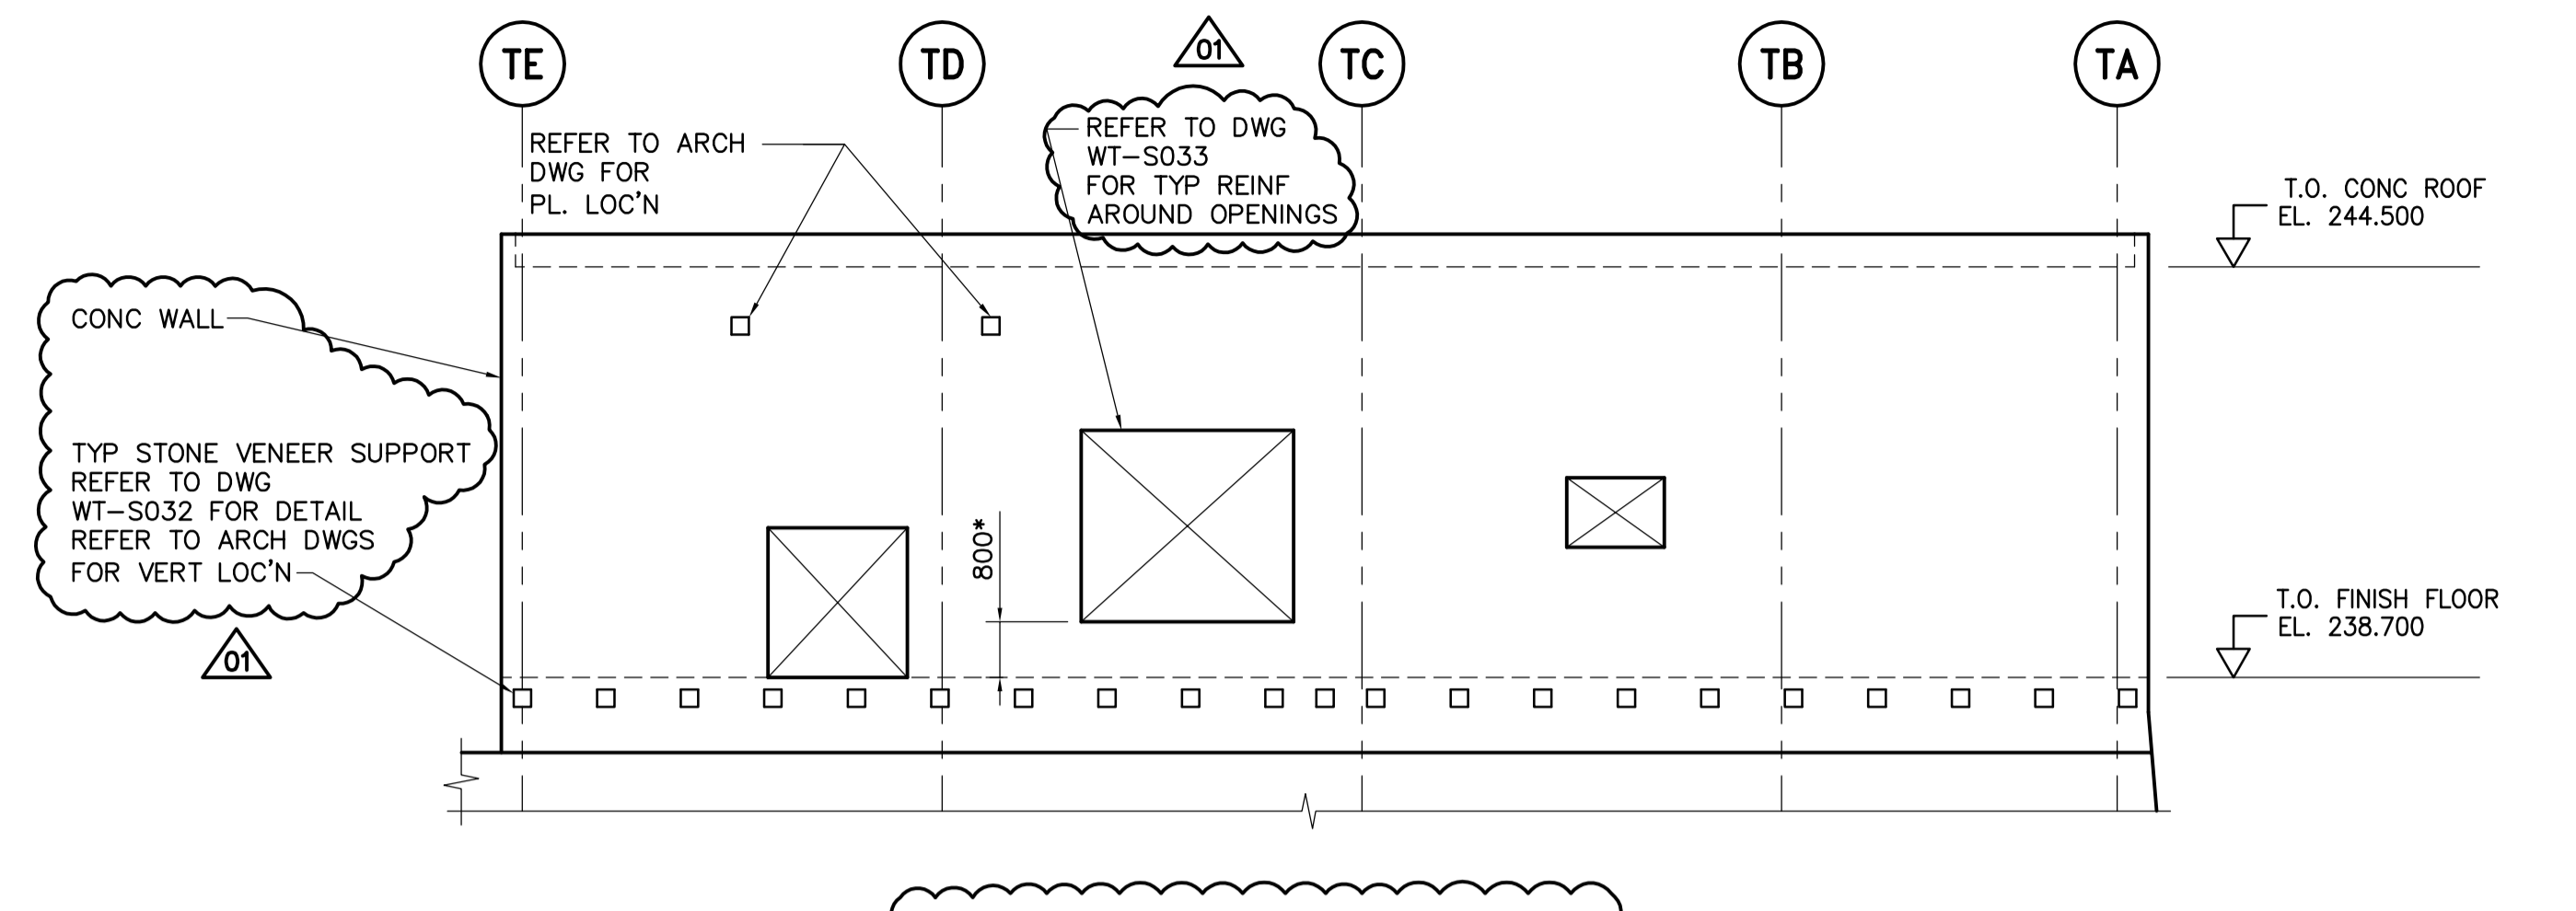


EAST INLET BUILDING ELEVATION
1:100
* - COORDINATE WITH MECH. & PROCESS
NIC

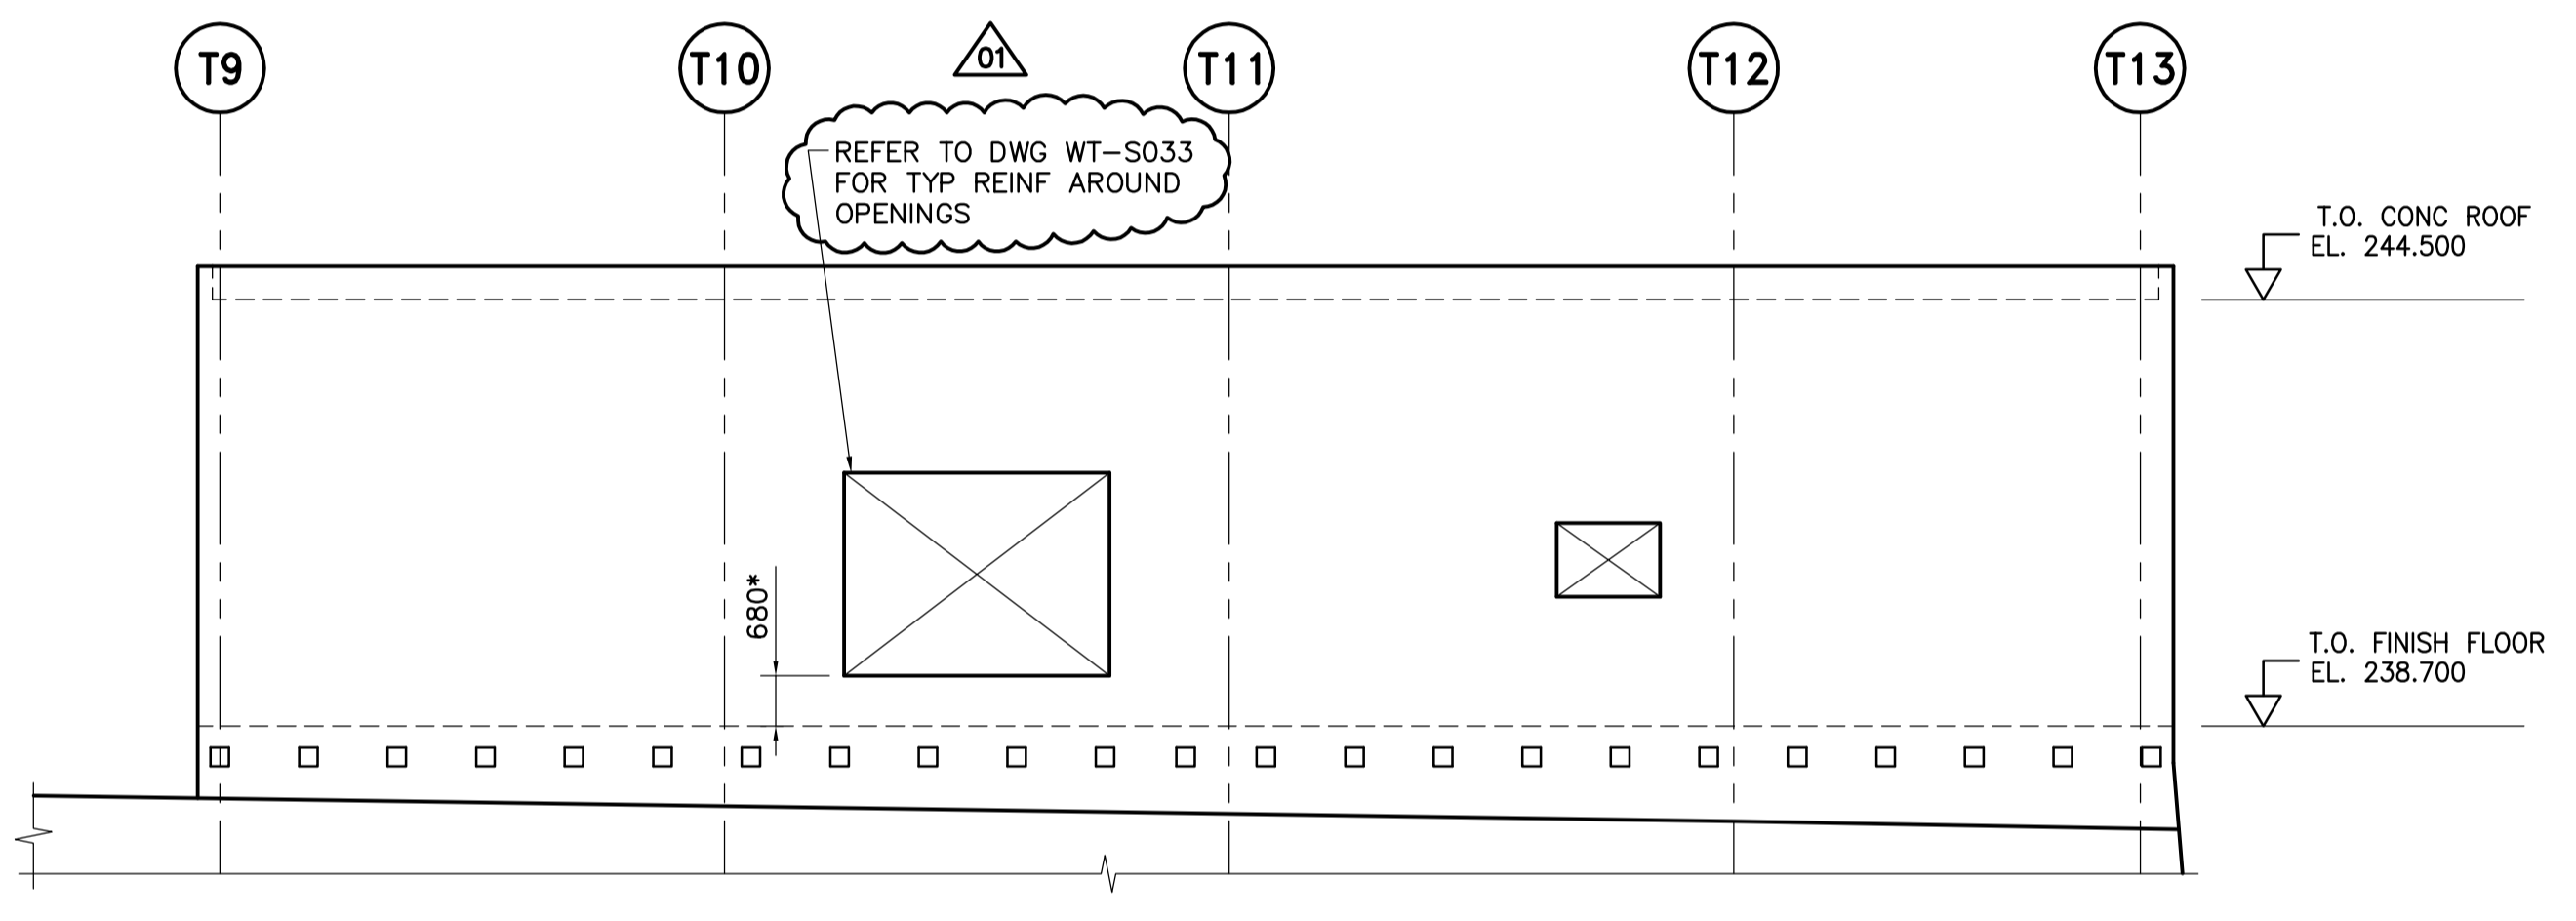


SOUTH INLET BUILDING ELEVATION
1:100
* - COORDINATE WITH MECH. & PROCESS
NIC

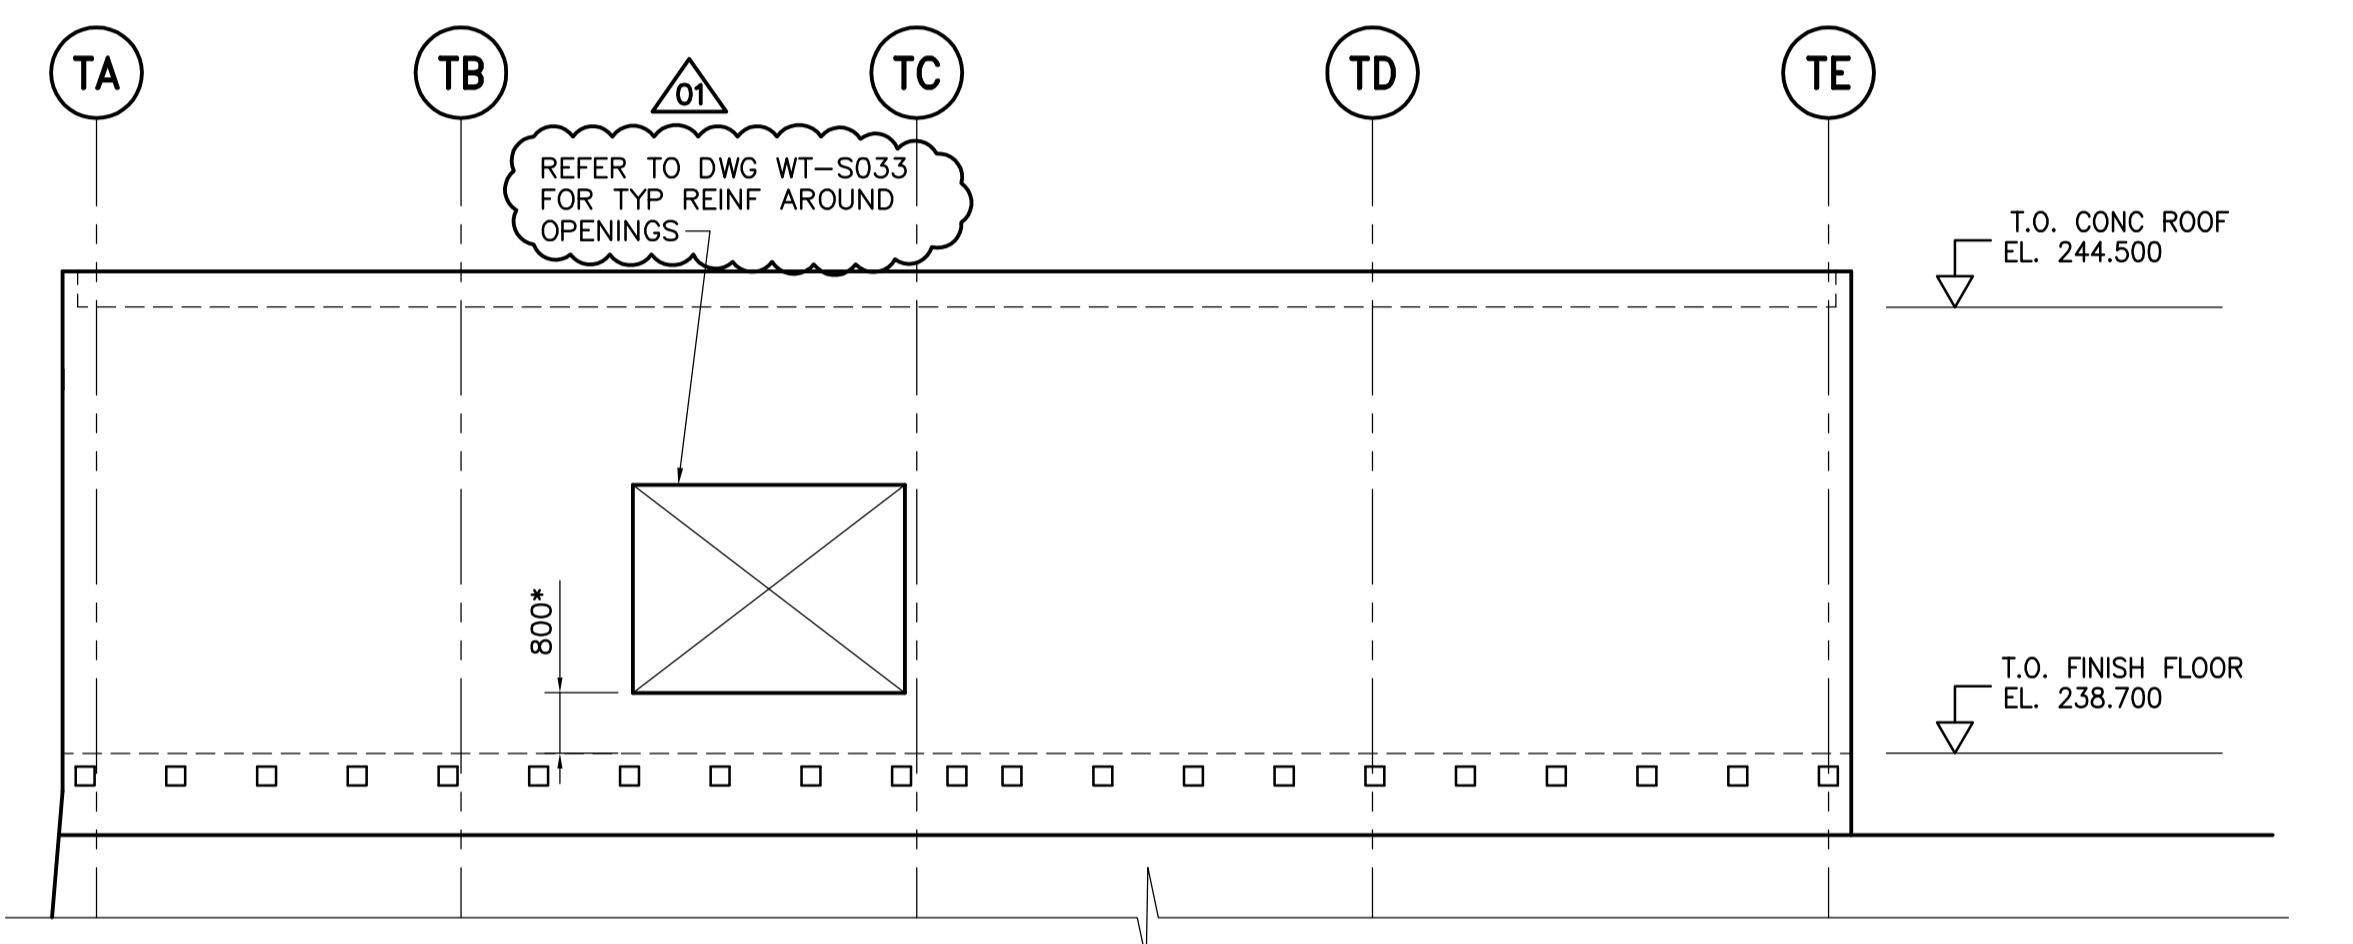

WEST INLET BUILDING ELEVATION
1:100
* - COORDINATE WITH MECH. & PROCESS
NIC

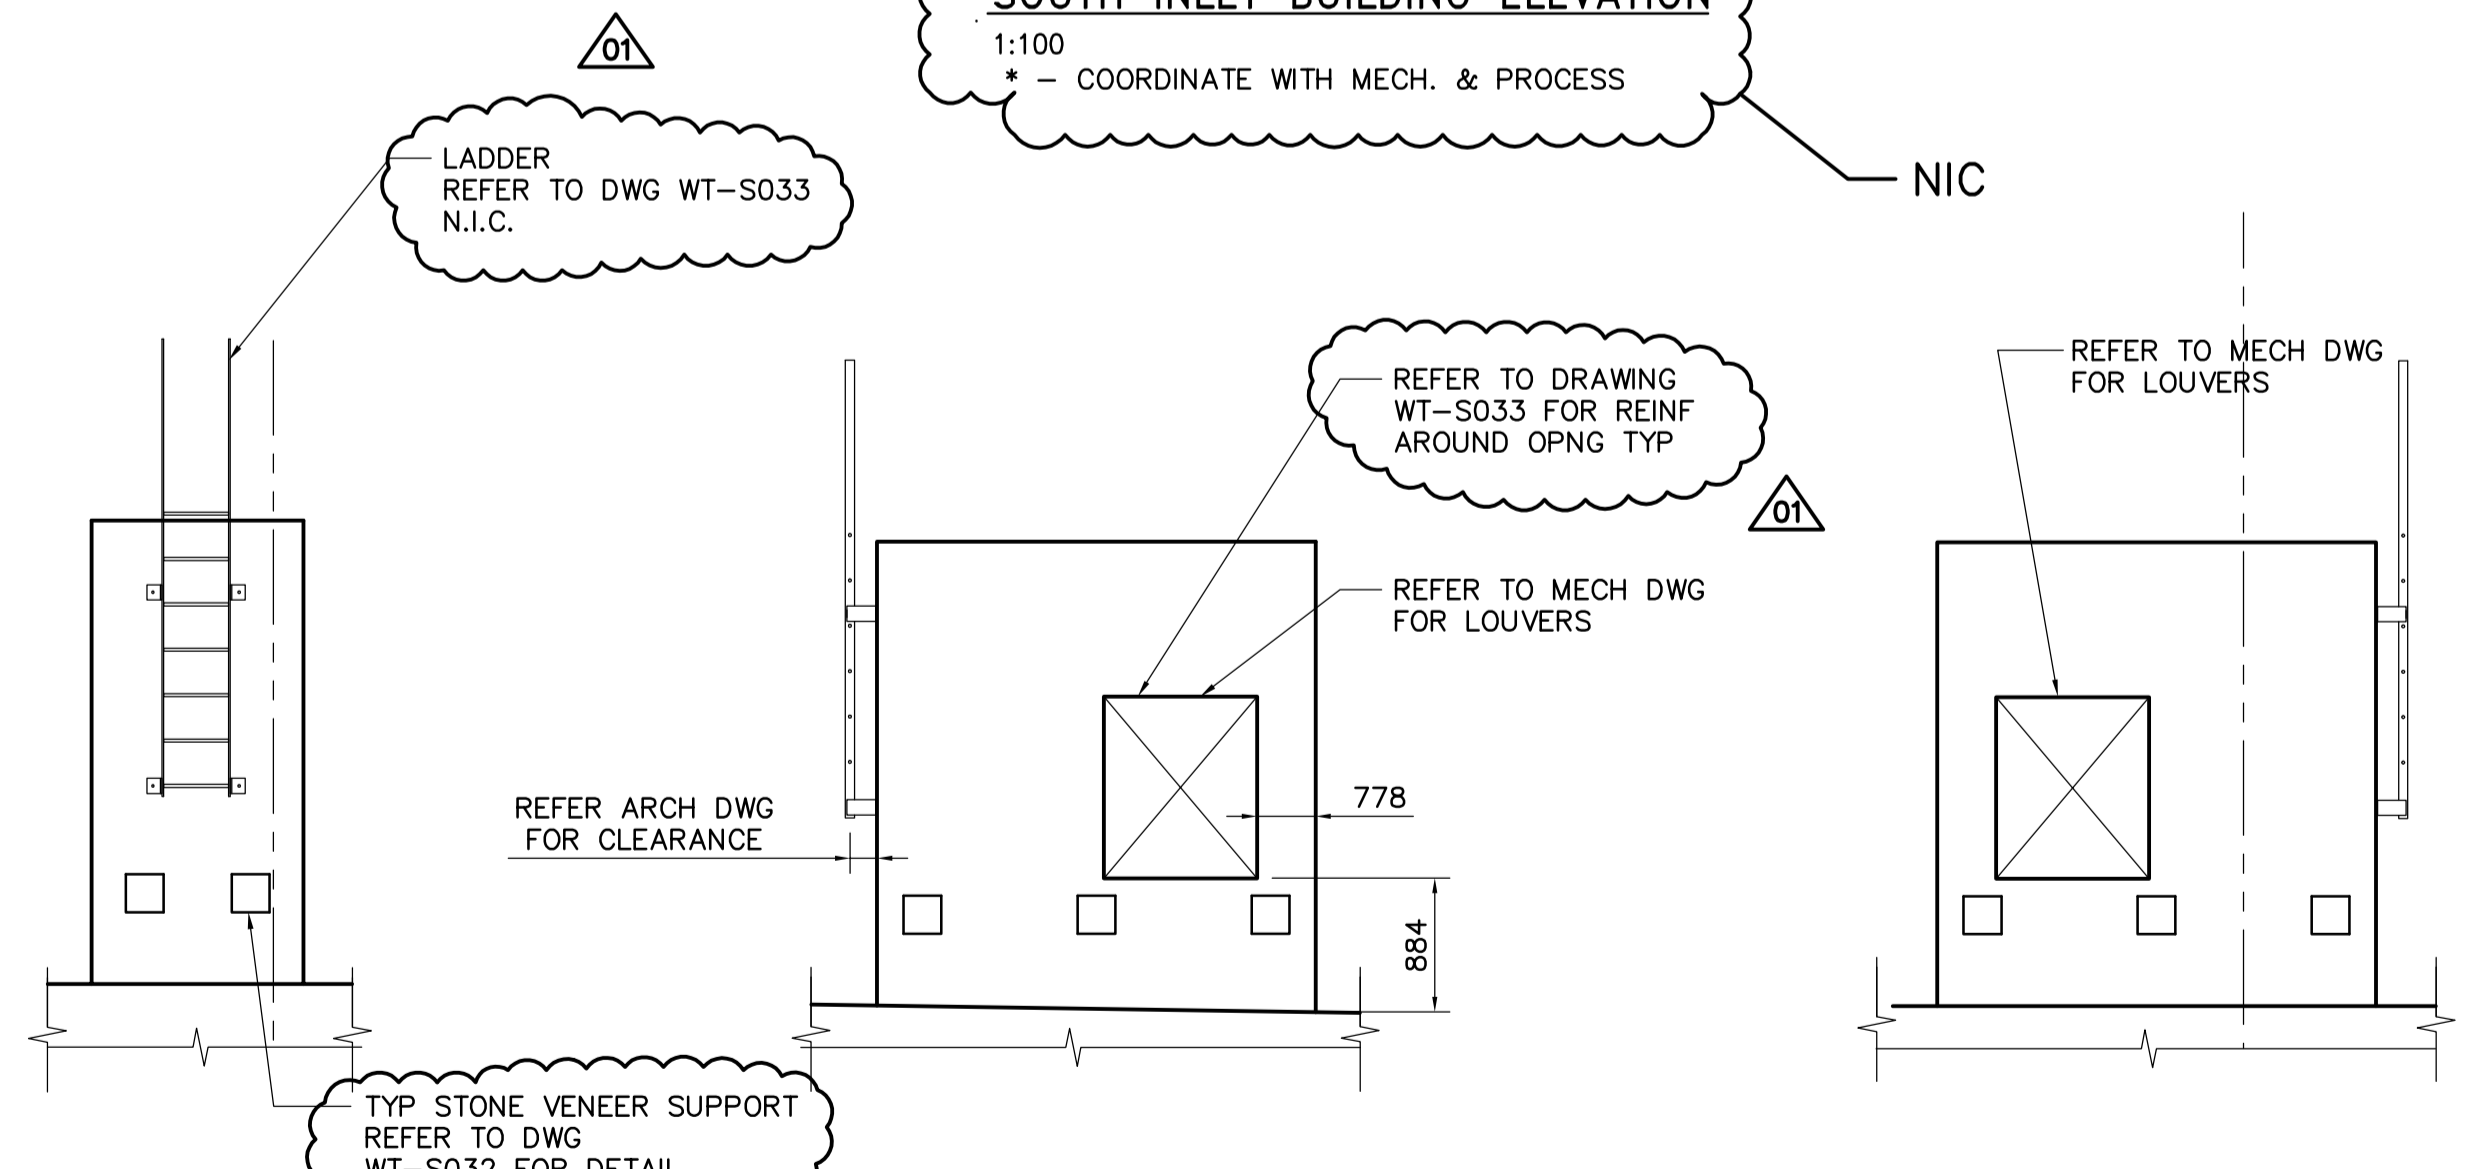

EMERGENCY EXITS/VENT SHAFT ELEVATIONS
1:50
NOTE:
STRUCTURAL IN THIS CONTRACT
FINISHES REFER TO ARCHITECTURAL AND NOT IN THIS CONTRACT

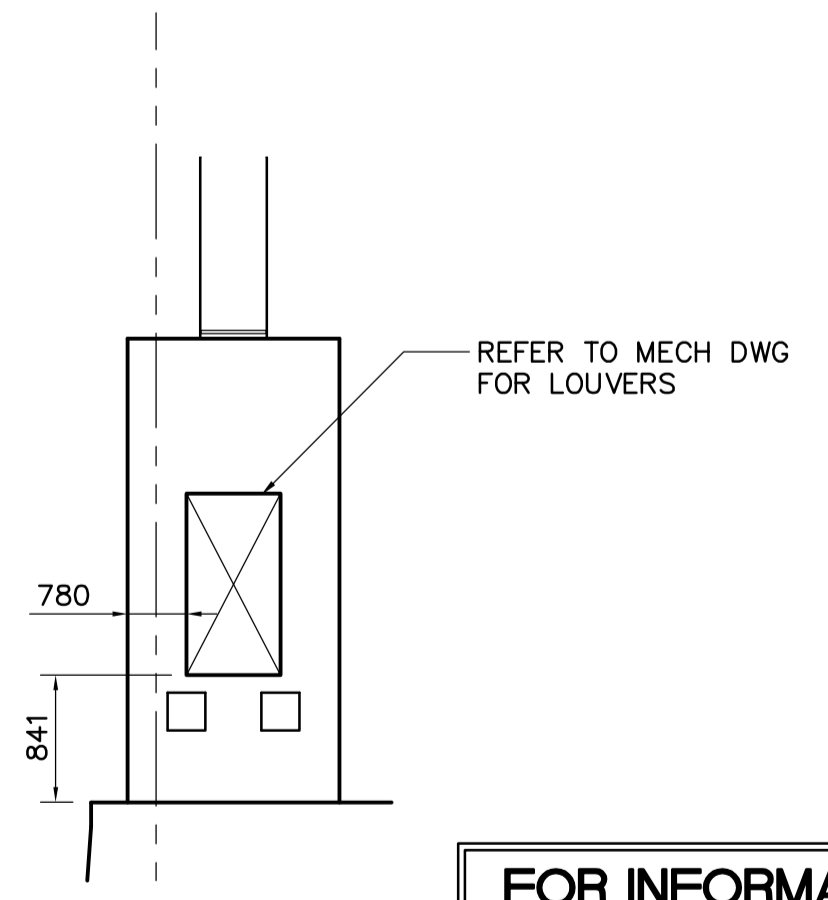

FOR INFORMATION ONLY - NOT IN CONTRACT
(EXCEPT AS NOTED)

DRAWING NOTES:
1. REFER TO ARCHITECTURAL AND MECHANICAL DRAWINGS FOR SIZES AND LOCATIONS OF ALL OPENINGS.

APECA
Certificate of Authorization
Earth Tech Canada Inc.
No. 730 Expiry: April 30, 2006

B.M. ELEV.			
DESIGNED BY	GGP	CHECKED BY	MK
DRAWN BY	HYC, C.T.	APPROVED BY	AHL
HOR. SCALE:	AS NOTED	RELEASED FOR CONSTRUCTION BY:	R. SOROKOWSKI
VERTICAL SCALE:		DATE	2005-04-17
NO.	REVISIONS	DATE	BY
01	166-2005 ADDENDUM 2	05/05/12	C.T.
00	ISSUED FOR TENDER	05/04/17	C.T.
NO.	REVISIONS	DATE	BY

CH2MHILL
Frederickson Cooper
ARCHITECTS

EarthTech
A Tech International Ltd. Company

ENGINEER'S SEAL
ORIGINAL SIGNED BY
F.A. KEMP
2005/04/17
CONSULTANT DRAWING NO.
WT-S028

THE CITY OF WINNIPEG
WATER AND WASTE DEPARTMENT
ENGINEERING DIVISION

WATER TREATMENT PLANT CLEARWELL CONSTRUCTION

CITY FILE NUMBER
SHEET OF
CITY DRAWING NUMBER
1-060T-A-S0028-001-01D

STRUCTURAL INLET BUILDING ELEVATIONS