SHEET: COW-A1 (03/2005)

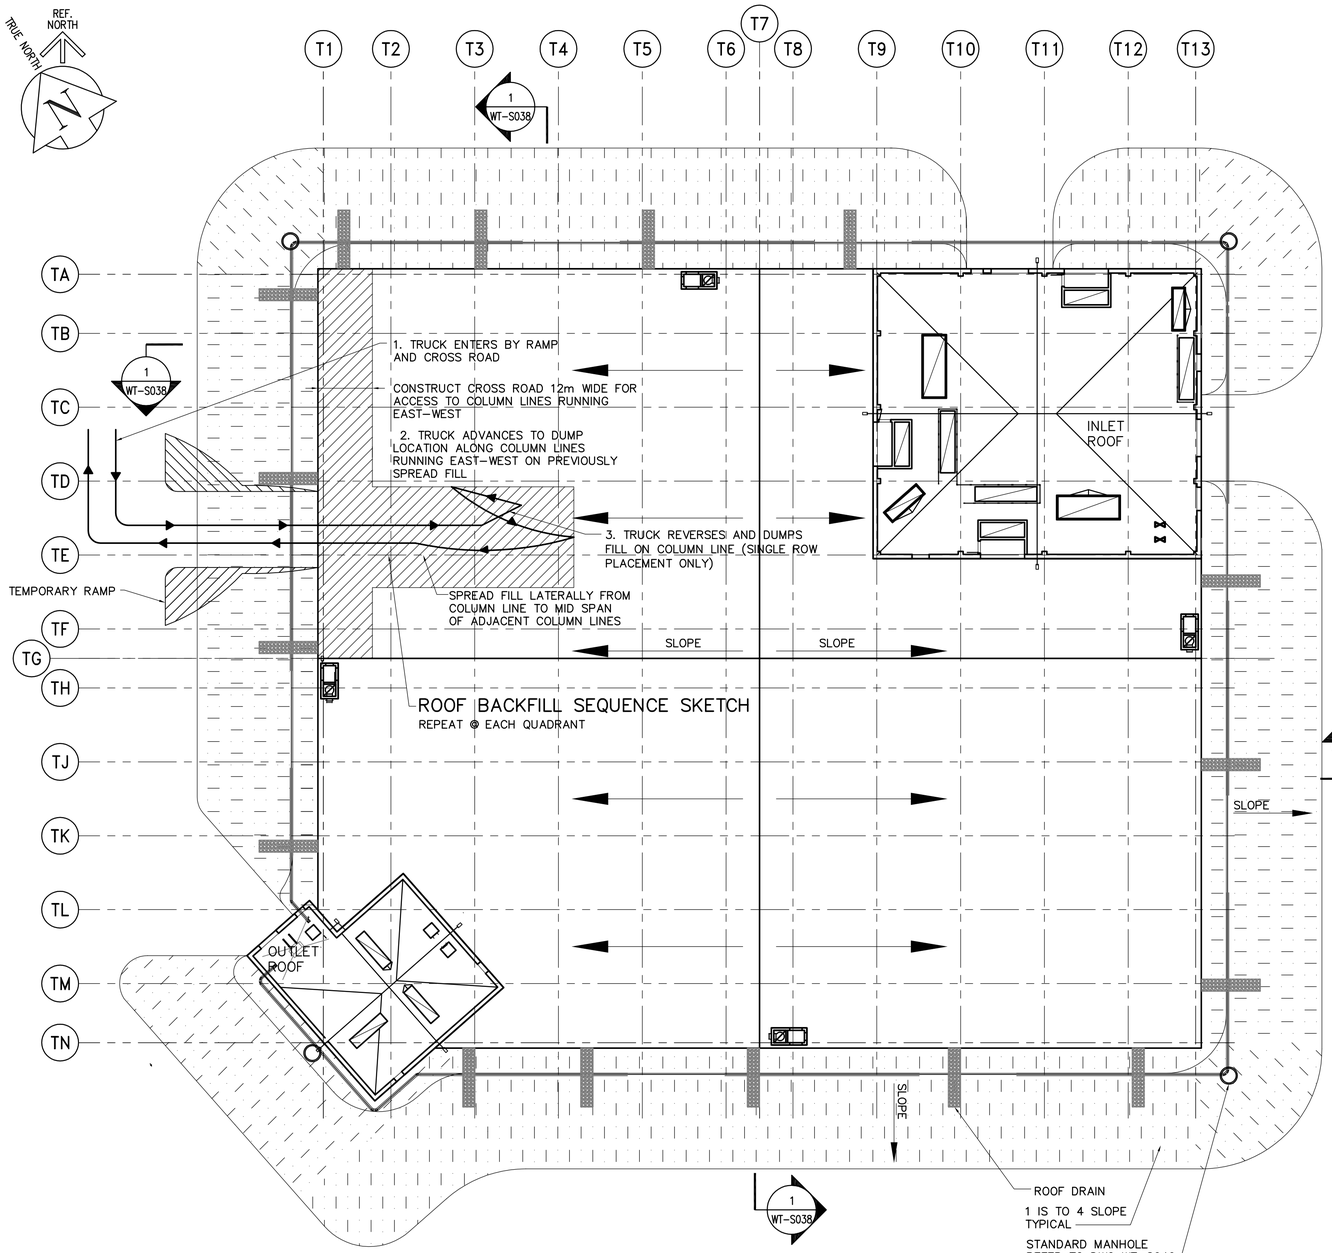

ROOF DRAINAGE PLAN
1:200

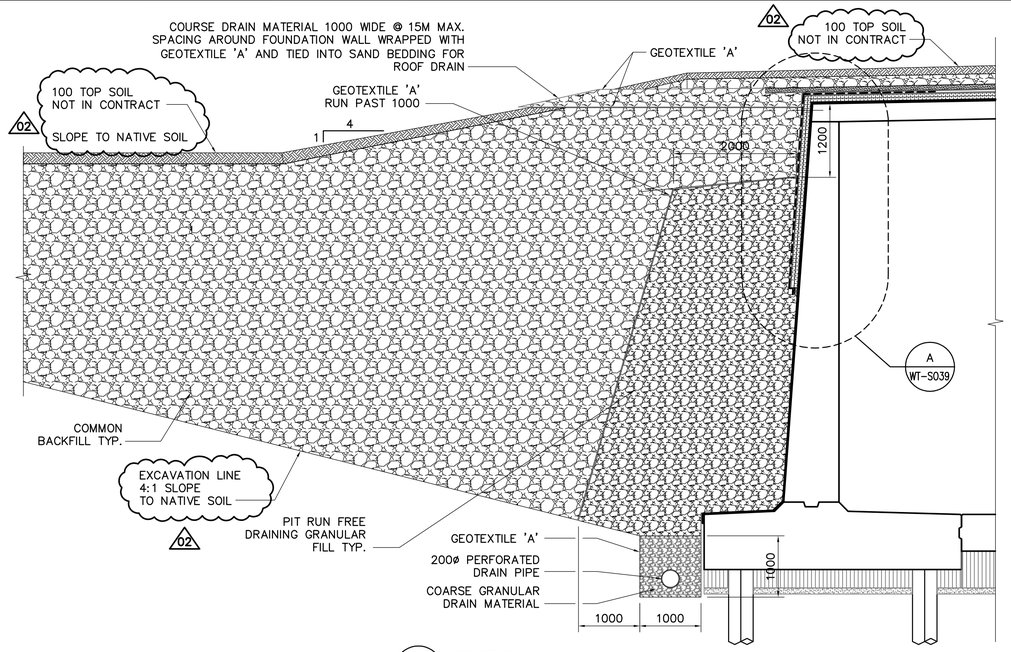

1 WT-S038 SECTION
1:50

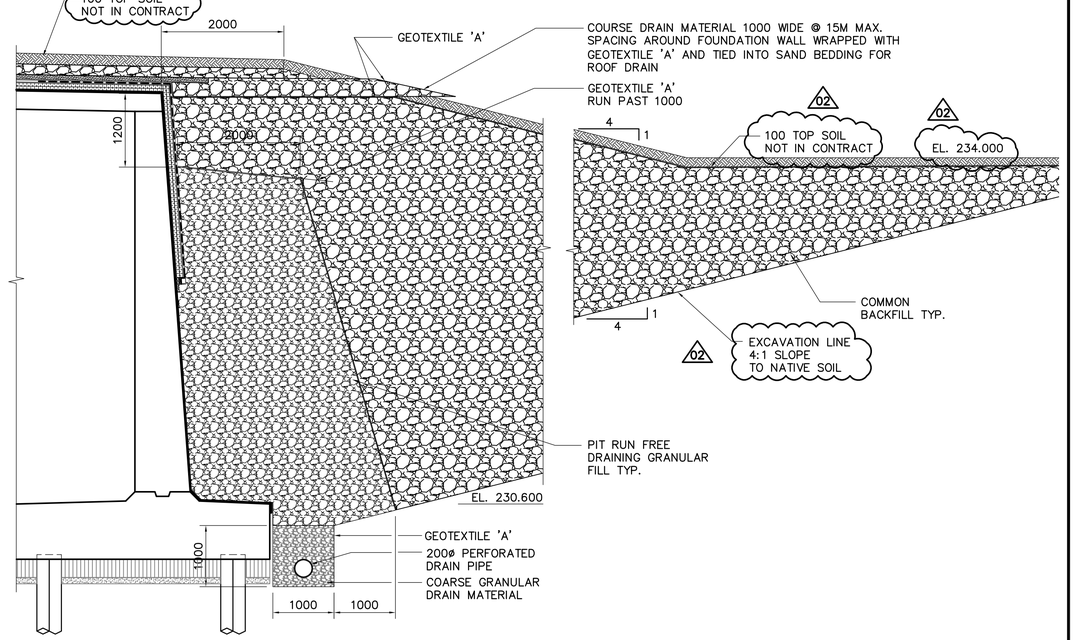

2 WT-S038 SECTION
1:50

APEGM
Certificate of Authorization
Earth Tech Canada Inc.
No. 730 Expiry: April 30, 2006

NO.	REVISIONS	DATE	BY
02	166-2005 ADDENDUM 2	05/05/12	C.T.
01	166-2005 ADDENDUM 1	05/05/06	C.T.
00	ISSUED FOR TENDER	05/04/17	C.T.

B.M. ELEV.

CH2MHILL
Fredericksen Cooper ARCHITECTS
EarthTech A Tyco International Ltd. Company

DESIGNED BY	FK	CHECKED BY	MK
DRAWN BY	C.T. / WDB	APPROVED BY	AHL
HOR. SCALE:	AS NOTED	RELEASED FOR CONSTRUCTION BY:	R. SOROKOWSKI
VERTICAL SCALE:			
DATE	2005/03/09	DATE	2005-04-17

ENGINEER'S SEAL
ORIGINAL SIGNED BY
F.A. KEMP
2005/04/17

CONSULTANT DRAWING NO.
WT-S038

THE CITY OF WINNIPEG
Winnipeg
WATER AND WASTE DEPARTMENT
ENGINEERING DIVISION

WATER TREATMENT PLANT
CLEARWELL CONSTRUCTION

CITY FILE NUMBER
SHEET OF

STRUCTURAL
ROOF DRAINAGE PLAN
DETAIL SECTION OF MANHOLE

CITY DRAWING NUMBER
1-0601T-A-S0038-001-02D

05/12/05 09:11am corey.thiessen L:\work\79000\79538\02a-CAD\IND\CONTR\WT-S038.dwg Layout:Layout1

L:\work\79000\79538\02a-CAD\IND\CONTR\WT-S038.dwg, 5/12/2005 9:11:50 AM, corey.thiessen