


**NOTES:**  
 1. SEE PLANS FOR SLAB REINFORCEMENT.  
 2. SEE DWG WA-S0515 FOR BEAM AND COLUMN SCHEDULES.

01 BACKGROUND HIDDEN LINES REVISED OR SHOWN FOR CLARITY

**E SECTION**  
 WA-S0101 1:50

WA-S0111, WA-S0121,  
 WA-S0131, WA-S0141

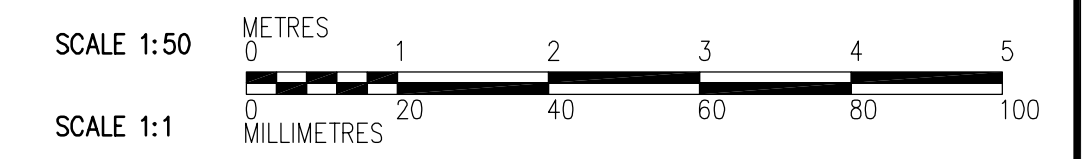

**APECA**  
 Certificate of Authorization  
 CH2M HILL Canada Ltd.  
 No. 1441 Expiry: April 30, 2006

NO.	REVISIONS	DATE	BY
01	583-2005 ADDENDUM 3	06/03/10	EL
00	ISSUED FOR TENDER	2006/02/03	MC

DESIGNED BY	MC	CHECKED BY	AP
DRAWN BY	RL	APPROVED BY	DJT
SCALE:	1:50	RELEASED FOR CONSTRUCTION BY:	R. SOROKOWSKI
DATE	2005/08/04	DATE	2006/02/08

ENGINEER'S SEAL  
 ORIGINAL SIGNED BY  
 D. KRUGER  
 2006/02/06  
 CONSULTANT DRAWING NO.  
 WA-S0205

**THE CITY OF WINNIPEG**  
 WATER AND WASTE DEPARTMENT  
 ENGINEERING DIVISION

WATER TREATMENT PLANT  
 ADMINISTRATION  
 FOUNDATIONS AND CONCRETE STRUCTURES

STRUCTURAL  
 ADMINISTRATION AREA  
 SECTION

CITY FILE NUMBER  
 SHEET OF  
 CITY DRAWING NUMBER  
**1-0601A-A-0205-01-0D**