



KEYPLAN
SCALE N.T.S.

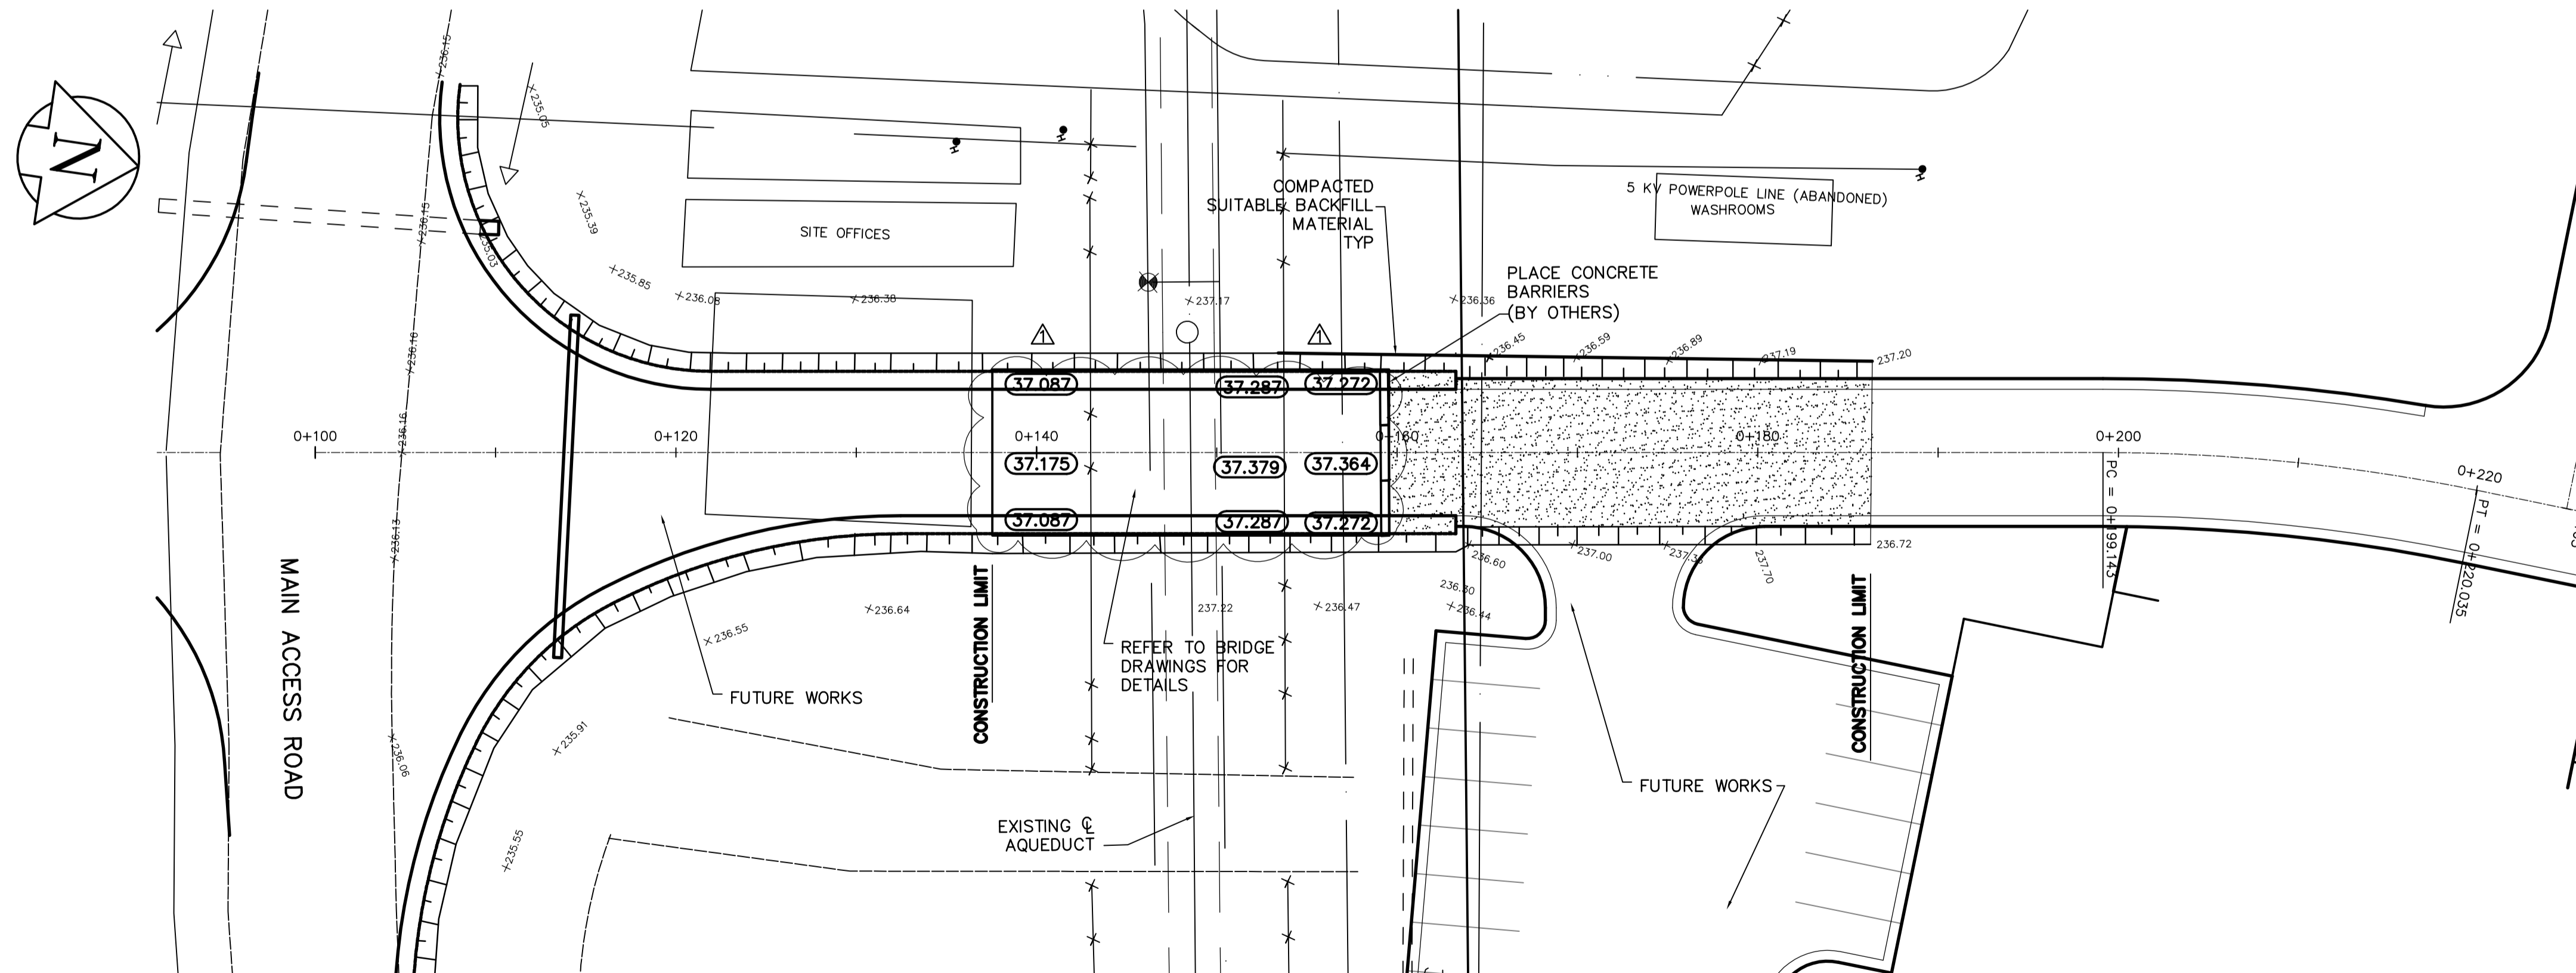

REFERENCE NOTES:
 A. ADD 200.00 TO OBTAIN GEODETIC DATUM
 B. ALL EXISTING UNDERGROUND UTILITIES SHALL BE CONFIRMED PRIOR TO CONSTRUCTION.

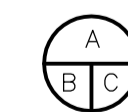

A. DETAIL NUMBER
 B. DRAWING WHERE DETAIL SHOWN
 C. CROSS REFERENCE TO DRAWING WHERE DETAIL INITIALLY TAKEN

METRIC
 WHOLE NUMBERS INDICATE MILLIMETRES
 DECIMALIZED NUMBERS INDICATE METRES

150 mm W.M.	WATERMAIN	150 mm W.M.	HYDRO M.T.S.	LIGHT STANDARD ANCHOR
300mm L.D.S.	LAND DRAINAGE SEWER	300mm L.D.S.	CONCRETE ASPHALT PROPERTY LINE	POLE CONTOURS
250mm W.W.S.	WASTEWATER SEWER	250mm W.W.S.	SURVEY BAR	RAIL X-ING SIGNAL
	MANHOLE		ELEVATION	& RAILWAY TRACK
	CATCH BASIN		TREE	DITCH
	CURB INLET		ANODE	
	JUNCTIONS		CONCRETE SIDEWALK	
	CULVERT		FENCE	
	GAS			
EXISTING	LEGEND - PLAN	PROPOSED	EXISTING	LEGEND - PLAN
			PROPOSED	
			EXISTING	LEGEND - PLAN
			PROPOSED	

APECA
 Certificate of Authorization
 Earth Tech Canada Inc.
 No. 730 Expiry: April 30, 2006

B.M. ELEV.			
01	583-2005 ADDENDUM 3	06/03/09	KC
00	ISSUED FOR TENDER	06/02/07	JC
NO.	REVISIONS	DATE	BY

CH2M HILL
 Frederickson Cooper ARCHITECTS
EarthTech
 A Tyco International Ltd. Company

DESIGNED BY	JC	CHECKED BY	EBL
DRAWN BY	KC	APPROVED BY	DJT
SCALE:	1:250	RELEASED FOR CONSTRUCTION BY:	R. SOROKOWSKI
		DATE	2006/02/07

ENGINEER'S SEAL
 ORIGINAL SIGNED BY
 J.N. CRANG
 2006/02/07
 CONSULTANT DRAWING NO.
 WN-C0161

THE CITY OF WINNIPEG
 WATER AND WASTE DEPARTMENT
 ENGINEERING DIVISION
 WATER TREATMENT PLANT
 AQUEDUCT BRIDGES
 FOUNDATION AND CONCRETE STRUCTURES
 CIVIL
 ROADWORKS AND WEST BRIDGE
 PLAN-PROFILE
 CITY FILE NUMBER
 SHEET OF
 CITY DRAWING NUMBER
1-060N-A-C0161-001-0D