




KEYPLAN  
SCALE N.T.S.

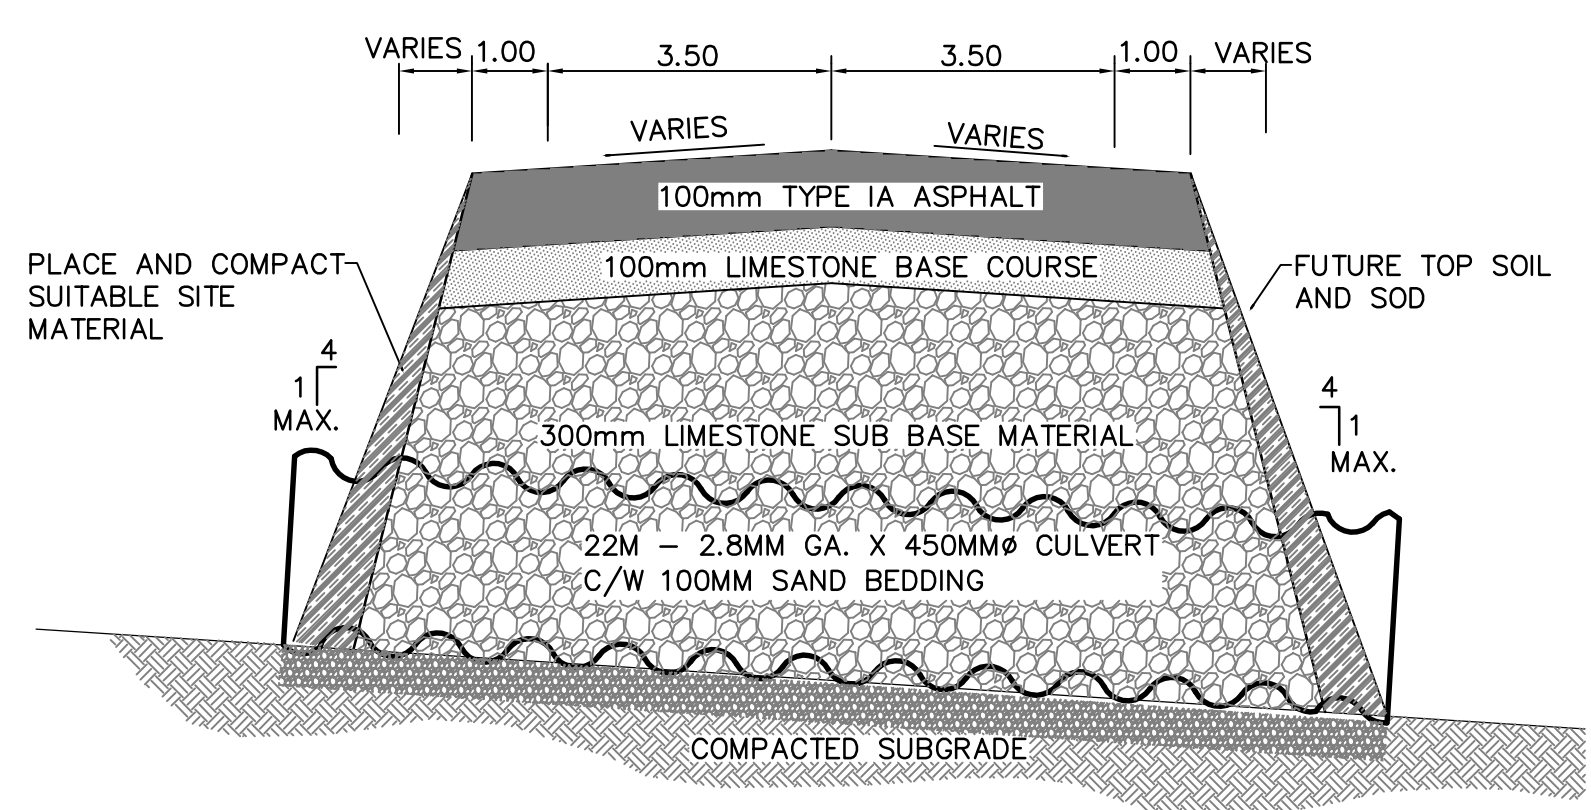

TYPICAL SECTION AT CULVERT  
SCALE N.T.S.

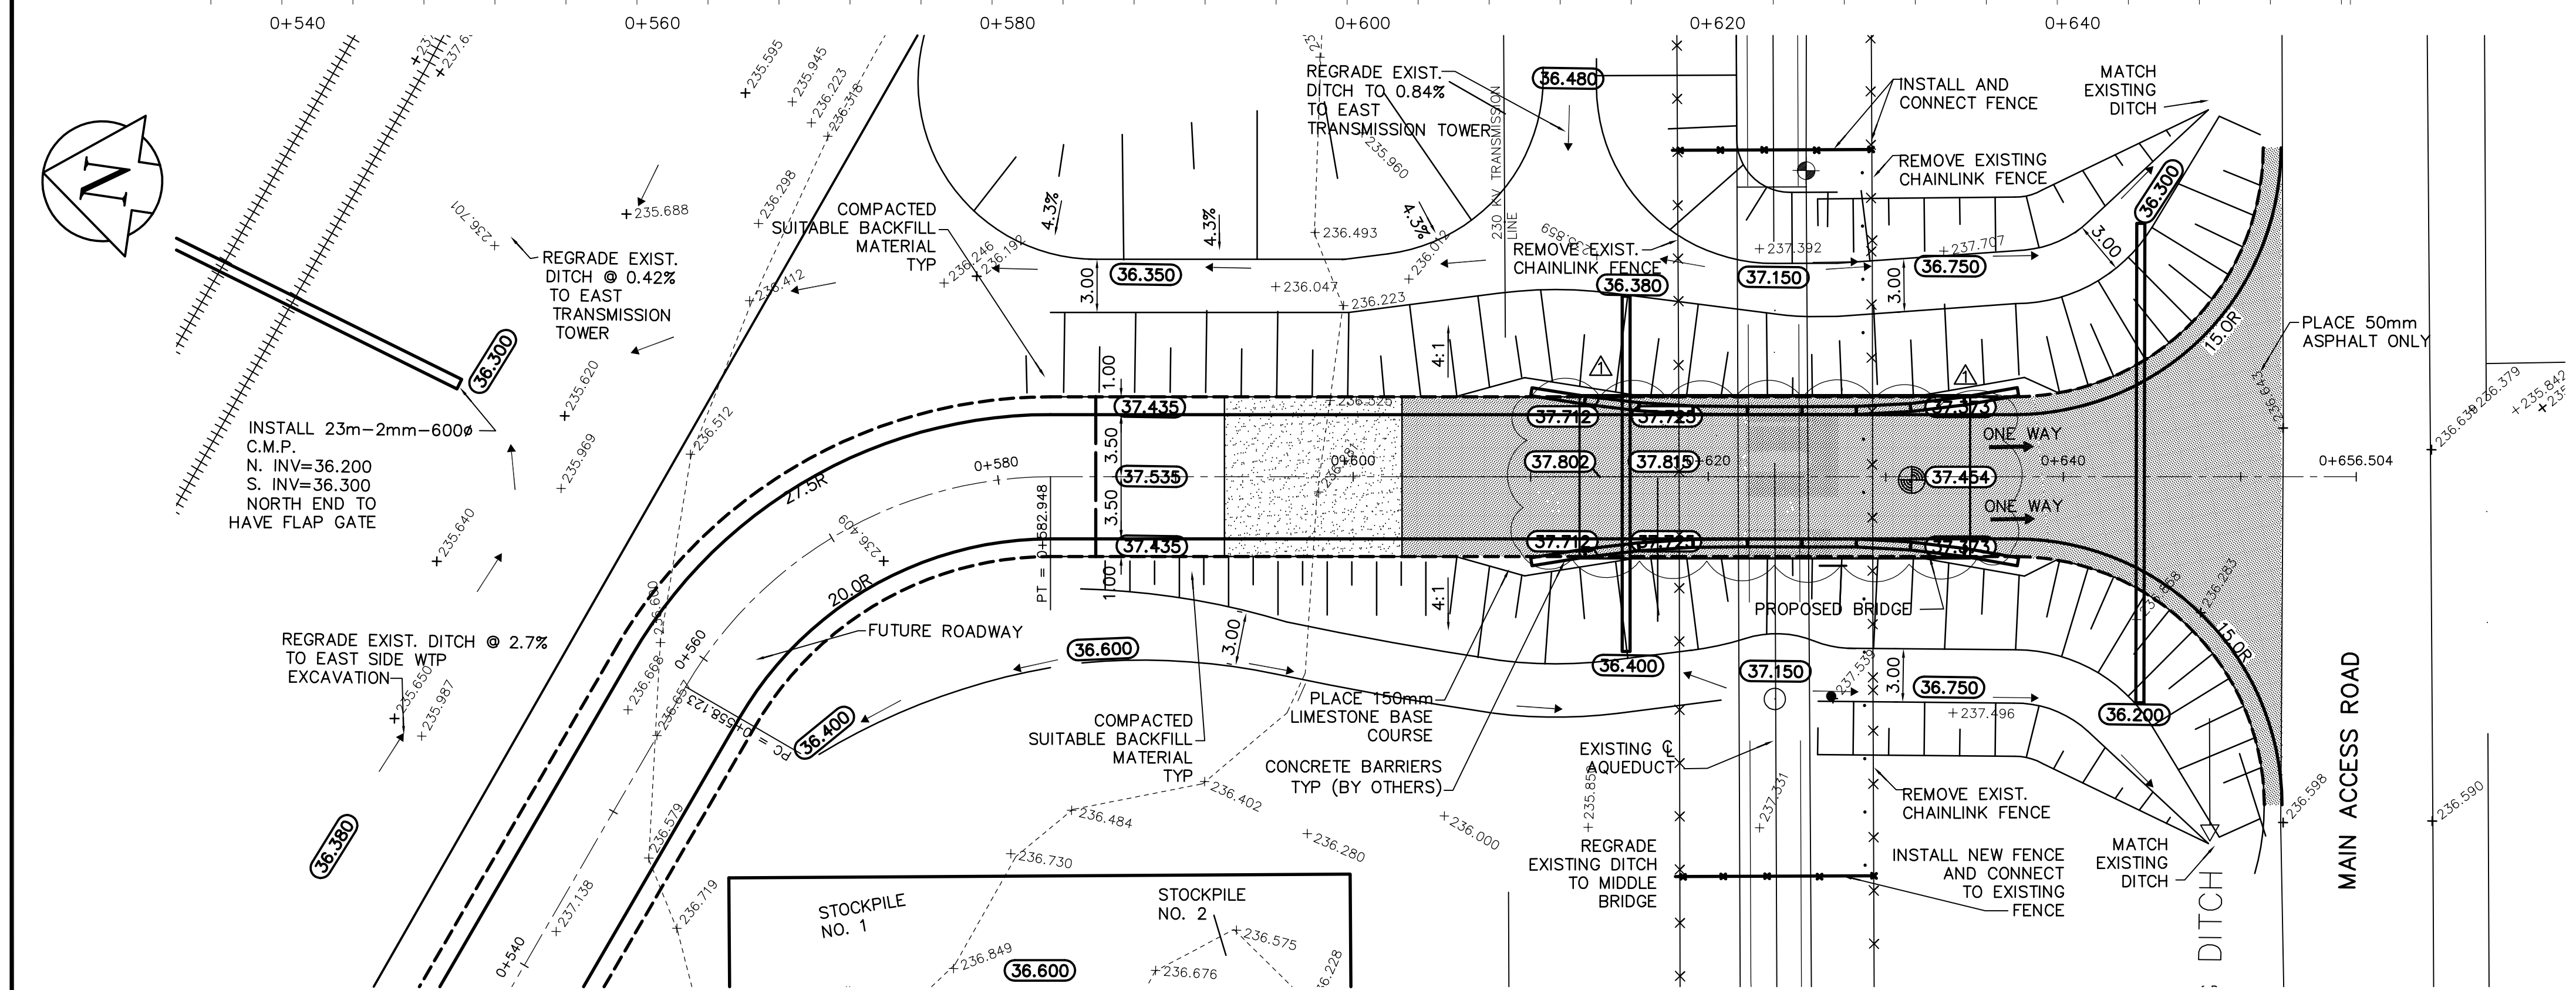

REFERENCE NOTES:  
A. ADD 200.00 TO OBTAIN GEODETIC DATUM  
B. ALL EXISTING UNDERGROUND UTILITIES SHALL BE CONFIRMED PRIOR TO CONSTRUCTION.

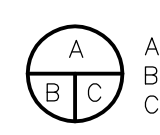

METRIC  
WHOLE NUMBERS INDICATE MILLIMETRES  
DECIMALIZED NUMBERS INDICATE METRES

150 mm W.M.	WATERMAIN	150 mm W.M.	HYDRO	ANCHOR	ANCHOR
300mm L.D.S.	LAND DRAINAGE SEWER	300mm L.D.S.	M.T.S.	POLE	POLE
250mm W.W.S.	WASTEWATER SEWER	250mm W.W.S.	CONCRETE	CONTOURS	CONTOURS
	MANHOLE		ASPHALT	RAIL X-ING SIGNAL	RAILWAY TRACK
	CATCH BASIN		PROPERTY LINE	DITCH	DITCH
	CURB INLET		SURVEY BAR		
	JUNCTIONS		ELEVATION		
	CULVERT		TREE		
	GAS		ANODE		
			CONCRETE SIDEWALK		
			FENCE		

**APCGM**  
Certificate of Authorization  
Earth Tech Canada Inc.  
No. 730 Expiry: April 30, 2006

B.M. ELEV.			
DESIGNED BY	JNC	CHECKED BY	JNC
DRAWN BY	BC/PAAP	APPROVED BY	DJT
SCALE:	1:250	RELEASED FOR CONSTRUCTION BY:	R. SOROKOWSKI
NO. REVISIONS	DATE	DATE	DATE
01	583-2005 ADDENDUM 3	06/03/09	KC
00	ISSUED FOR TENDER	06/02/07	JC
		2005/08/29	

**CH2MHILL**  
Frederickson Cooper ARCHITECTS

**EarthTech**  
A Tech International Ltd. Company

ENGINEER'S SEAL  
ORIGINAL SIGNED BY  
J.N. CRANG  
2006/02/07

CONSULTANT DRAWING NO.  
WN-C0163

**THE CITY OF WINNIPEG**  
WATER AND WASTE DEPARTMENT  
ENGINEERING DIVISION

WATER TREATMENT PLANT  
AQUEDUCT BRIDGES  
FOUNDATIONS AND CONCRETE STRUCTURES

CITY FILE NUMBER  
SHEET OF  
CITY DRAWING NUMBER  
1-060N-A-C0163-001-0D

CIVIL  
ROADWORKS AND EAST BRIDGE  
PLAN-PROFILE