SHEET: COW-A1 (05/2005)

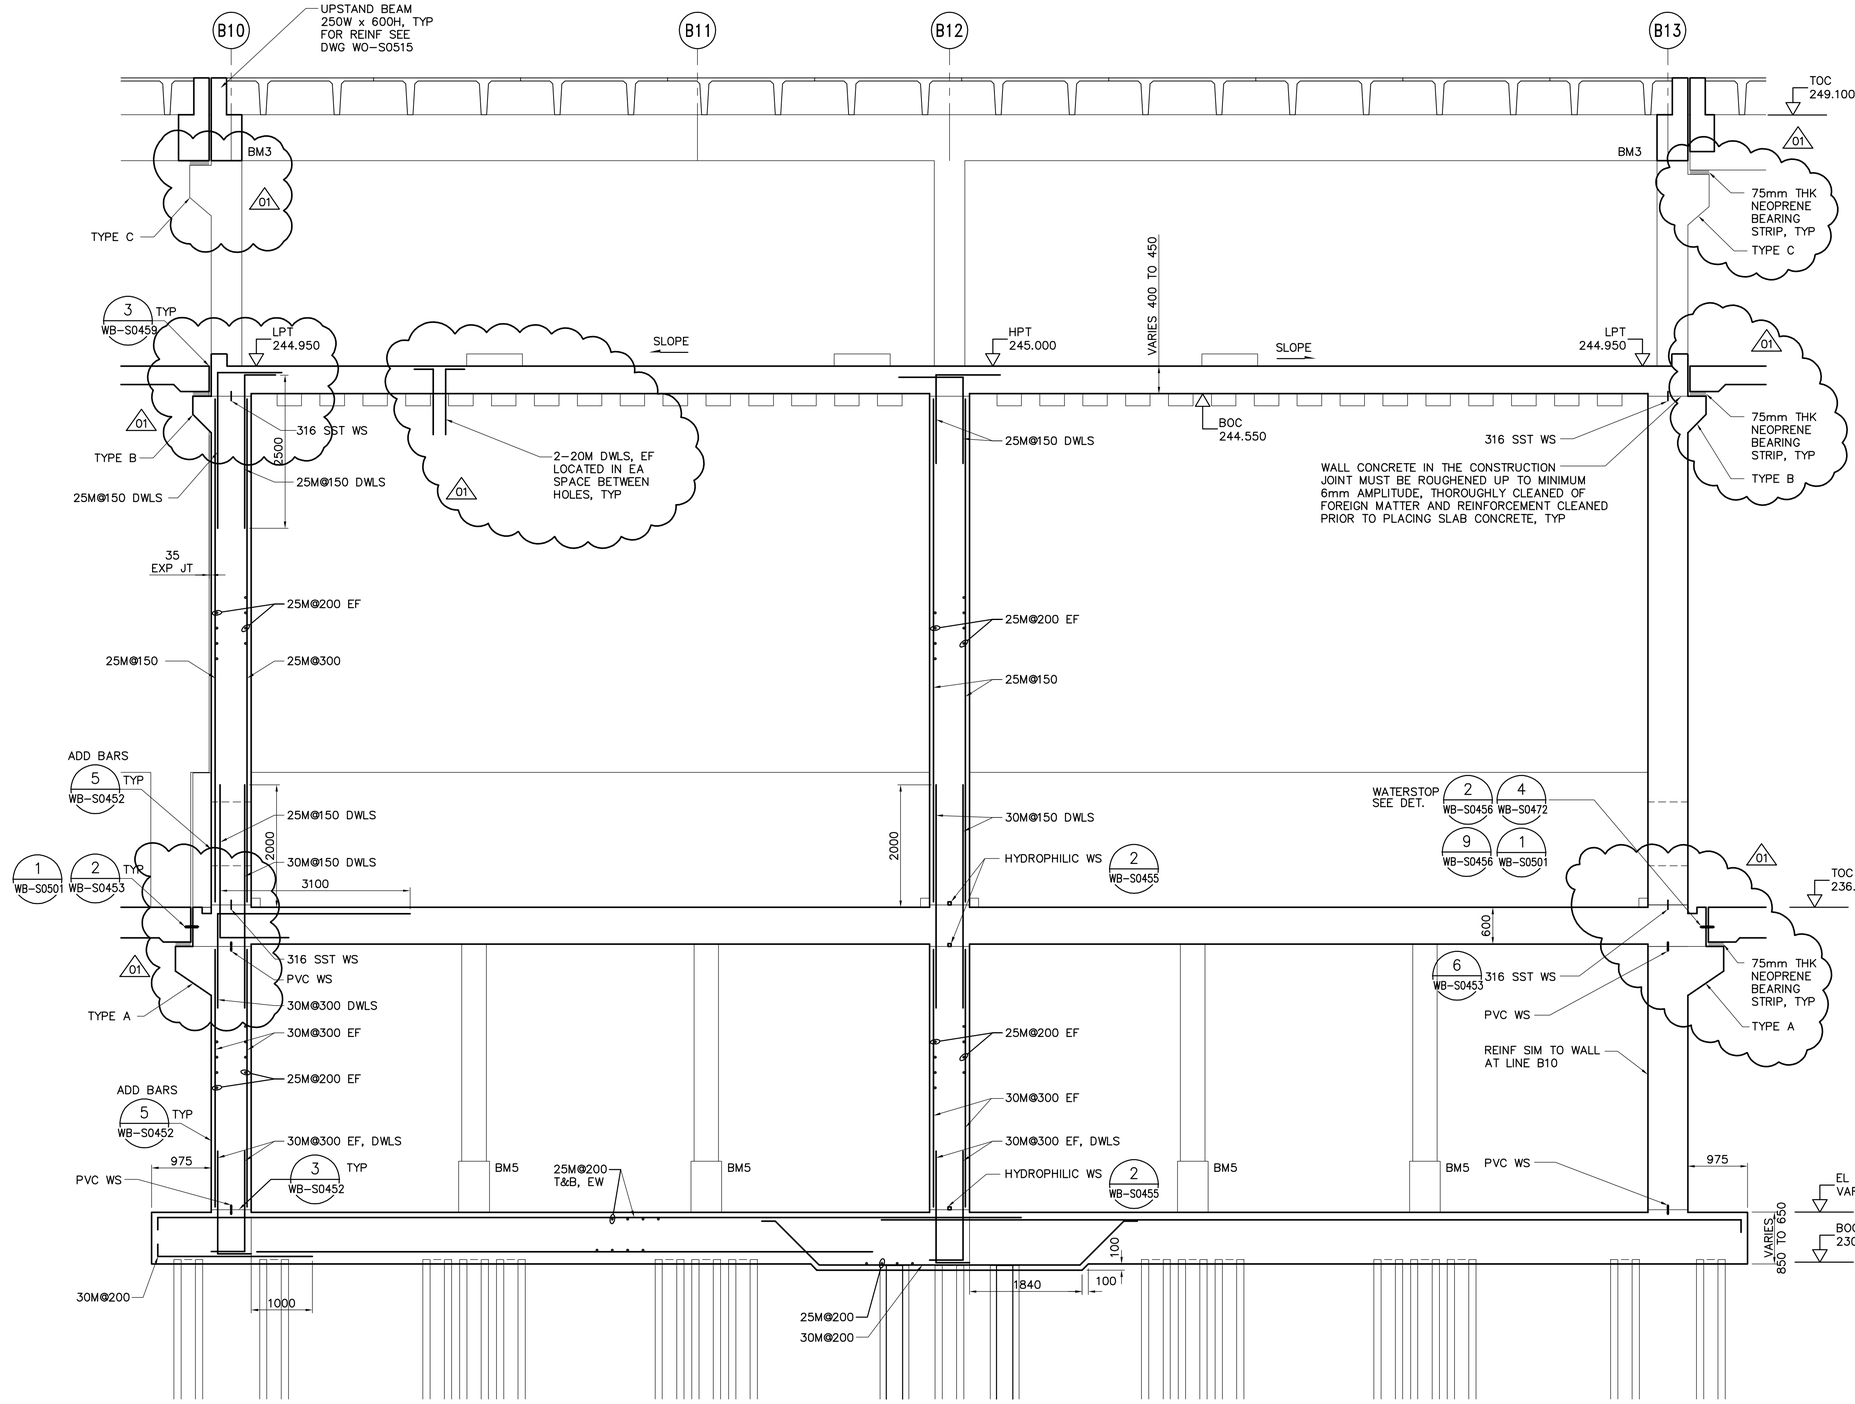

A WO-S0101 SECTION 1:50

WO-S0111, WO-S0121
WO-S0131, WO-S0141,
WO-S0146

NOTES:

1. SEE PLANS FOR SLAB REINFORCEMENT.
2. FOR BEAM SCHEDULE SEE DRAWING WO-S0515.
3. PROVIDE WATER PROOFING, SLIP SHEET AND PROTECTION BOARD FROM FOOTING (APPX 231.000) TO TOP OF THE CORBEL (APPX EL 235.570) IN THE CORRIDOR AREA, TO EL 232.200 IN THE STAIR-9 ON THE WEST WALL, AND TO TOP OF THE CORBEL (APPX EL 235.570) IN THE CORRIDOR AND EL 232.300 IN THE STAIR-10) ON EAST WALL. FROM 231.200 TO EL 235.570 ON SOUTH WALL, SEE 3 WB-S0461
4. NO INSULATION REQUIRED.

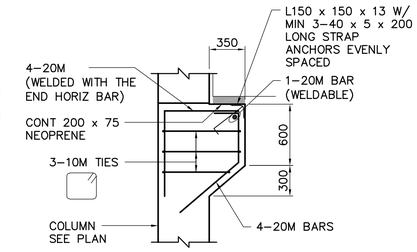

CORBEL WIDTH: 500mm

CORBEL - TYPE C
N.T.S.

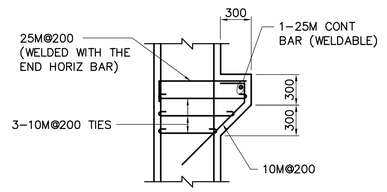

CORBEL - TYPE B
N.T.S.

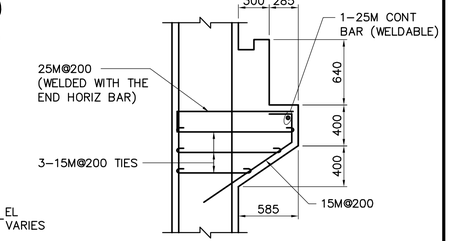

CORBEL - TYPE A
N.T.S.

SCALE 1:50 METRES 0 1 2 3 4 5
SCALE 1:1 MILLIMETRES 0 20 40 60 80 100

Certificate of Authorization
CH2M HILL Canada Ltd.
No. 1441 Expiry: April 30, 2006

B.M. ELEV.

NO.	REVISIONS	DATE	BY
01	583-2005 ADDENDUM 3	06/03/10	MH
00	ISSUED FOR TENDER	2006/02/03	MH

CH2MHILL Fredericksen Cooper ARCHITECTS
EarthTech A Tyco International Ltd. Company

DESIGNED BY	MH	CHECKED BY	AP
DRAWN BY	RL	APPROVED BY	DJT
SCALE:	1:50	RELEASED FOR CONSTRUCTION BY:	R. SOROKOWSKI
DATE	2005/08/10	DATE	2006/02/08

ENGINEER'S SEAL
ORIGINAL SIGNED BY
D. KRUGER
2006/02/06

CONSULTANT DRAWING NO.
WO-S0201

Winnipeg
THE CITY OF WINNIPEG
WATER AND WASTE DEPARTMENT
ENGINEERING DIVISION

WATER TREATMENT PLANT
OZONE
FOUNDATIONS AND CONCRETE STRUCTURES
STRUCTURAL
OZONATION AREA
SECTION

CITY FILE NUMBER
SHEET OF
CITY DRAWING NUMBER
1-0601O-A-S0201-001-01D

Last Save: 2006-03-13 3:49 PM

P:\EARTHTECH\321352WINNIPEGWTP\NDM\DESIGN\ACAD\583-POSTTENDER\DN_WO-S0201_CH2M.DWG