
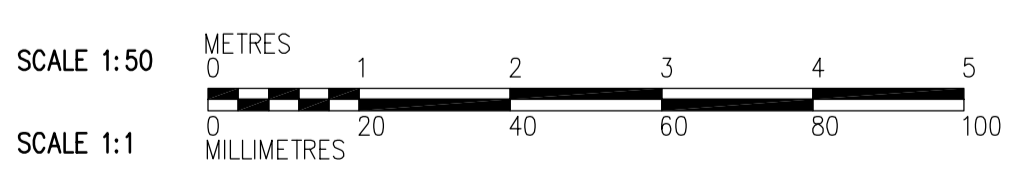


- NOTES:**
- SEE PLANS FOR SLAB REINFORCEMENT.
 - FOR BEAM SCHEDULE SEE DRAWING WO-S0515.

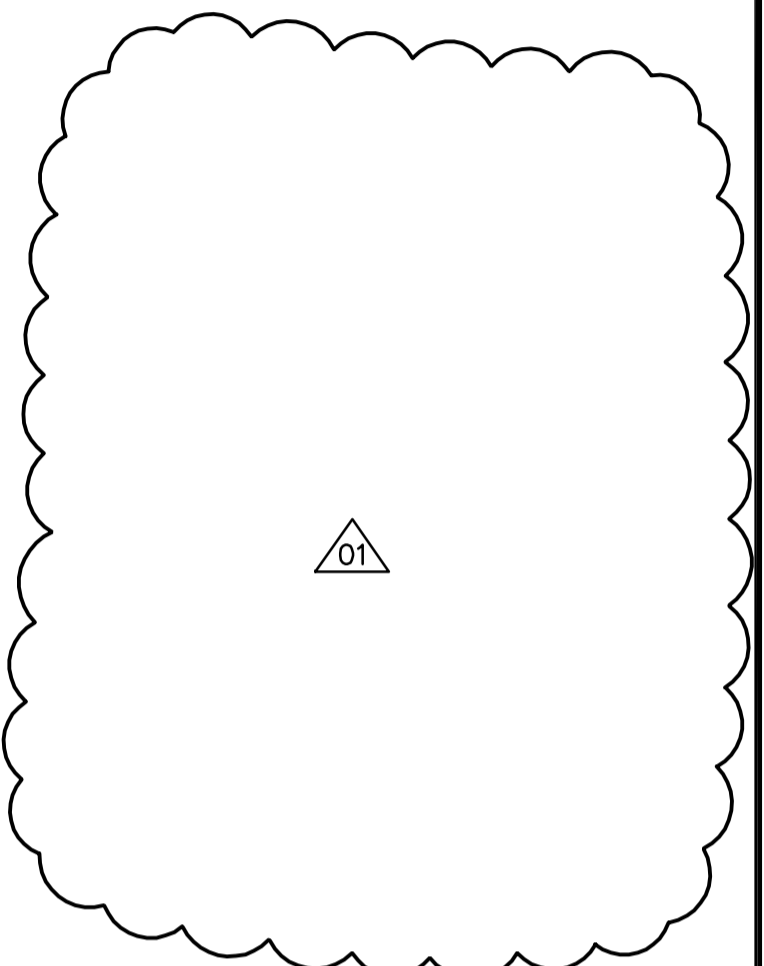

WO-S0111, WO-S0121
WO-S0131, WO-S0141, WO-S0146

APECA
Certificate of Authorization
CH2M HILL Canada Ltd.
No. 1441 Expiry: April 30, 2006

NO.	REVISIONS	DATE	BY
01	583-2005 ADDENDUM 3	06/03/10	MH
00	ISSUED FOR TENDER	2006/02/03	MH

DESIGNED BY	MH	CHECKED BY	AP
DRAWN BY	RL	APPROVED BY	DJT
SCALE:	1:50	RELEASED FOR CONSTRUCTION BY:	R. SOROKOWSKI
DATE	2005/08/10	DATE	2006/02/08

ENGINEER'S SEAL
ORIGINAL SIGNED BY
D. KRUGER
2006/02/06
CONSULTANT DRAWING NO.
WO-S0203

THE CITY OF WINNIPEG
WATER AND WASTE DEPARTMENT
ENGINEERING DIVISION

WATER TREATMENT PLANT
OZONE
FOUNDATIONS AND CONCRETE STRUCTURES

STRUCTURAL
OZONATION AREA
SECTION

CITY FILE NUMBER
SHEET OF
CITY DRAWING NUMBER
1-0600-A-80203-01-01