


SHEET: COW-A1 (05/2005)

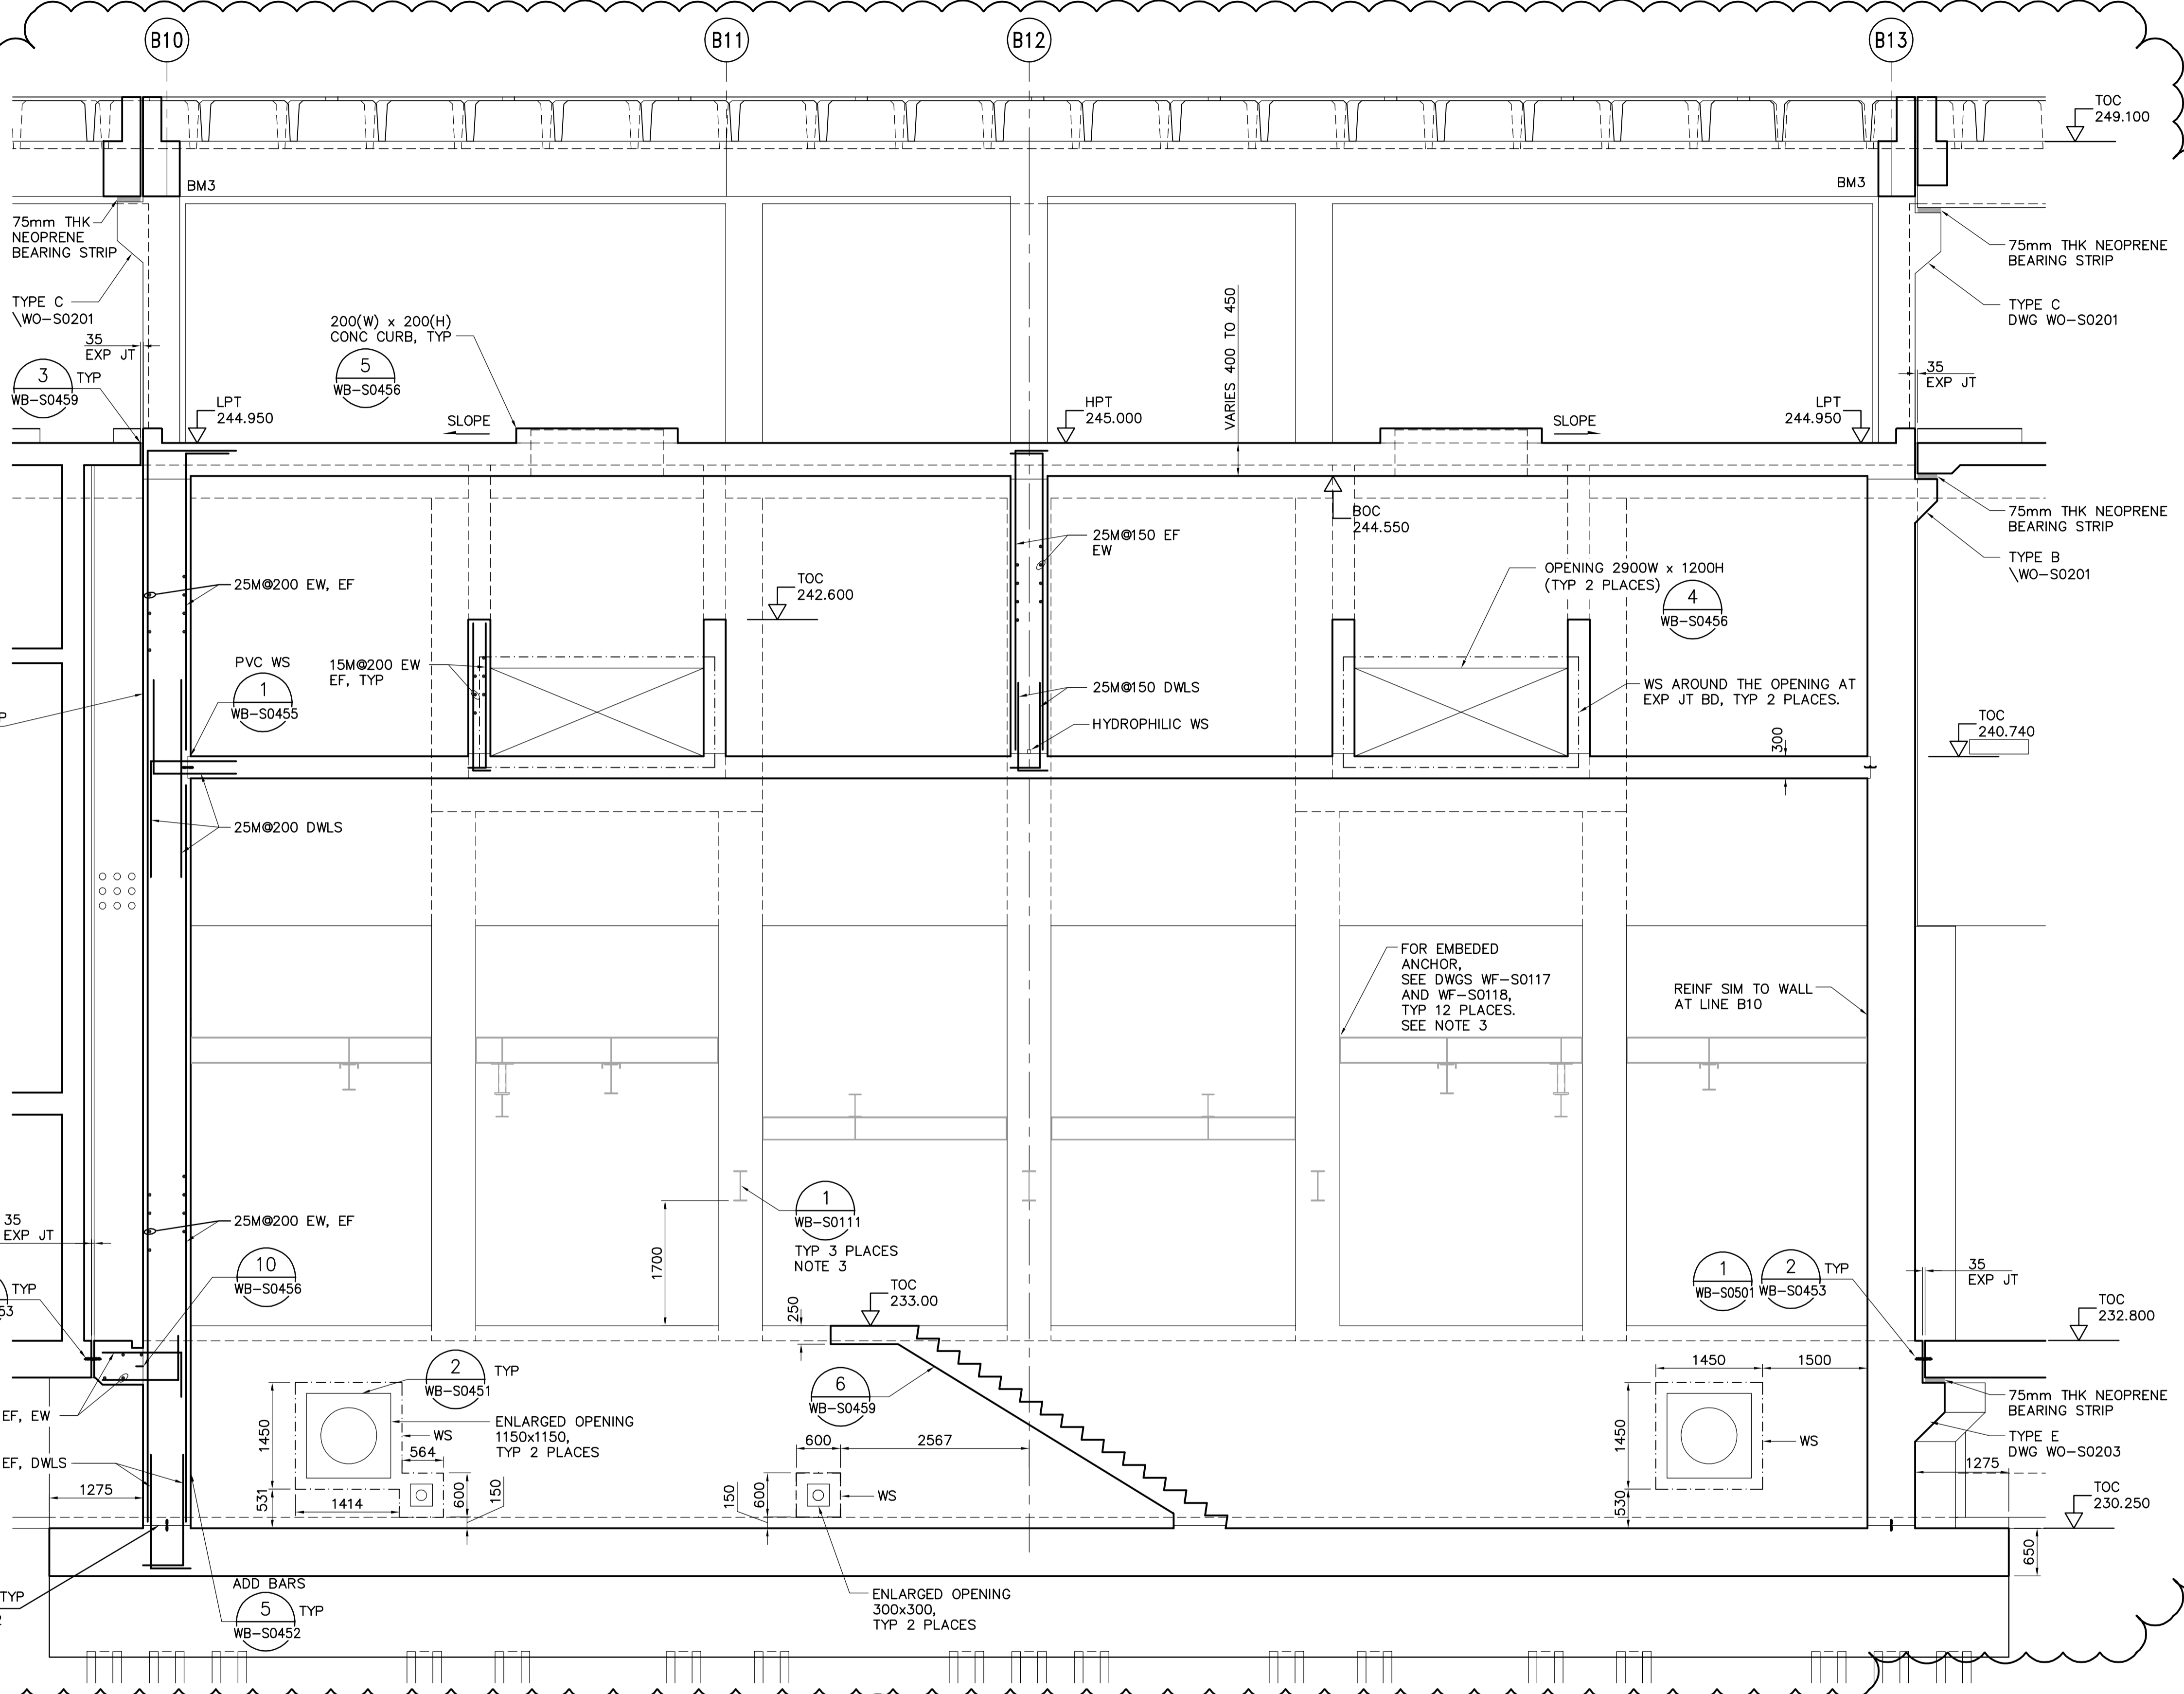


NOTES:

1. SEE PLANS FOR SLAB REINFORCEMENT.
2. FOR BEAM SCHEDULE SEE DRAWING WO-S0515.
3. MONORAILS AND SUPPORT BEAMS ARE NOT IN THIS CONTRACT.

D SECTION

WO-S0111, WO-S0121
WO-S0131, WO-S0141, WO-S0146

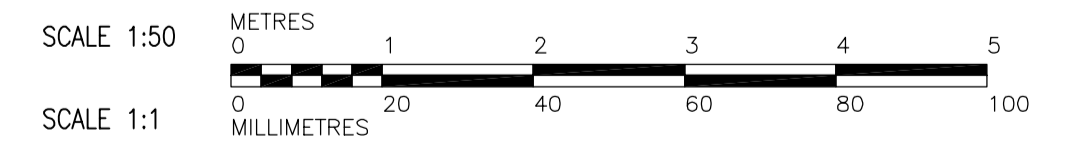

<p>APEGN Certificate of Authorization CH2M HILL Canada Ltd. No. 1441 Expiry: April 30, 2006</p>	B.M. ELEV.	<p>CH2MHILL Frederickson Cooper ARCHITECTS</p>	<p>EarthTech A Tetra International Ltd. Company</p>	ENGINEER'S SEAL	<p>THE CITY OF WINNIPEG WATER AND WASTE DEPARTMENT ENGINEERING DIVISION</p>
	DESIGNED BY: MH	CHECKED BY: AP	ORIGINAL SIGNED BY: D. KRUGER	<p>WATER TREATMENT PLANT OZONE FOUNDATIONS AND CONCRETE STRUCTURES</p>	
	DRAWN BY: RL	APPROVED BY: DJT	DATE: 2006/02/06		
	SCALE: 1:50	RELEASED FOR CONSTRUCTION BY: R. SOROKOWSKI	CONSULTANT DRAWING NO. WO-S0204	SHEET OF	
	DATE: 2005/08/10	DATE: 2006/02/08		CITY DRAWING NUMBER 1-0600-A-80204-001-01D	