




NOTES:
1. SEE PLANS FOR SLAB REINFORCEMENT.

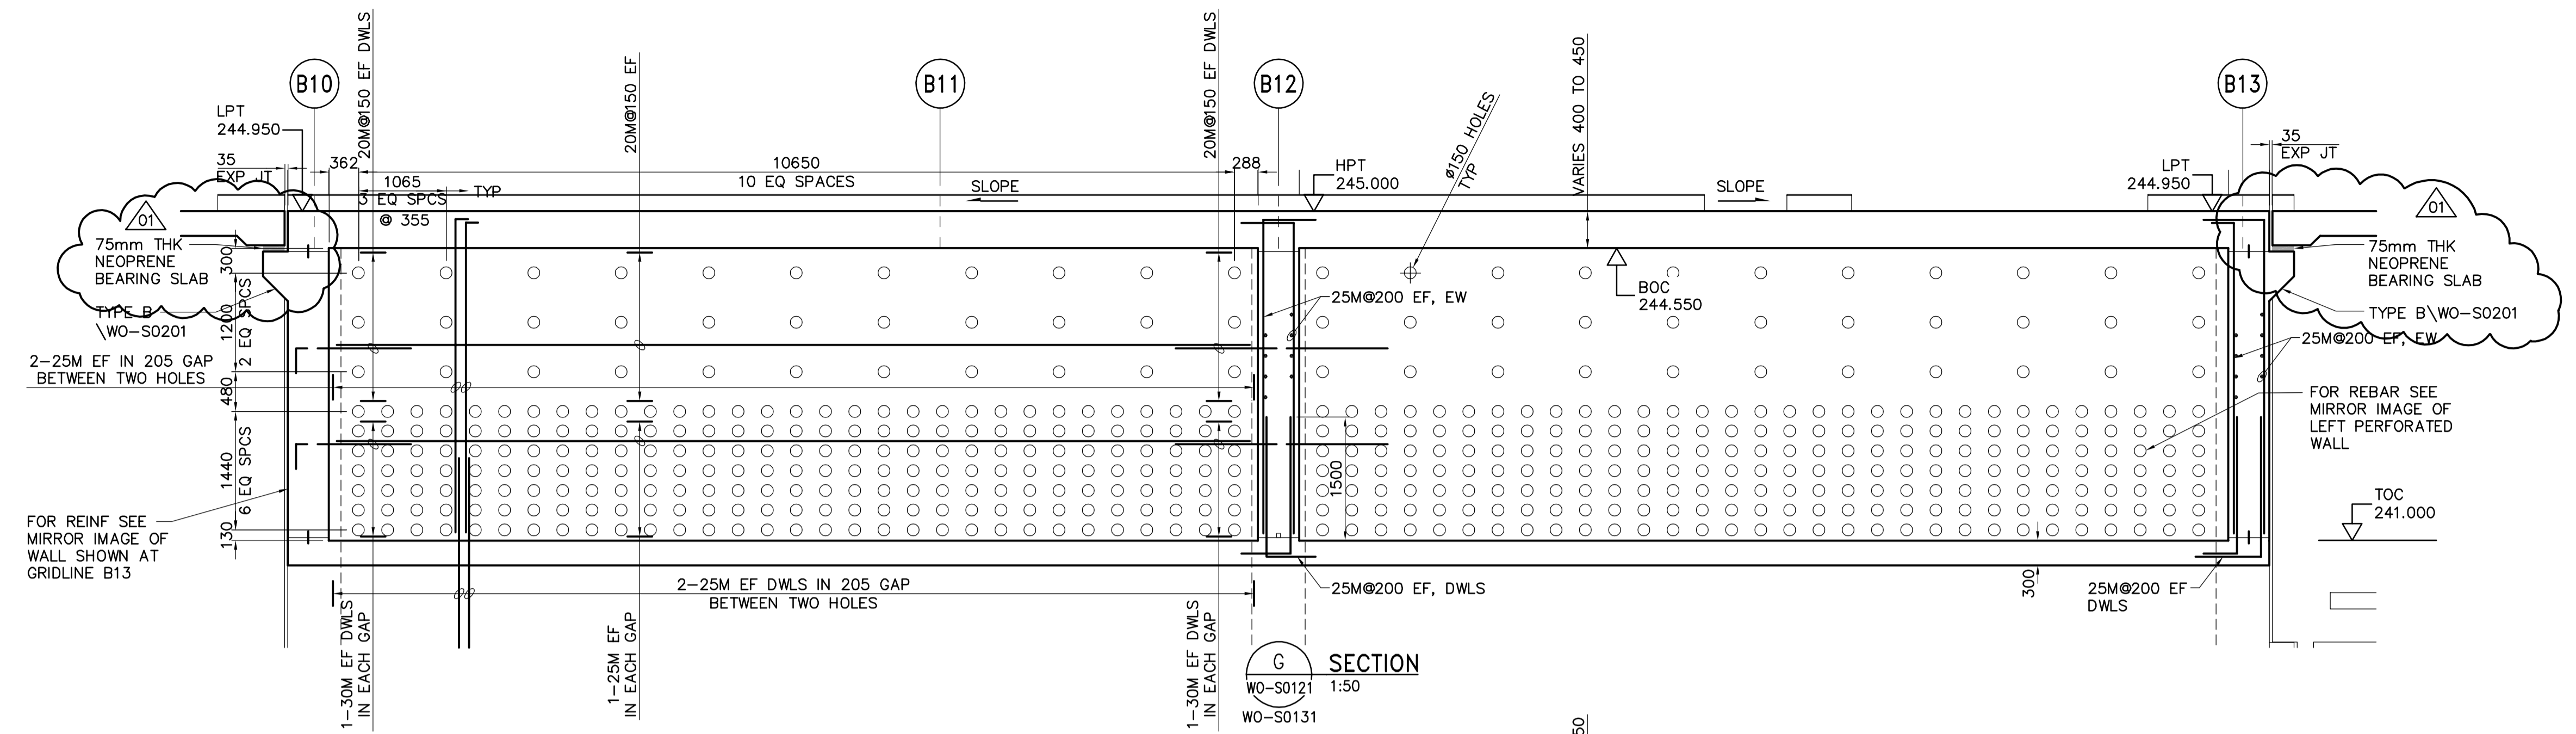

G SECTION
WO-S0121, WO-S0131
1:50

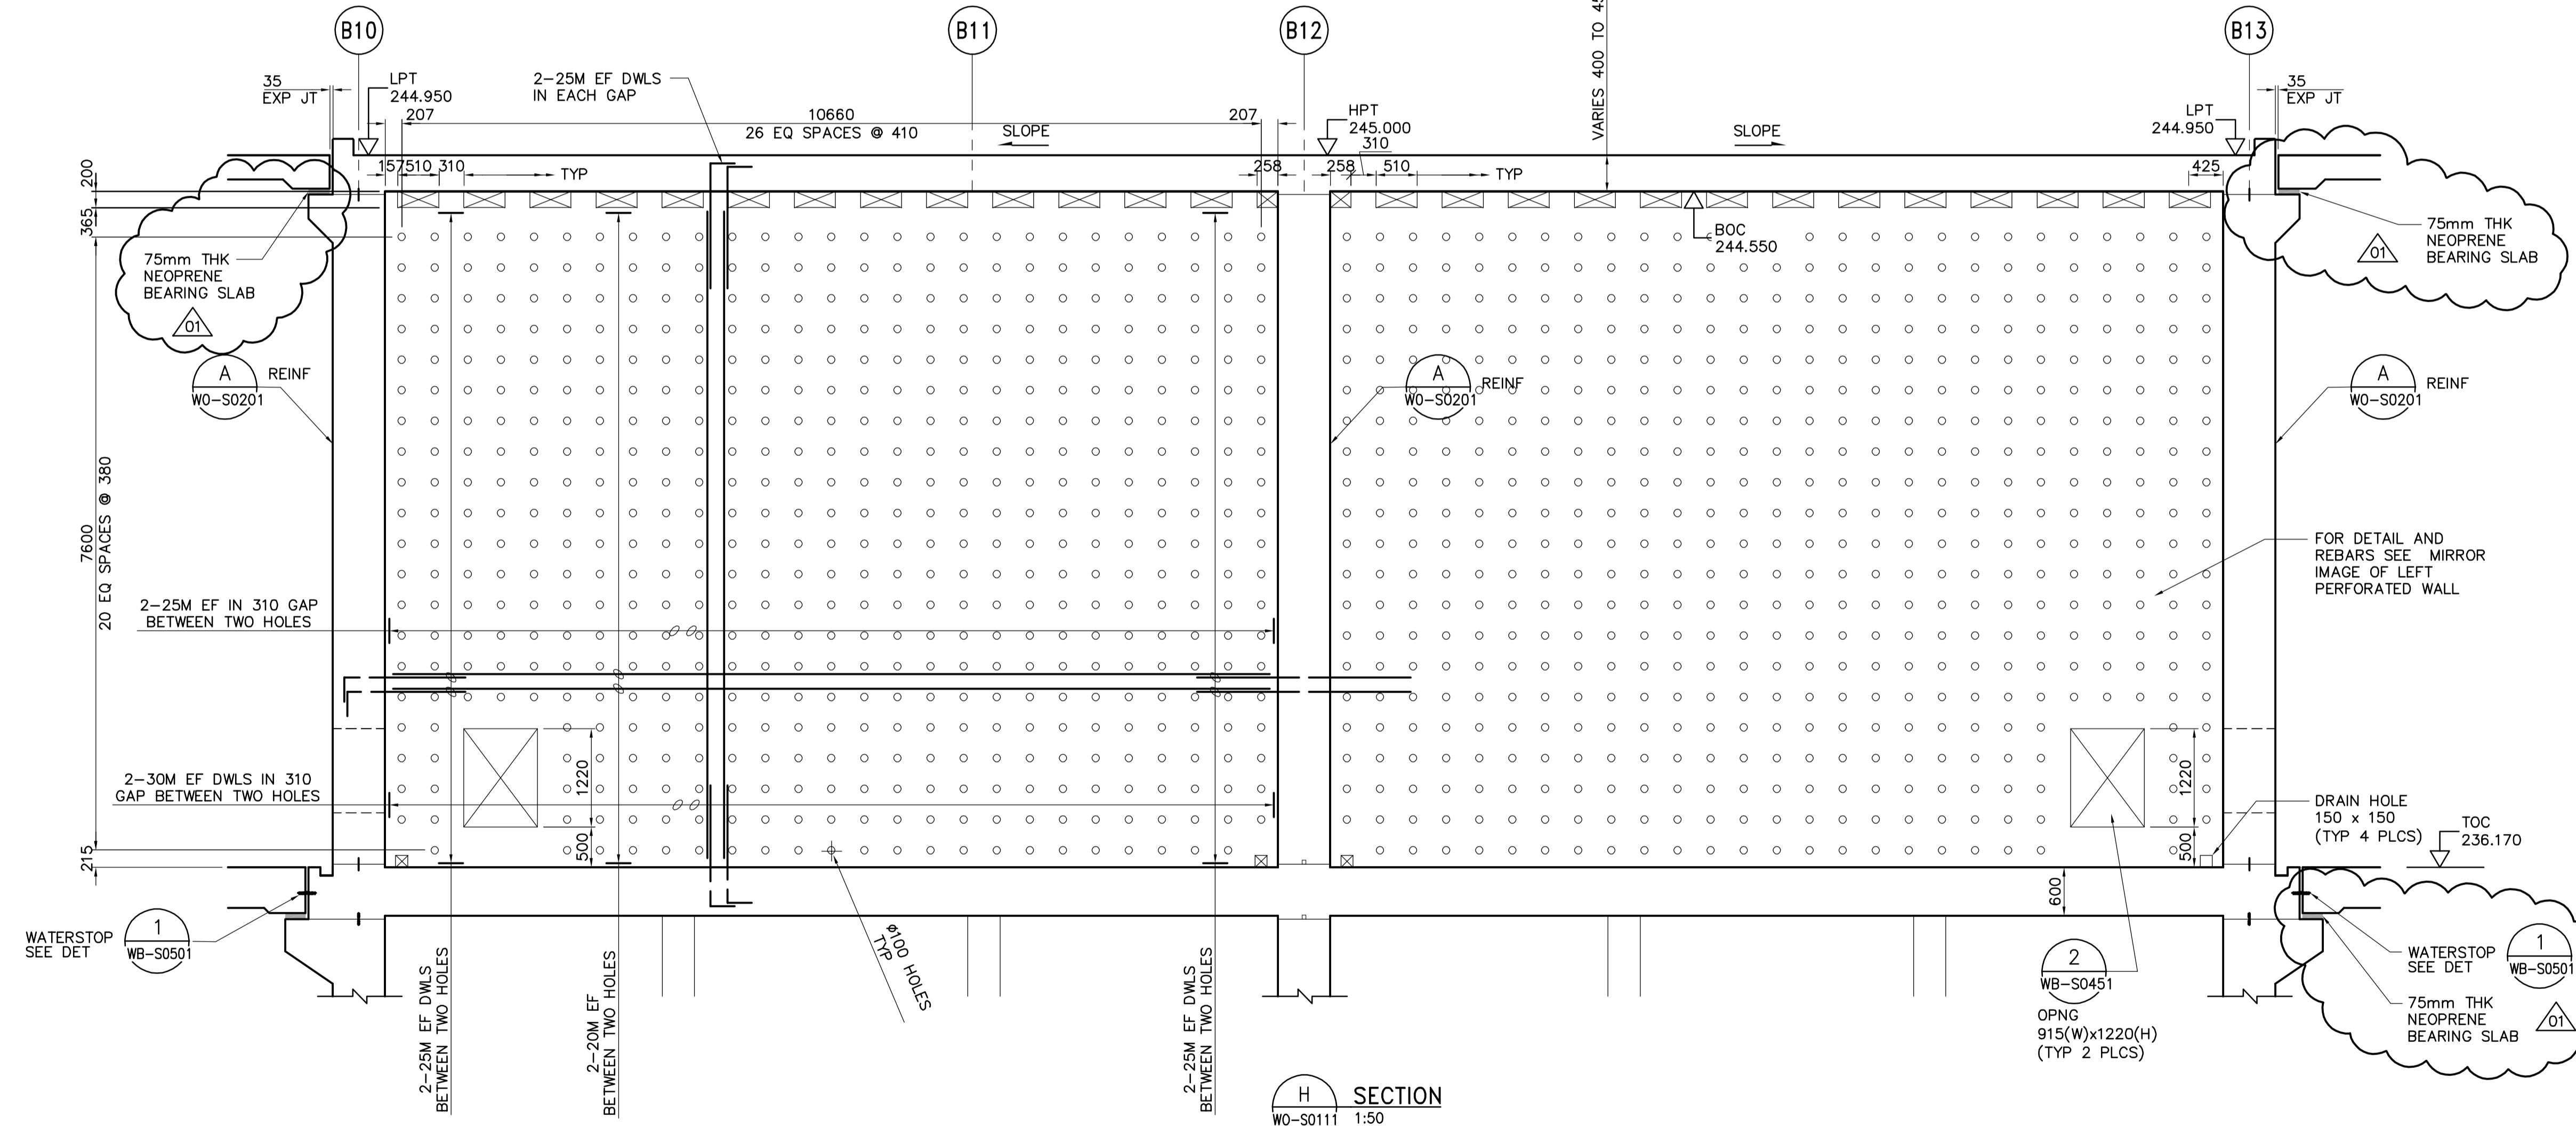

H SECTION
WO-S0111, WO-S0131
1:50

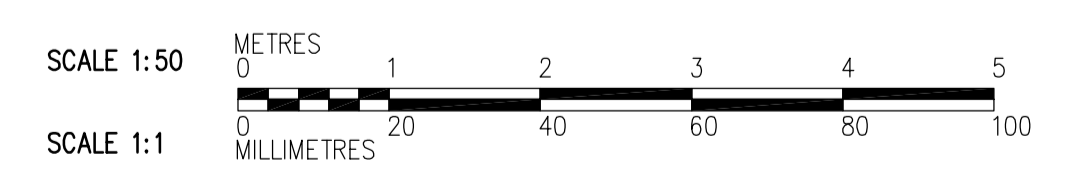

<p>Certificate of Authorization CH2M HILL Canada Ltd. No. 1441 Expiry: April 30, 2006</p>	<p>Frederickson Cooper ARCHITECTS</p>		<p>A Yoo International Ltd. Company</p>		ENGINEER'S SEAL ORIGINAL SIGNED BY D. KRUGER 2006/02/06	<p>THE CITY OF WINNIPEG WATER AND WASTE DEPARTMENT ENGINEERING DIVISION</p> <p>WATER TREATMENT PLANT OZONE FOUNDATIONS AND CONCRETE STRUCTURES</p> <p>STRUCTURAL OZONATION AREA SECTION</p>	CITY FILE NUMBER SHEET OF
	DESIGNED BY: MH CHECKED BY: AP		DRAWN BY: MS APPROVED BY: DJT		CONSULTANT DRAWING NO. WO-S0207		CITY DRAWING NUMBER 1-0600-A-0207-01-01D
	SCALE: 1:50		RELEASED FOR CONSTRUCTION BY: R. SOROKOWSKI				
	NO. REVISIONS: 01 DATE: 06/03/10 BY: MH		DATE: 2005/08/10 DATE: 2006/02/08				