
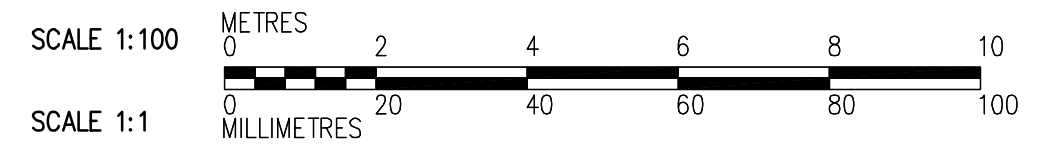


NOTES:
1. FOR BEAM AND COLUMN SCHEDULE SEE DWG WP-S015.

REBARS LEGEND:
—— TOP BARS
- - - - BOTTOM BARS

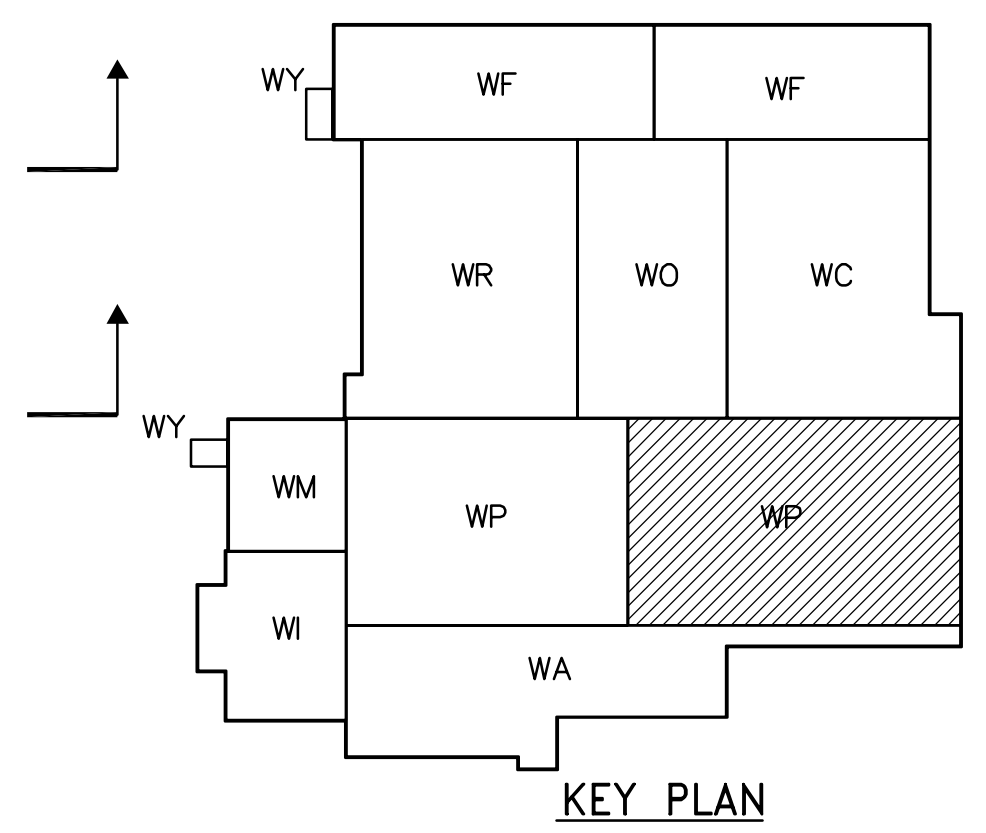

THIRD FLOOR PLAN
1:100

APECA
Certificate of Authorization
CH2M HILL Canada Ltd.
No. 1441 Expiry: April 30, 2006

B.M. ELEV.			
01	583-2005 ADDENDUM 3	06/03/10	RZ
00	ISSUED FOR TENDER	2006/02/03	RZ
NO. REVISIONS	DATE	BY	DATE
	2005/06/28		2006/02/08

CH2MHILL
Frederickson Cooper
ARCHITECTS

EarthTech
A Tyco International Ltd. Company

DESIGNED BY	RZ	CHECKED BY	AP
DRAWN BY	RL	APPROVED BY	DJT
SCALE:	1:100	RELEASED FOR CONSTRUCTION BY:	R. SOROKOWSKI
		DATE	2006/02/08

ENGINEER'S SEAL
ORIGINAL SIGNED BY
D. KRUGER
2006/02/06
CONSULTANT DRAWING NO.
WP-S0132

THE CITY OF WINNIPEG
WATER AND WASTE DEPARTMENT
ENGINEERING DIVISION

WATER TREATMENT PLANT
FLOCCULATION AND DAF
FOUNDATIONS AND CONCRETE STRUCTURES

STRUCTURAL
FLOC/DAF AREA 2
THIRD FLOOR PLAN

CITY FILE NUMBER
SHEET OF
CITY DRAWING NUMBER
1-060P-A-6082-001-0D