


INSTRUMENT LOOP DIAGRAM

LOOP NO. W795, W796, W797, W798

PROCESS AREA

SYSTEM MARSHALLING PANEL

D.C.S. – PCU 26

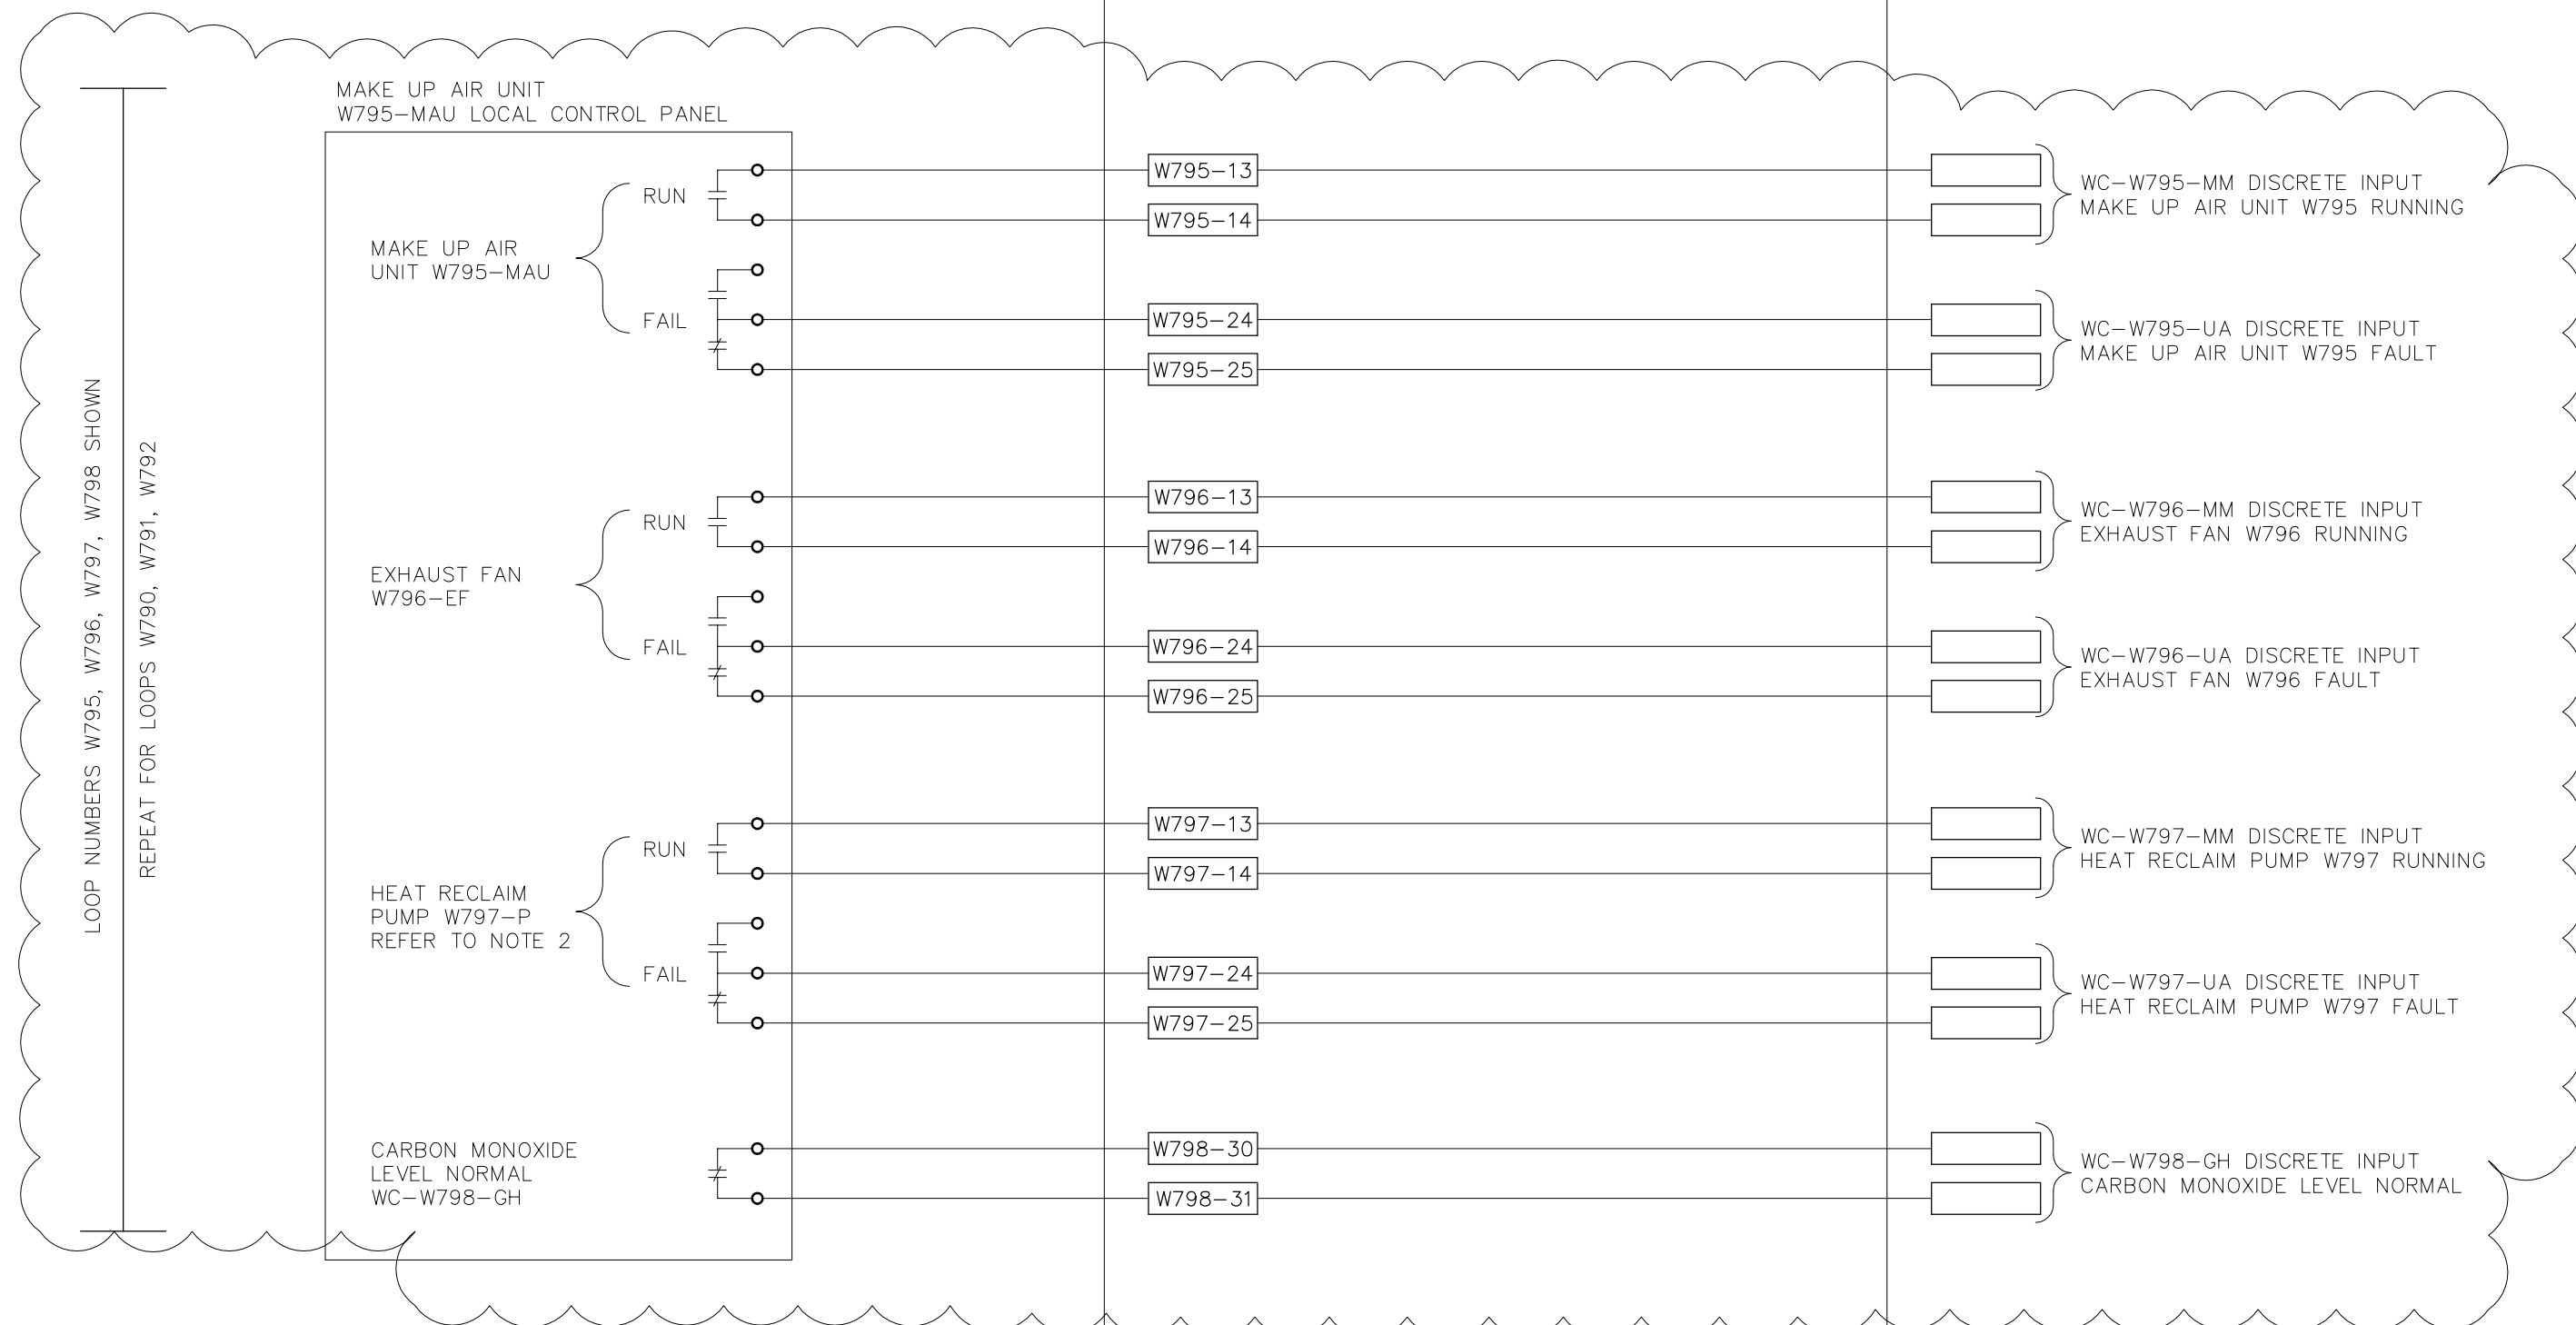

NOTE:

- CONNECT TO "NORMALLY CLOSED" CONTACTS FOR ALARMS AND "NORMALLY OPEN" CONTACTS FOR EQUIPMENT STATUS, ETC.
- HEAT RECLAIM PUMP STATUS AVAILABLE FROM W795-MAU LOCAL CONTROL PANEL ONLY.



Earth Tech (Canada) Inc. Winnipeg, Manitoba 204.477.5381

06/01/06	611-2005 ADDENDUM 1	ST
05/12/08	ISSUED FOR TENDER	ST
DATE	REVISION	APP.



THE CITY OF WINNIPEG
WATER AND WASTE DEPARTMENT

NEWPC - CENTRATE NUTRIENT TREATMENT PHOSPHORUS REMOVAL FACILITY

INSTRUMENT LOOP DIAGRAM
TYPICAL HVAC MAKE-UP AIR UNIT LOCAL CONTROL PANEL

SCALE AS NOTED
DATE 05 10 20
DES ST DWN LAE
CKD APP

DRAWING NO.
ILD-09