


SHEET: CPM-11-WW (1/2005)

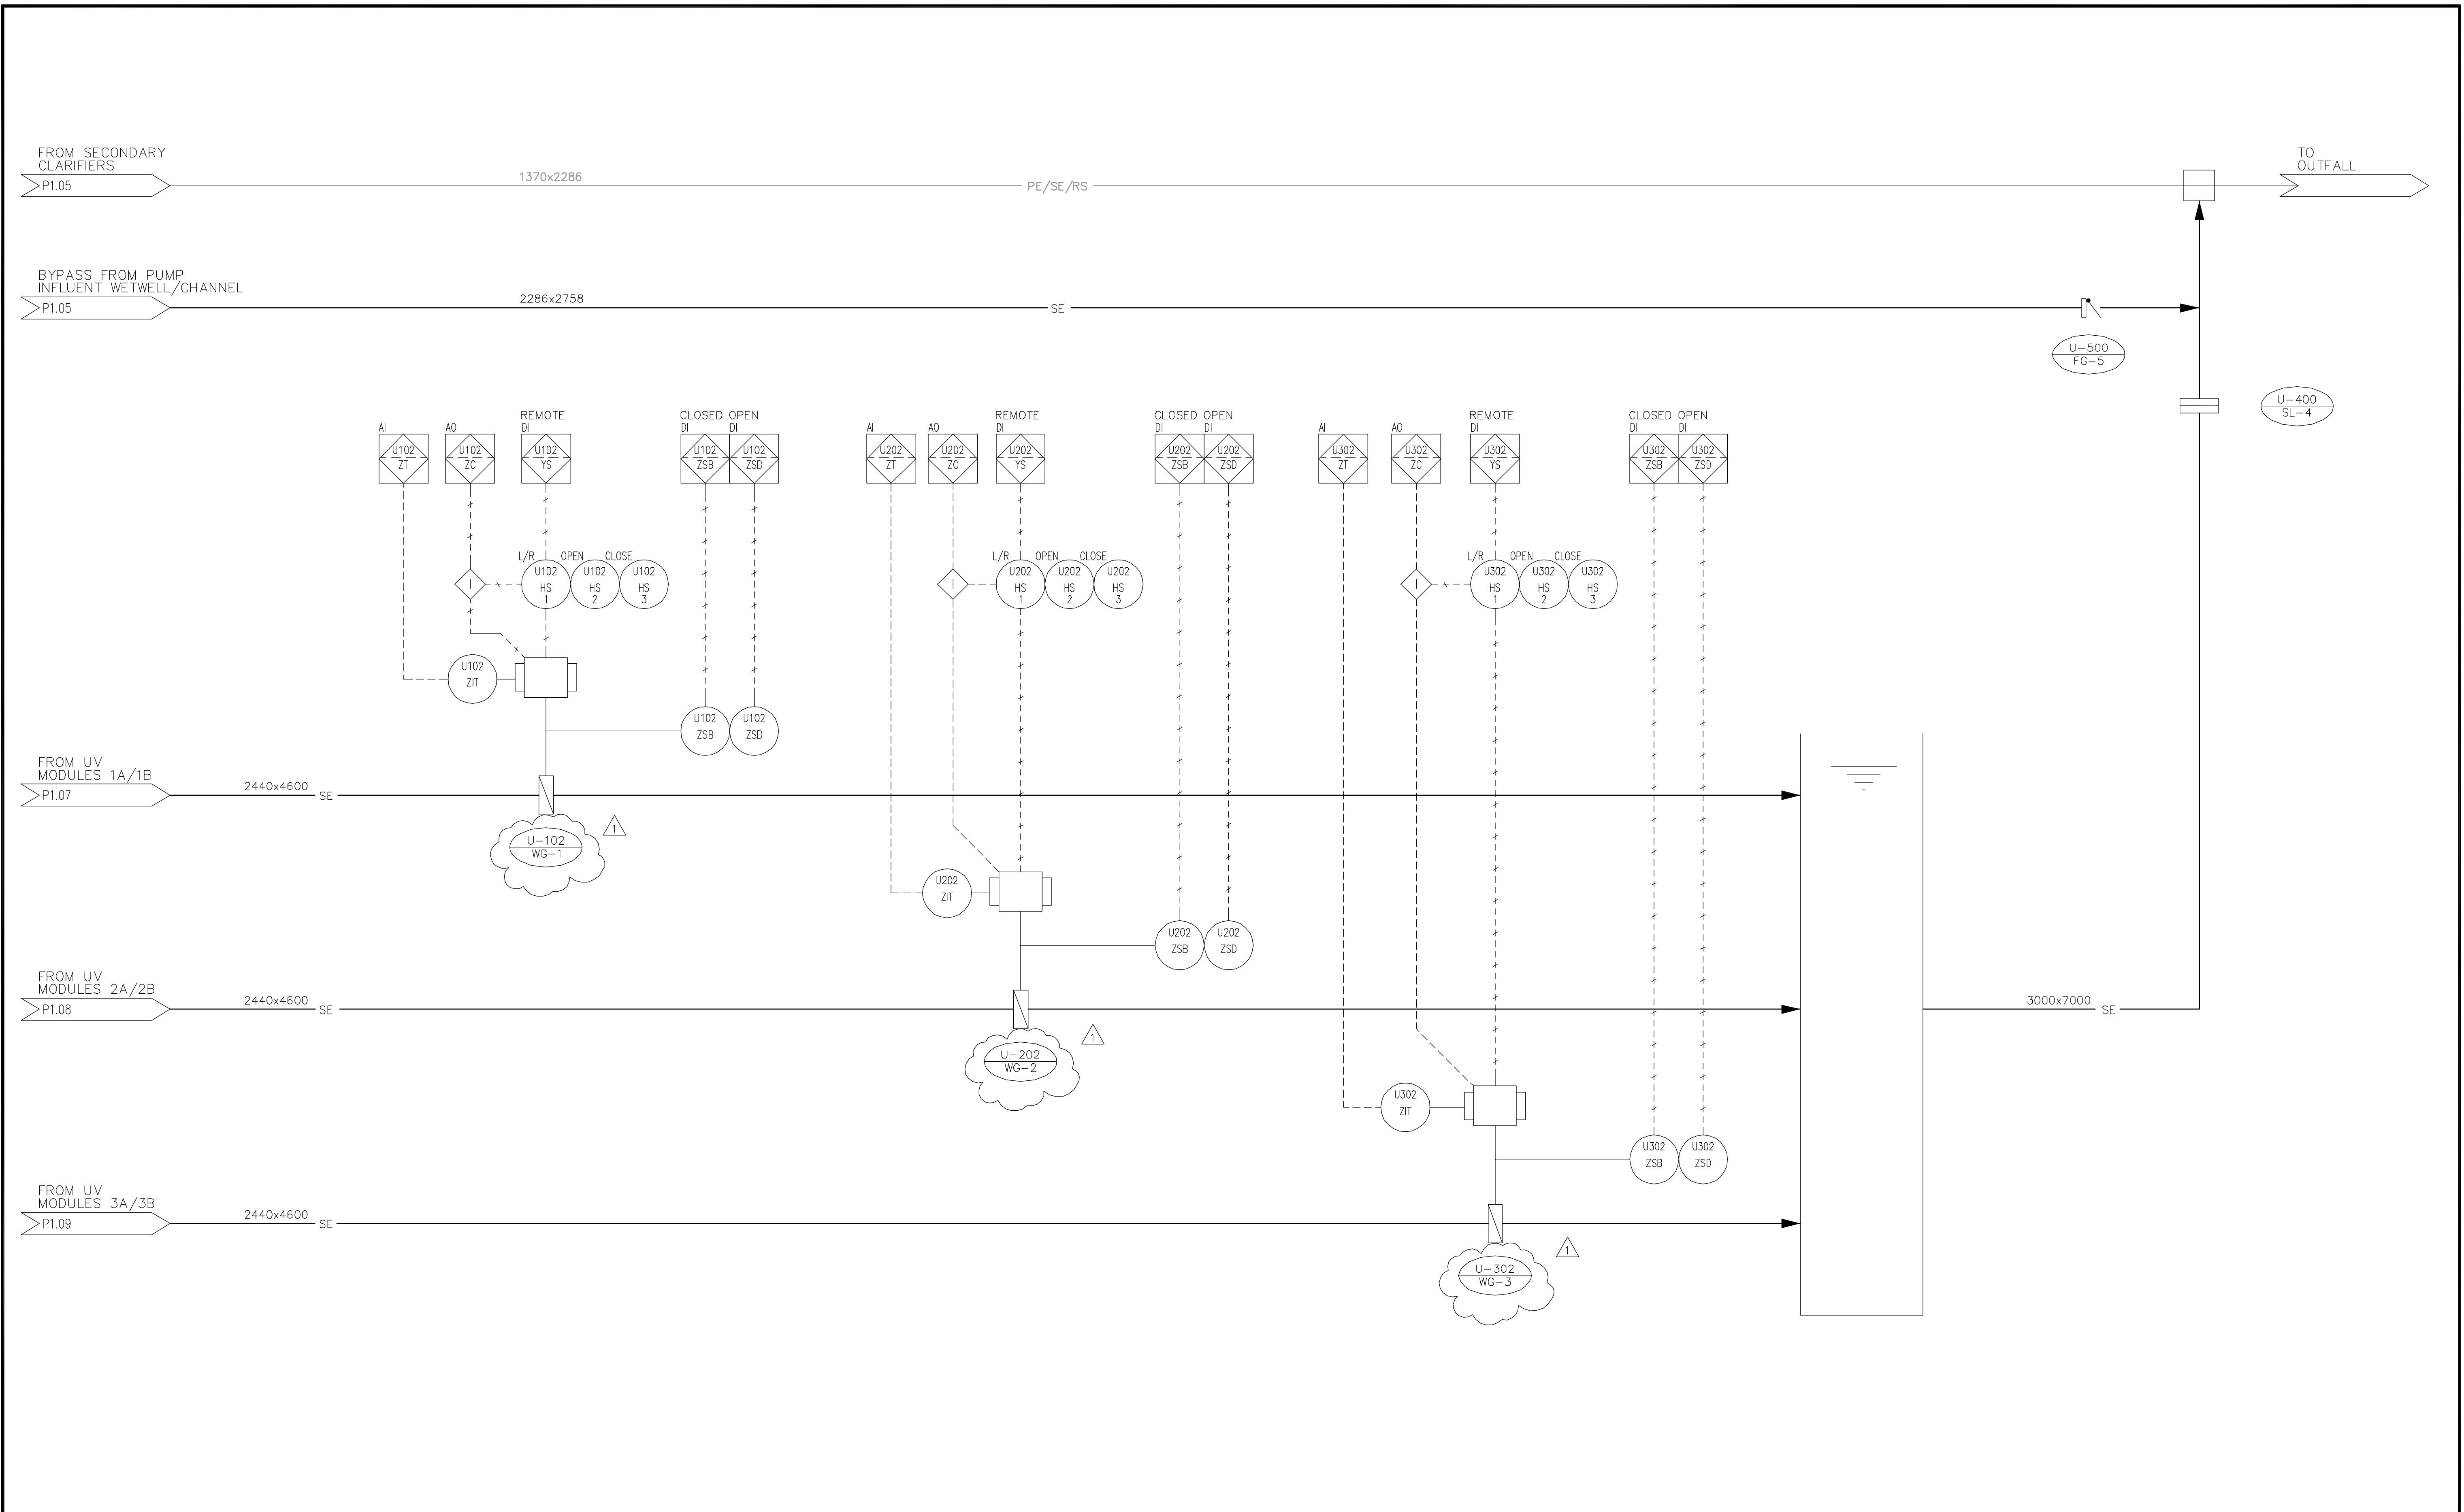

NO.	REVISIONS	DATE	BY
1	ISSUED FOR ADDENDUM 1	05/03/11	ERC
0	ISSUED FOR TENDER	05/02/18	JEH

EARTH TECH	
<small>Earth Tech (Canada) Inc. Winnipeg, Manitoba 204-477-5381</small>	
DESIGNED BY: CGL	CHECKED BY: DT
DRAWN BY: KJW	APPROVED BY: DT
HOR. SCALE:	RELEASED FOR CONSTRUCTION BY: T. KJAR TANSON
VERTICAL SCALE:	DATE: 2004/11/03
	DATE: 2005-02-18

ENGINEER'S SEAL
ORIGINAL SIGNED BY
D.J. TANIGUCHI
FEB. 18/05
CONSULTANT DRAWING NO. 66303D-CP1.10

THE CITY OF WINNIPEG
Winnipeg WATER AND WASTE DEPARTMENT

NEWPCC - SECONDARY EFFLUENT UV DISINFECTION FACILITY

PROCESS
UV EFFLUENT CHANNEL

CITY FILE NUMBER
SHEET # OF #S
CITY DRAWING NUMBER