




SHEET: CWP-43-WW (17/2005)

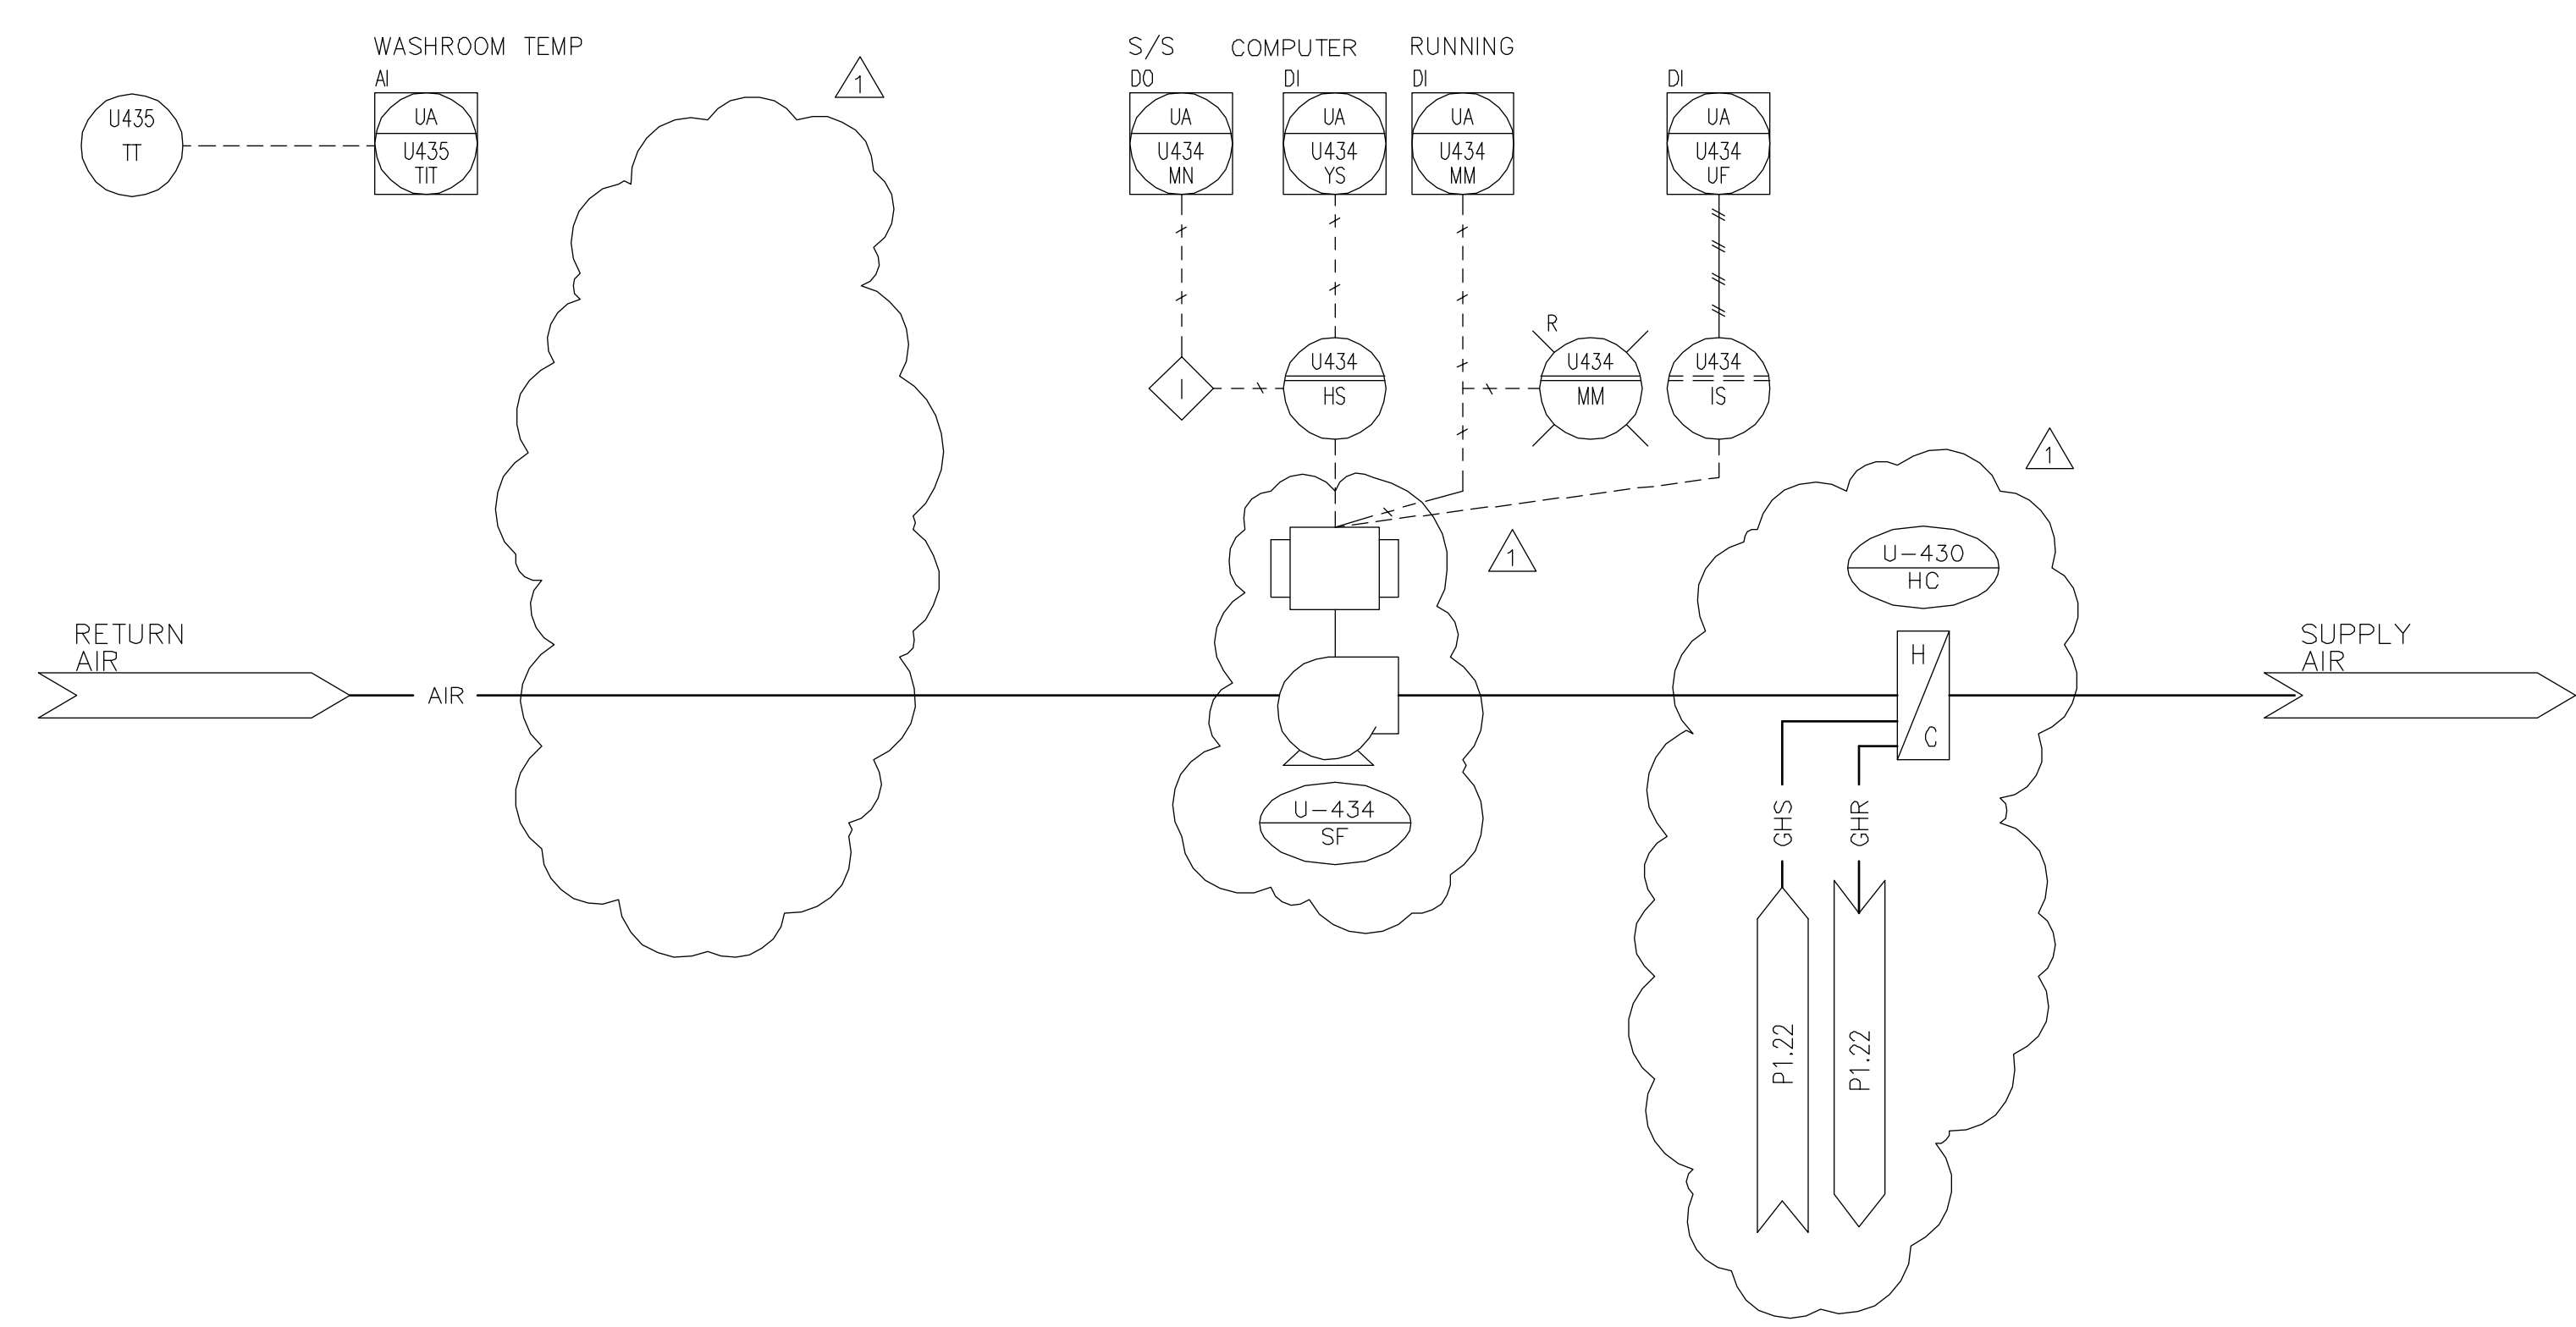

1 U-430-AHU-2  
SCALE NTS

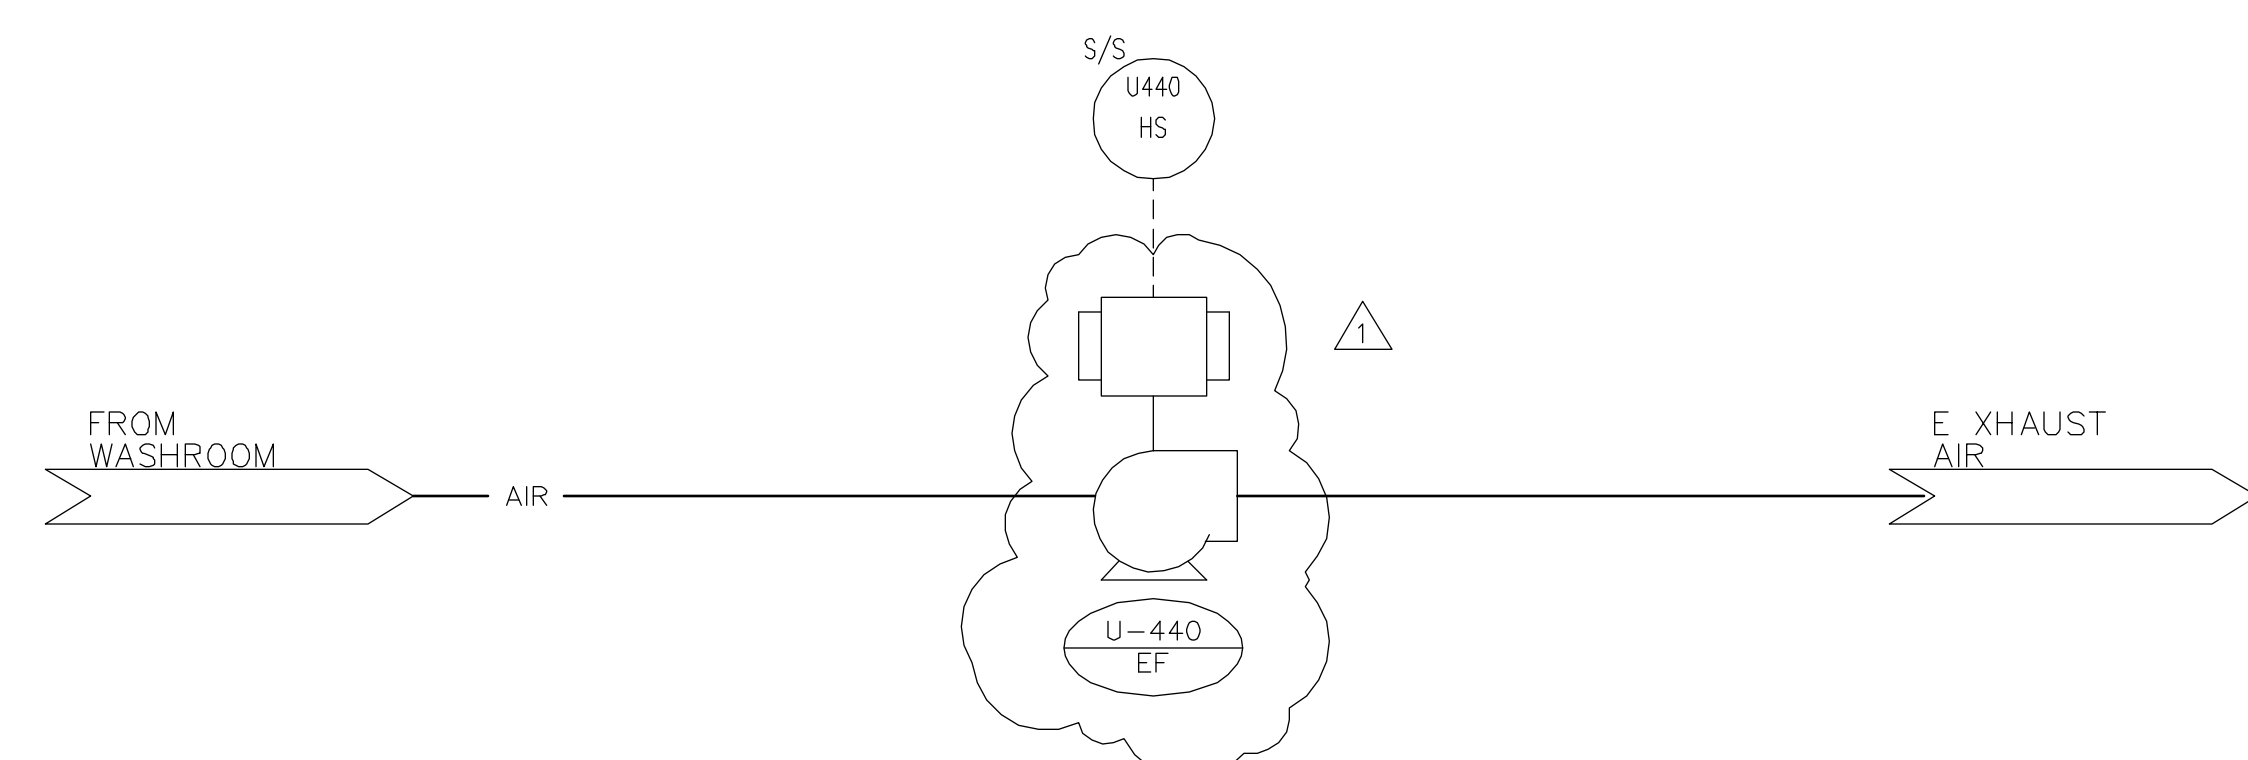

2 U-440-EF  
SCALE NTS

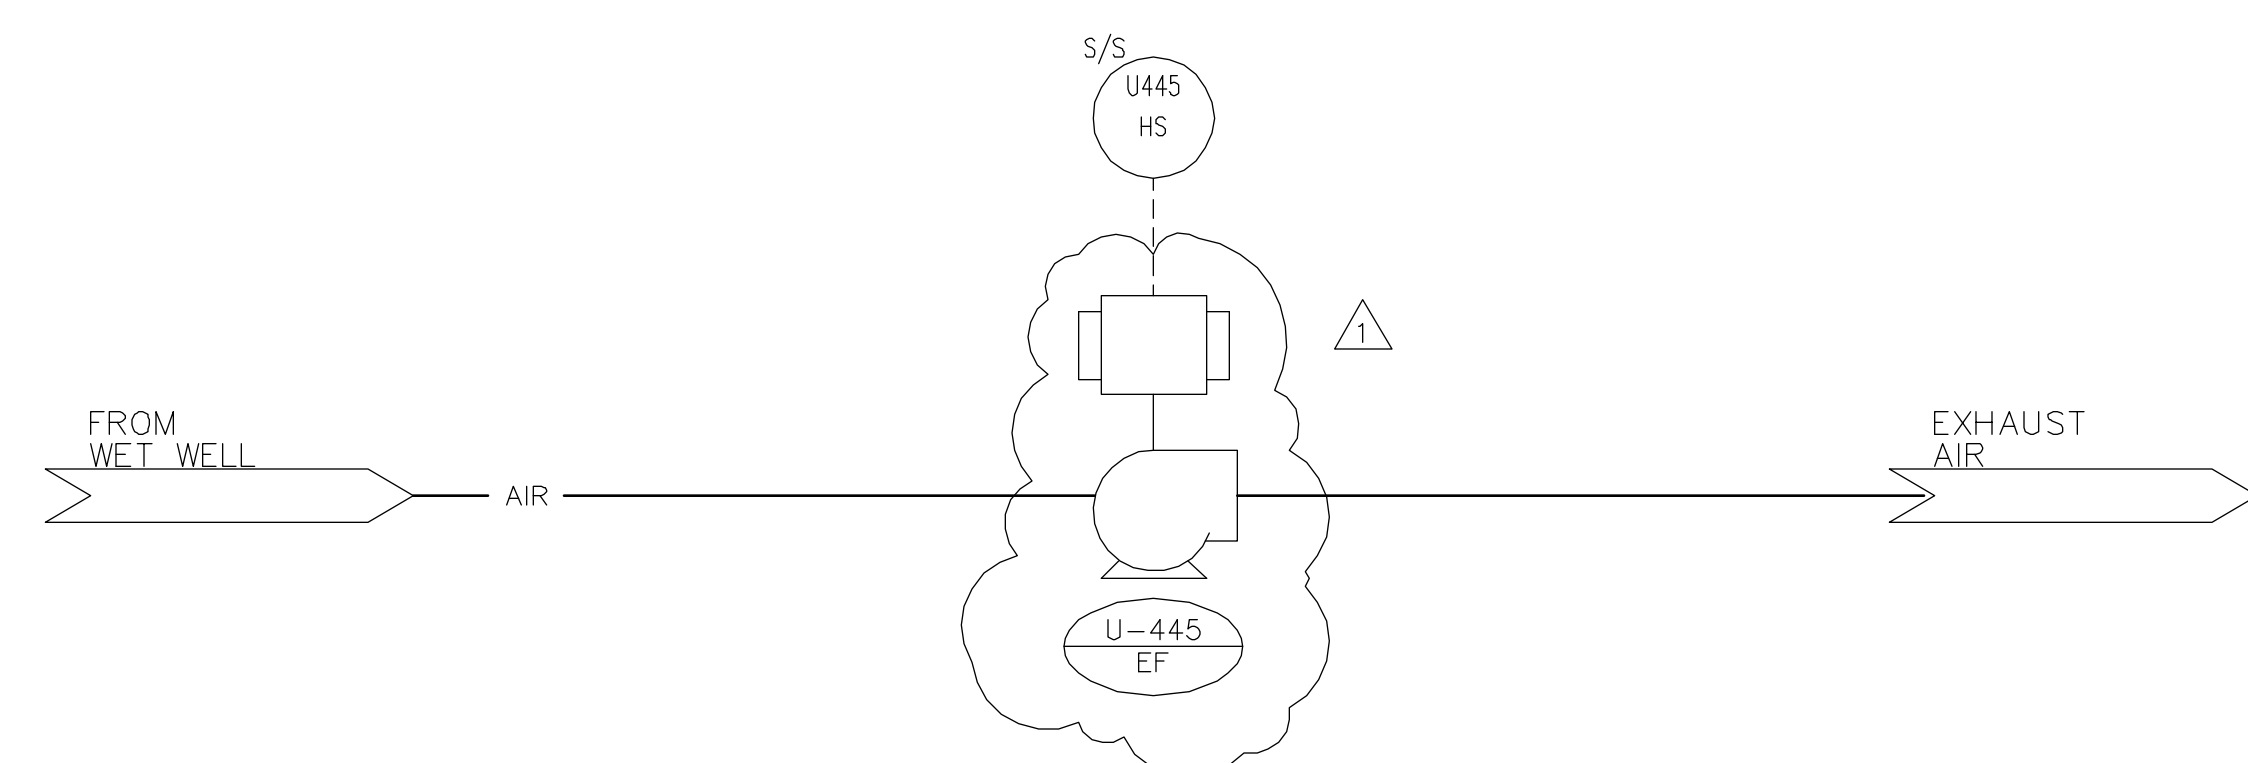

3 U-445-EF  
SCALE NTS



B.M. ELEV.			
1	ISSUED FOR ADDENDUM 1	05/03/11	ERC
0	ISSUED FOR TENDER	05/02/18	JEH
NO.	REVISIONS	DATE	BY

<b>EARTH TECH</b>			
<small>Earth Tech (Canada) Inc. Winnipeg, Manitoba 204-477-5081</small>			
DESIGNED BY	BLM	CHECKED BY	DT
DRAWN BY	ERC	APPROVED BY	DT
HOR. SCALE:		RELEASED FOR CONSTRUCTION BY:	
VERTICAL SCALE:		T. KJARTANSON	
DATE	2005/02/15	DATE	2005-02-18

ENGINEER'S SEAL
ORIGINAL SIGNED BY
P.V. LAITINEN
FEB. 18/05
CONSULTANT DRAWING NO.
66303D-CPI.16

**THE CITY OF WINNIPEG**  
Winnipeg WATER AND WASTE DEPARTMENT

**NEWPCC - SECONDARY EFFLUENT  
UV DISINFECTION FACILITY**

PROCESS  
U-430-AHU-2, U-440-EF, U-445-EF  
SHEET 1 OF 1

CITY FILE NUMBER
SHEET # OF #S
CITY DRAWING NUMBER