


SHEET: CON-AL-IND (1/2005)

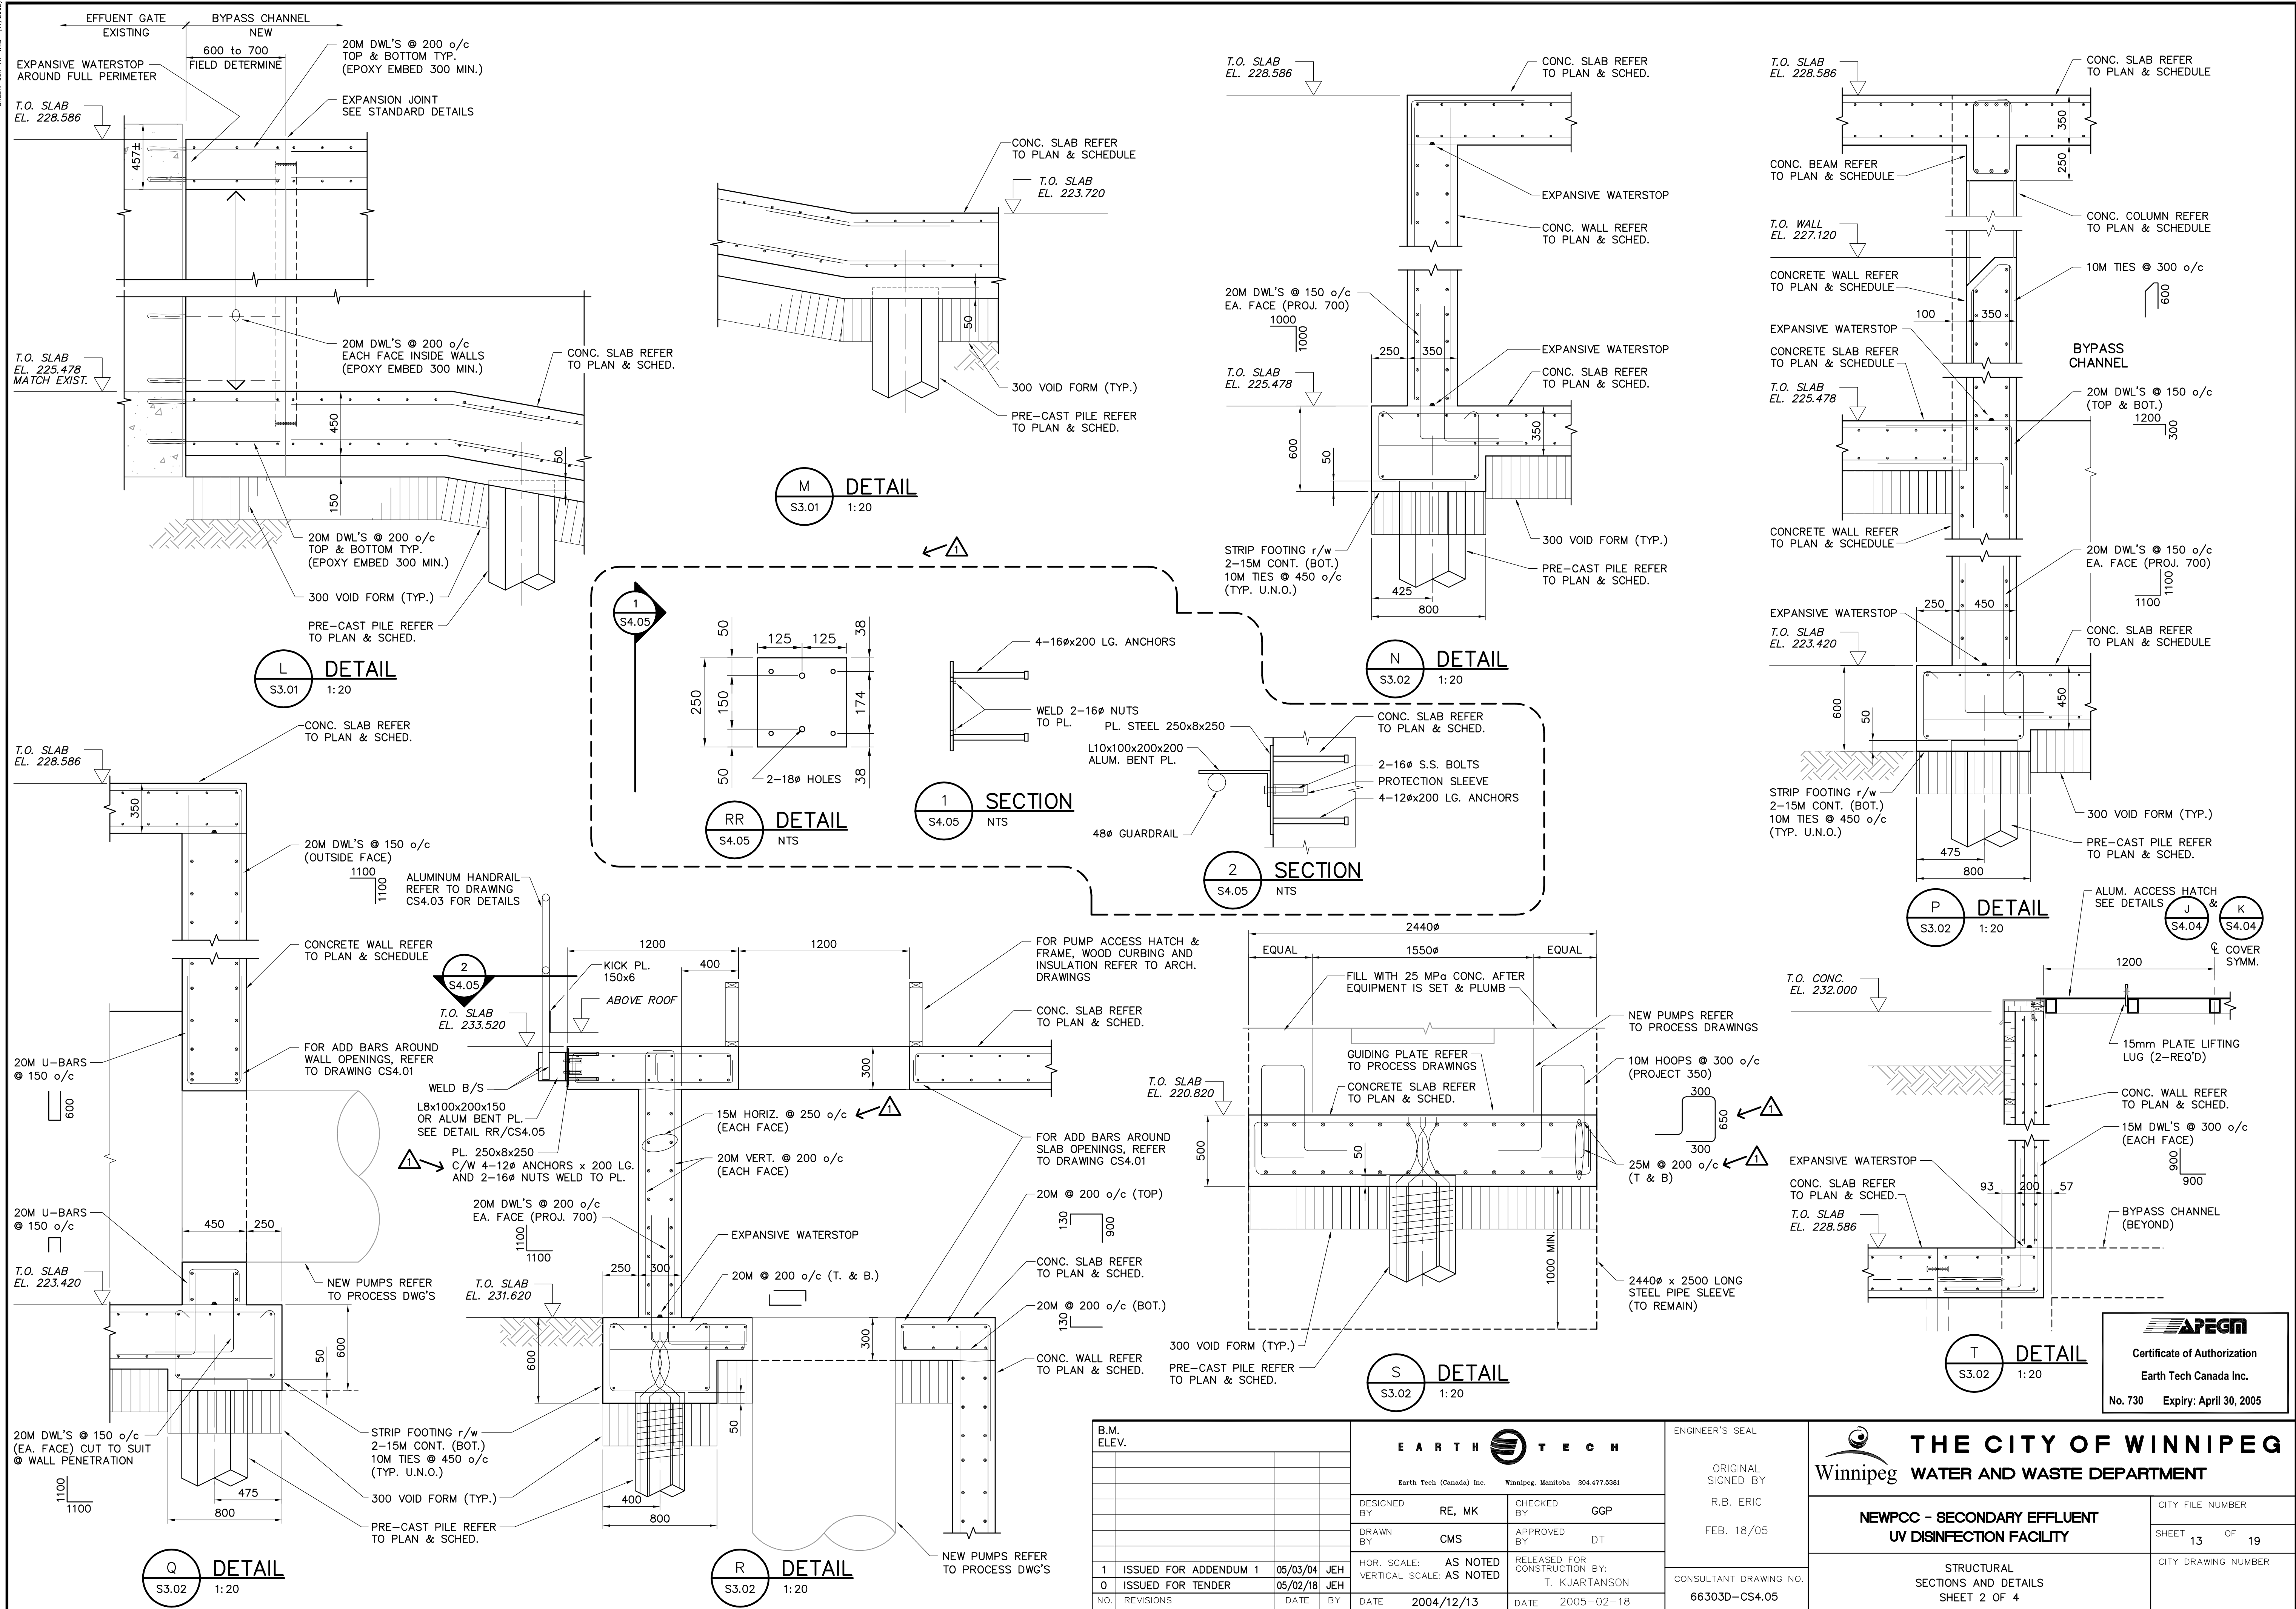

APEGM
 Certificate of Authorization
 Earth Tech Canada Inc.
 No. 730 Expiry: April 30, 2005

B.M. ELEV.	EARTH TECH Earth Tech (Canada) Inc. Winnipeg, Manitoba 204.477.5381		ENGINEER'S SEAL	THE CITY OF WINNIPEG Winnipeg WATER AND WASTE DEPARTMENT	
	DESIGNED BY RE, MK	CHECKED BY GGP	ORIGINAL SIGNED BY R.B. ERIC	CITY FILE NUMBER	
	DRAWN BY CMS	APPROVED BY DT	FEB. 18/05	SHEET 13 OF 19	
	HOR. SCALE: AS NOTED	RELEASED FOR CONSTRUCTION BY: T. KJARTANSON	CONSULTANT DRAWING NO. 66303D-CS4.05	CITY DRAWING NUMBER	
	VERTICAL SCALE: AS NOTED	DATE 2004/12/13		STRUCTURAL SECTIONS AND DETAILS SHEET 2 OF 4	
1 ISSUED FOR ADDENDUM 1	05/03/04	JEH			
0 ISSUED FOR TENDER	05/02/18	JEH			
NO. REVISIONS	DATE	BY			