

- NOTES:
- SEE MCC #2A & #2B SINGLE LINE DIAGRAM AND DP-P11 & DP-P12 POWER DISTRIBUTION FOR 600V POWER DISTRIBUTION.
 - ALL 120 AND 208V LOADS ARE FED FROM LP-P11 01

DAF TANKS NO. 5 & NO. 6

DAF TANKS NO. 7 & NO. 8



FLOCCULATION TANK 5

FLOCCULATION TANK 6

FLOCCULATION TANK 7

FLOCCULATION TANK 8

FIRST FLOOR PROCESS PLAN (AREA 2)
1:100

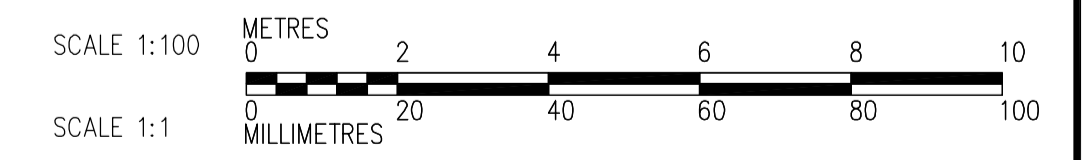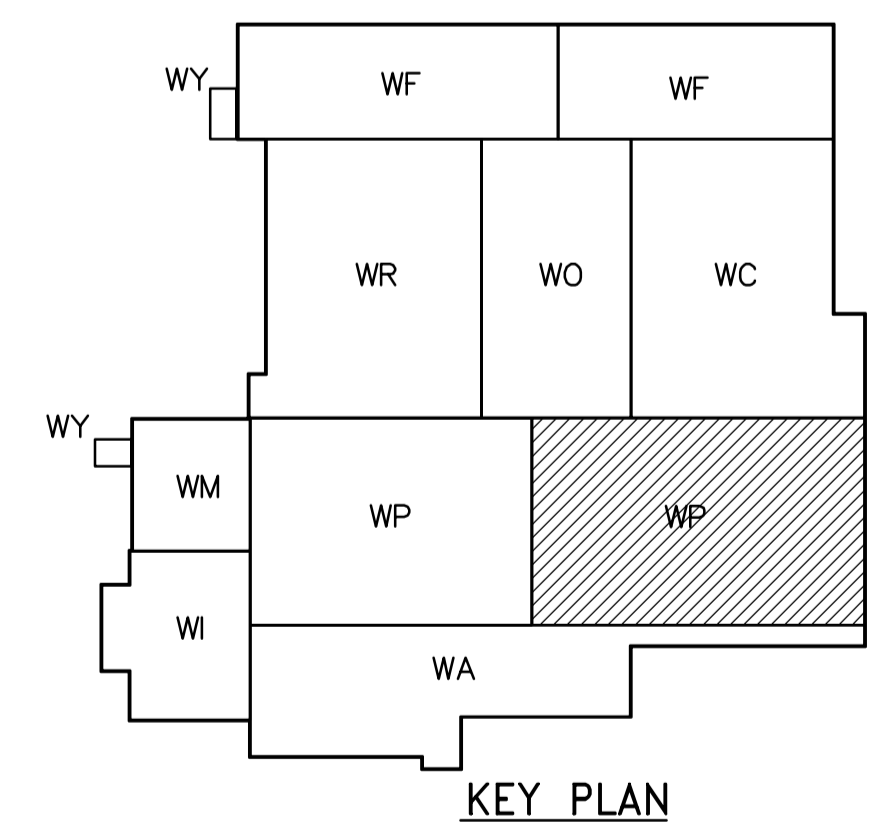

 Certificate of Authorization CH2M HILL Canada Ltd. No. 1441 Expiry: April 30, 2007	 Frederickson Cooper ARCHITECTS	 A Terra International Ltd. Company	B.M. ELEV.	ENGINEER'S SEAL ORIGINAL SIGNED BY L.D. LLEWELLYN 2006/03/29	 THE CITY OF WINNIPEG WATER AND WASTE DEPARTMENT ENGINEERING DIVISION WATER TREATMENT PLANT FLOCCULATION AND DAF MECHANICAL AND ELECTRICAL ELECTRICAL FLOC/DAF AREA 2 FIRST FLOOR PROCESS PLAN	CITY FILE NUMBER SHEET OF																	
			<table border="1" style="width: 100%; border-collapse: collapse;"> <thead> <tr> <th>NO.</th> <th>REVISIONS</th> <th>DATE</th> <th>BY</th> </tr> </thead> <tbody> <tr> <td>03</td> <td>742-2005 ADDENDUM 12</td> <td>06/06/23</td> <td>PF</td> </tr> <tr> <td>02</td> <td>742-2005 ADDENDUM 4</td> <td>06/05/12</td> <td>LL</td> </tr> <tr> <td>01</td> <td>742-2005 ADDENDUM 3</td> <td>06/05/05</td> <td>LL</td> </tr> <tr> <td>00</td> <td>ISSUED FOR TENDER</td> <td>06/03/29</td> <td>LL</td> </tr>
