SHEET: COW-A1 (05/2005)

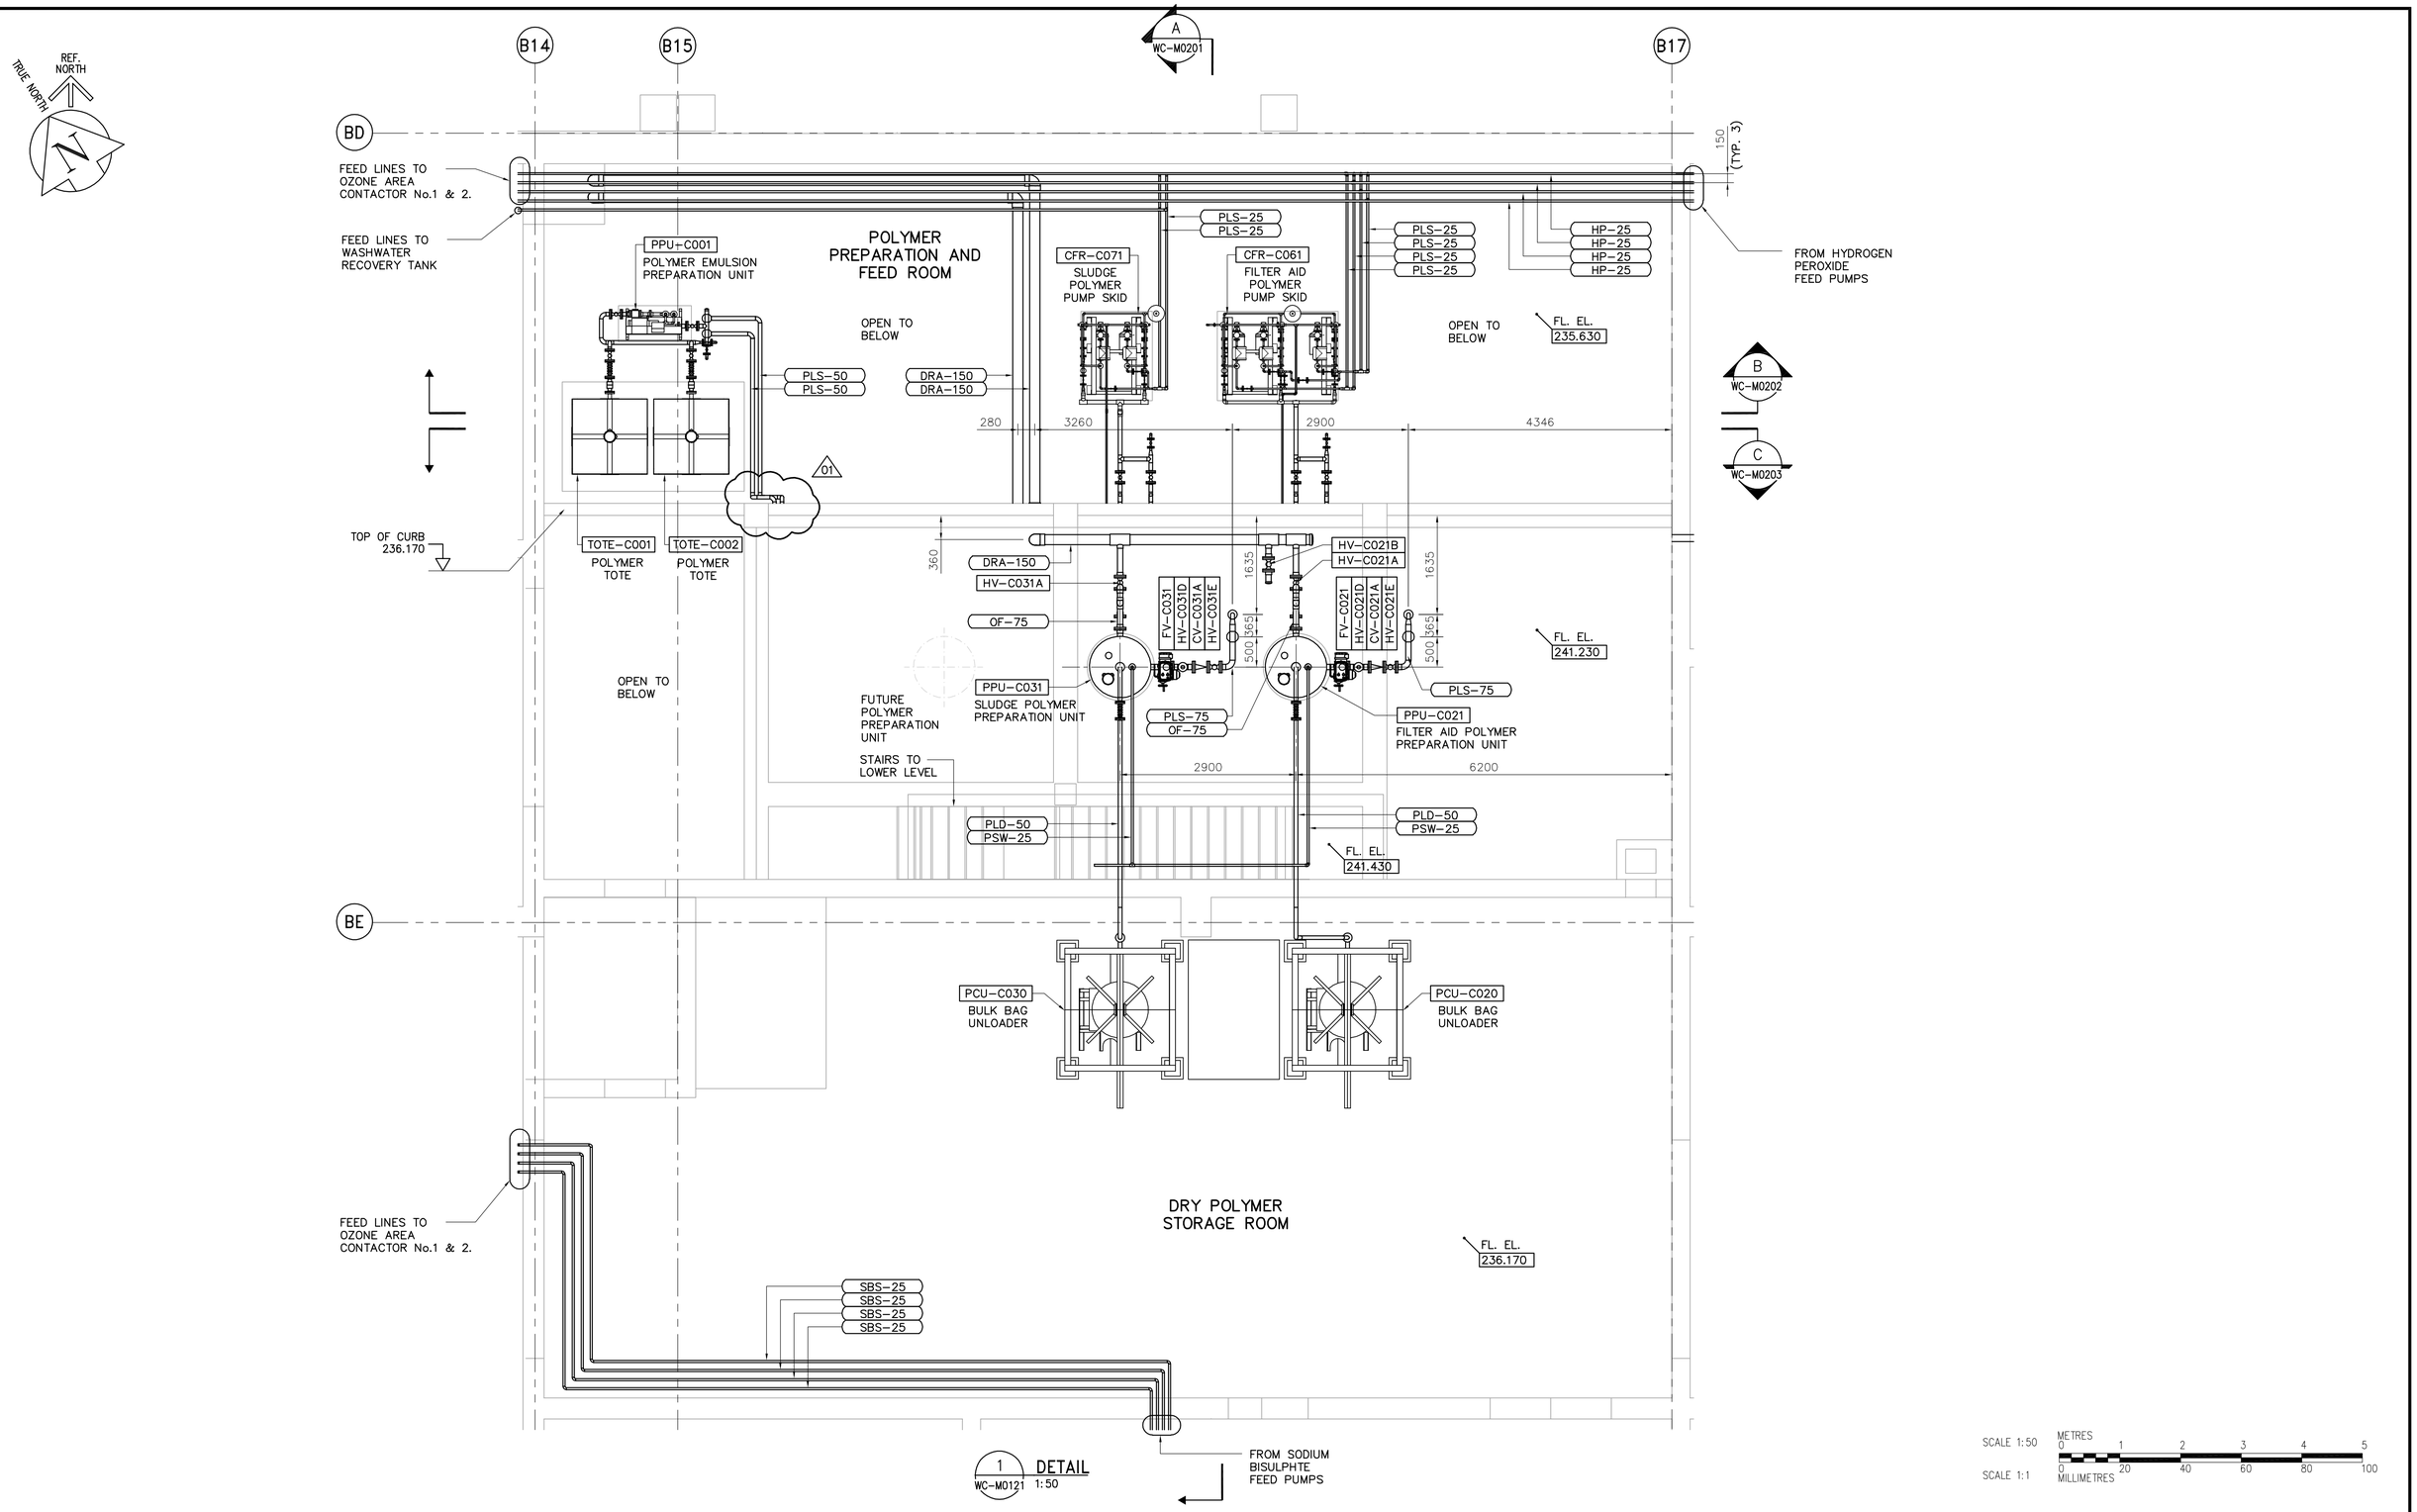

APEGM
Certificate of Authorization
CH2M HILL Canada Ltd.
No. 1441 Expiry: April 30, 2007

B.M. ELEV.

NO.	REVISIONS	DATE	BY
01	742-2005 ADDENDUM 2	06/04/28	KS
00	ISSUED FOR TENDER	06/03/29	KS

CH2MHILL
Fredericksen Cooper ARCHITECTS
EarthTech A Tyco International Ltd. Company

DESIGNED BY	KS	CHECKED BY	NW
DRAWN BY	YFS	APPROVED BY	AHL
SCALE:	1:50	RELEASED FOR CONSTRUCTION BY:	R. SOROKOWSKI
DATE	2005/05/02	DATE	2006/03/29

ENGINEER'S SEAL
ORIGINAL SIGNED BY
J.W. SINCLAIR
2006/03/29

CONSULTANT DRAWING NO.
WC-M0402

Winnipeg
THE CITY OF WINNIPEG
WATER AND WASTE DEPARTMENT
ENGINEERING DIVISION

WATER TREATMENT PLANT
CHEMICAL FEED SYSTEMS
MECHANICAL AND ELECTRICAL

PROCESS MECHANICAL
CHEMICAL AREA
PLAN DETAIL

CITY FILE NUMBER
SHEET OF
CITY DRAWING NUMBER
1-0601C-A-M0402-001-01D

Last Save: 2006-04-25 2:32 PM

C:\DOCUMENTS AND SETTINGS\SEVERITT\MY DOCUMENTS\NDMPROJ\321352 - WINNIPEGWTP\DN_WC-M0402_CH2M.DWG