SHEET: COW-A1 (05/2005)

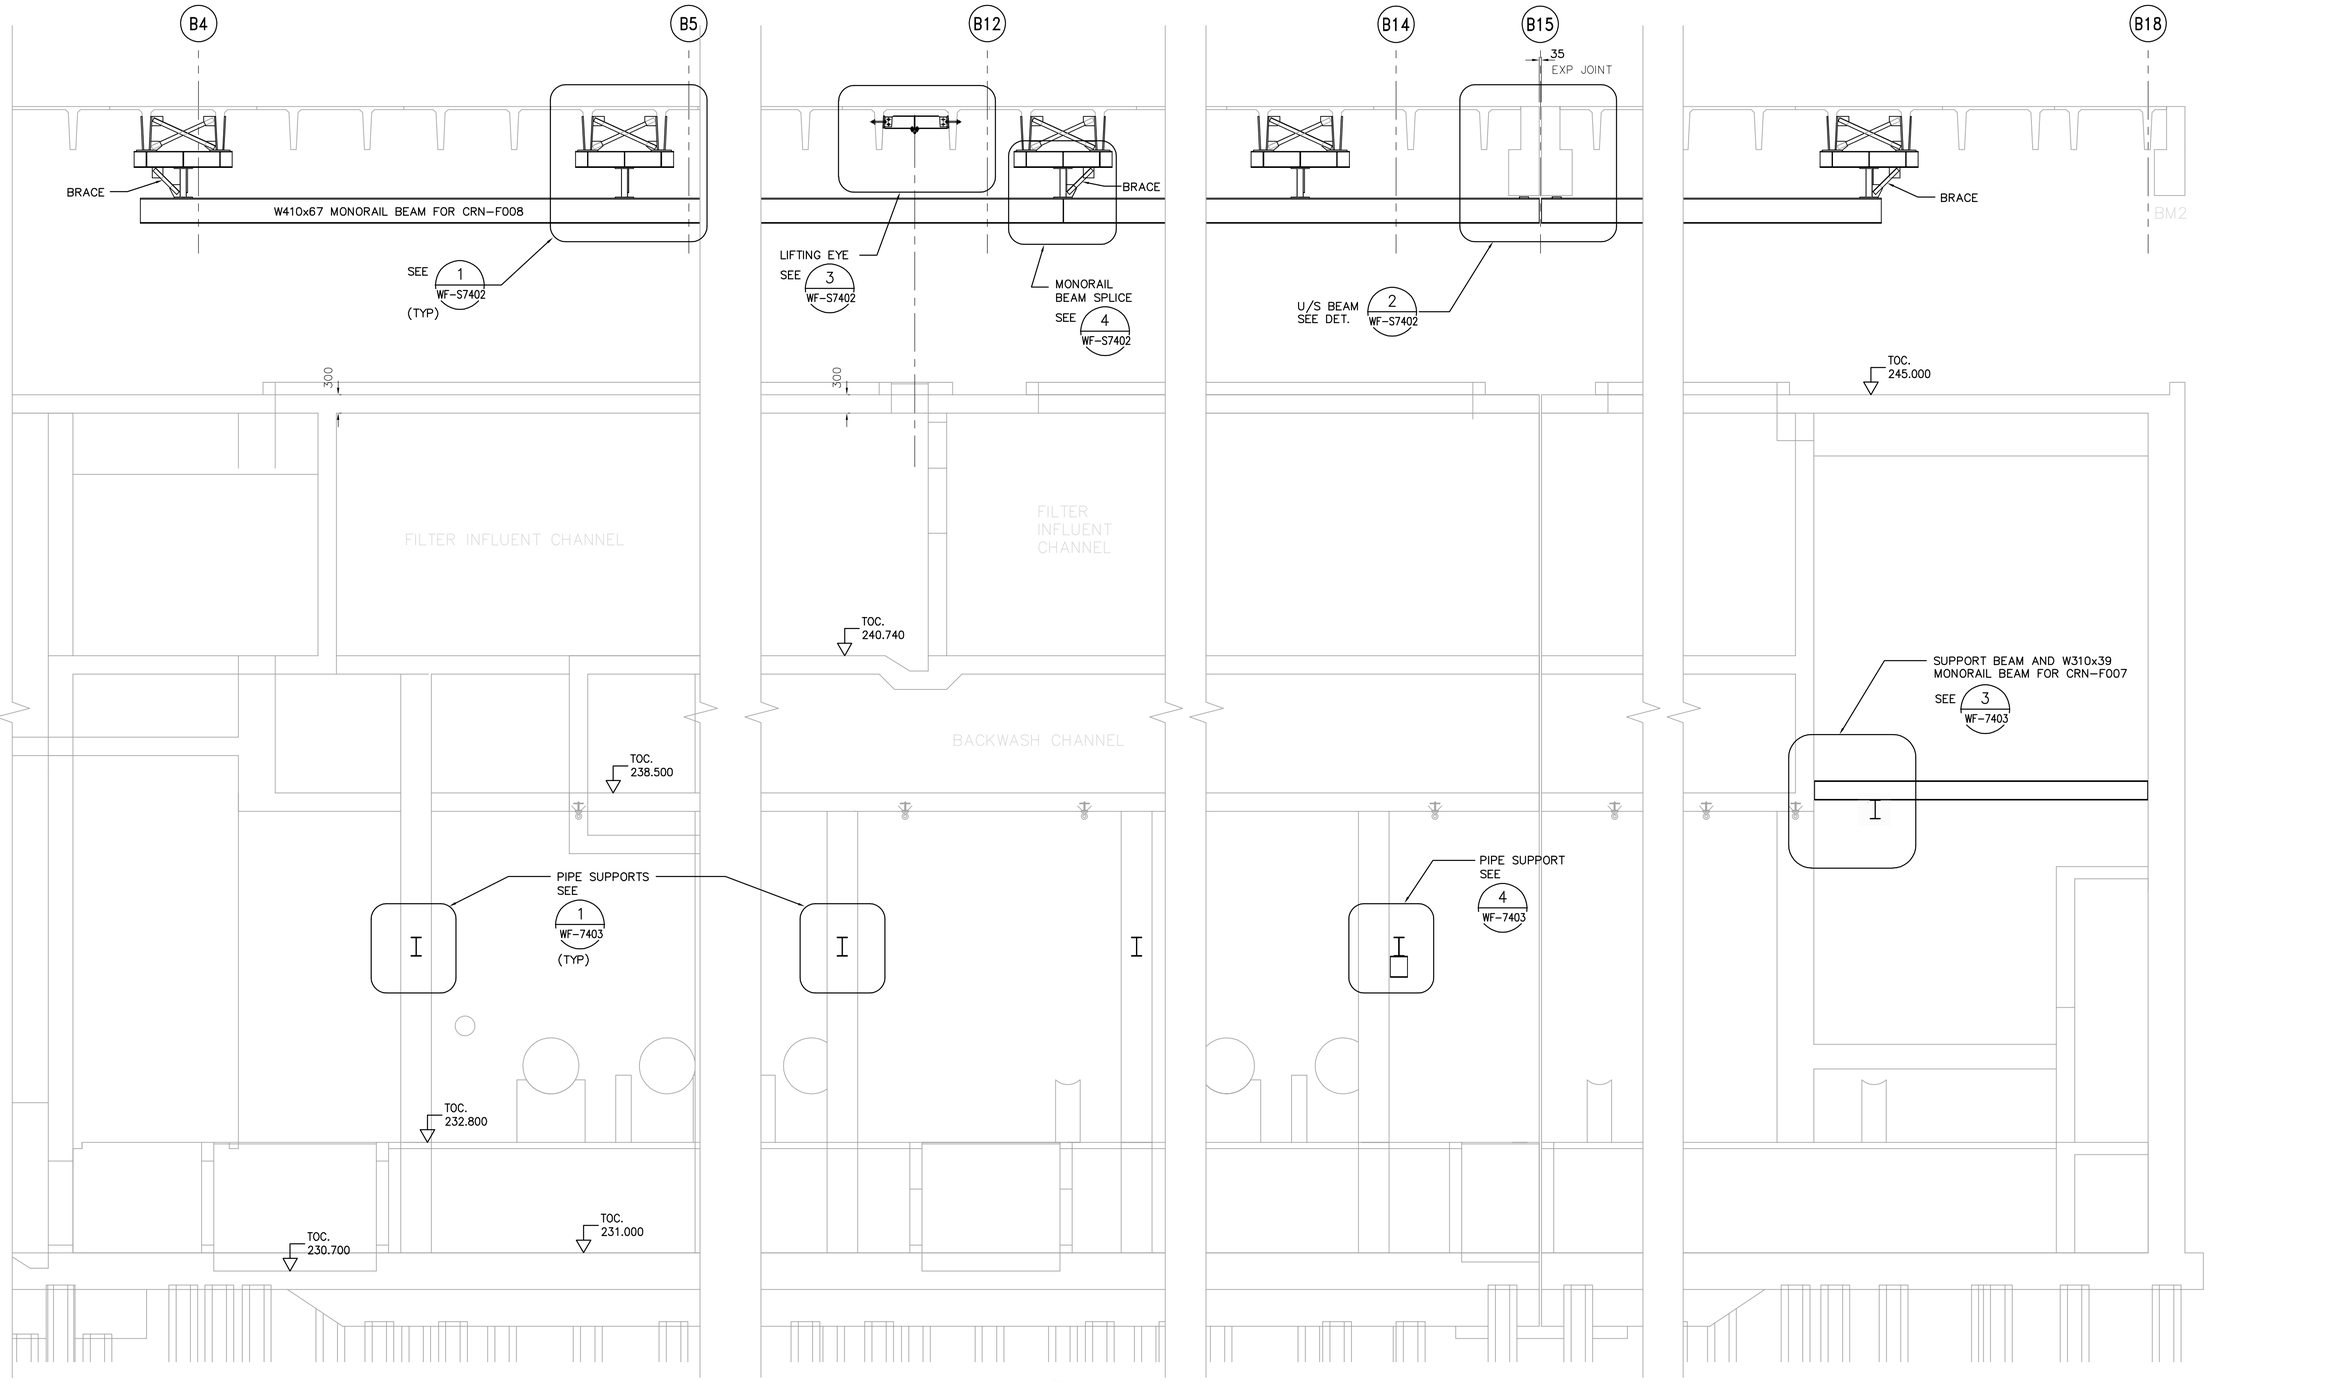

A WF-S7117 SECTION 1:50

WF-S7118
WF-S7146
WF-S7147

SCALE 1:50 METRES 0 1 2 3 4 5

SCALE 1:1 0 MILLIMETRES 20 40 60 80 100

Certificate of Authorization
CH2M HILL Canada Ltd.
No. 1441 Expiry: April 30, 2007

B.M.
ELEV.

NO.	REVISIONS	DATE	BY
00	742-2005 ADDENDUM 2	06/04/28	DK

CH2MHILL
Fredericksen Cooper ARCHITECTS
EarthTech A Tyco International Ltd. Company

DESIGNED BY	KA	CHECKED BY	AP
DRAWN BY	PM	APPROVED BY	AHL
SCALE:	1:50	RELEASED FOR CONSTRUCTION BY:	R. SOROKOWSKI
DATE	–	DATE	2006/04/28

ENGINEER'S SEAL
ORIGINAL SIGNED BY
D. KRUGER
2006/04/28

CONSULTANT DRAWING NO.
WF-S7202

Winnipeg
THE CITY OF WINNIPEG
WATER AND WASTE DEPARTMENT
ENGINEERING DIVISION

WATER TREATMENT PLANT
FILTRATION
MECHANICAL AND ELECTRICAL

CITY FILE NUMBER
SHEET OF

STRUCTURAL
FILTRATION AREA
SECTION

CITY DRAWING NUMBER
1-0601F-A-S0202-001-00D

Last Save: 2006-04-26 8:37 AM

C:\DOCUMENTS AND SETTINGS\SEVERITT\MY DOCUMENTS\NDMPROJ\321352 – WINNIPEGWTP\DN_WF-S7202_CH2M.DWG