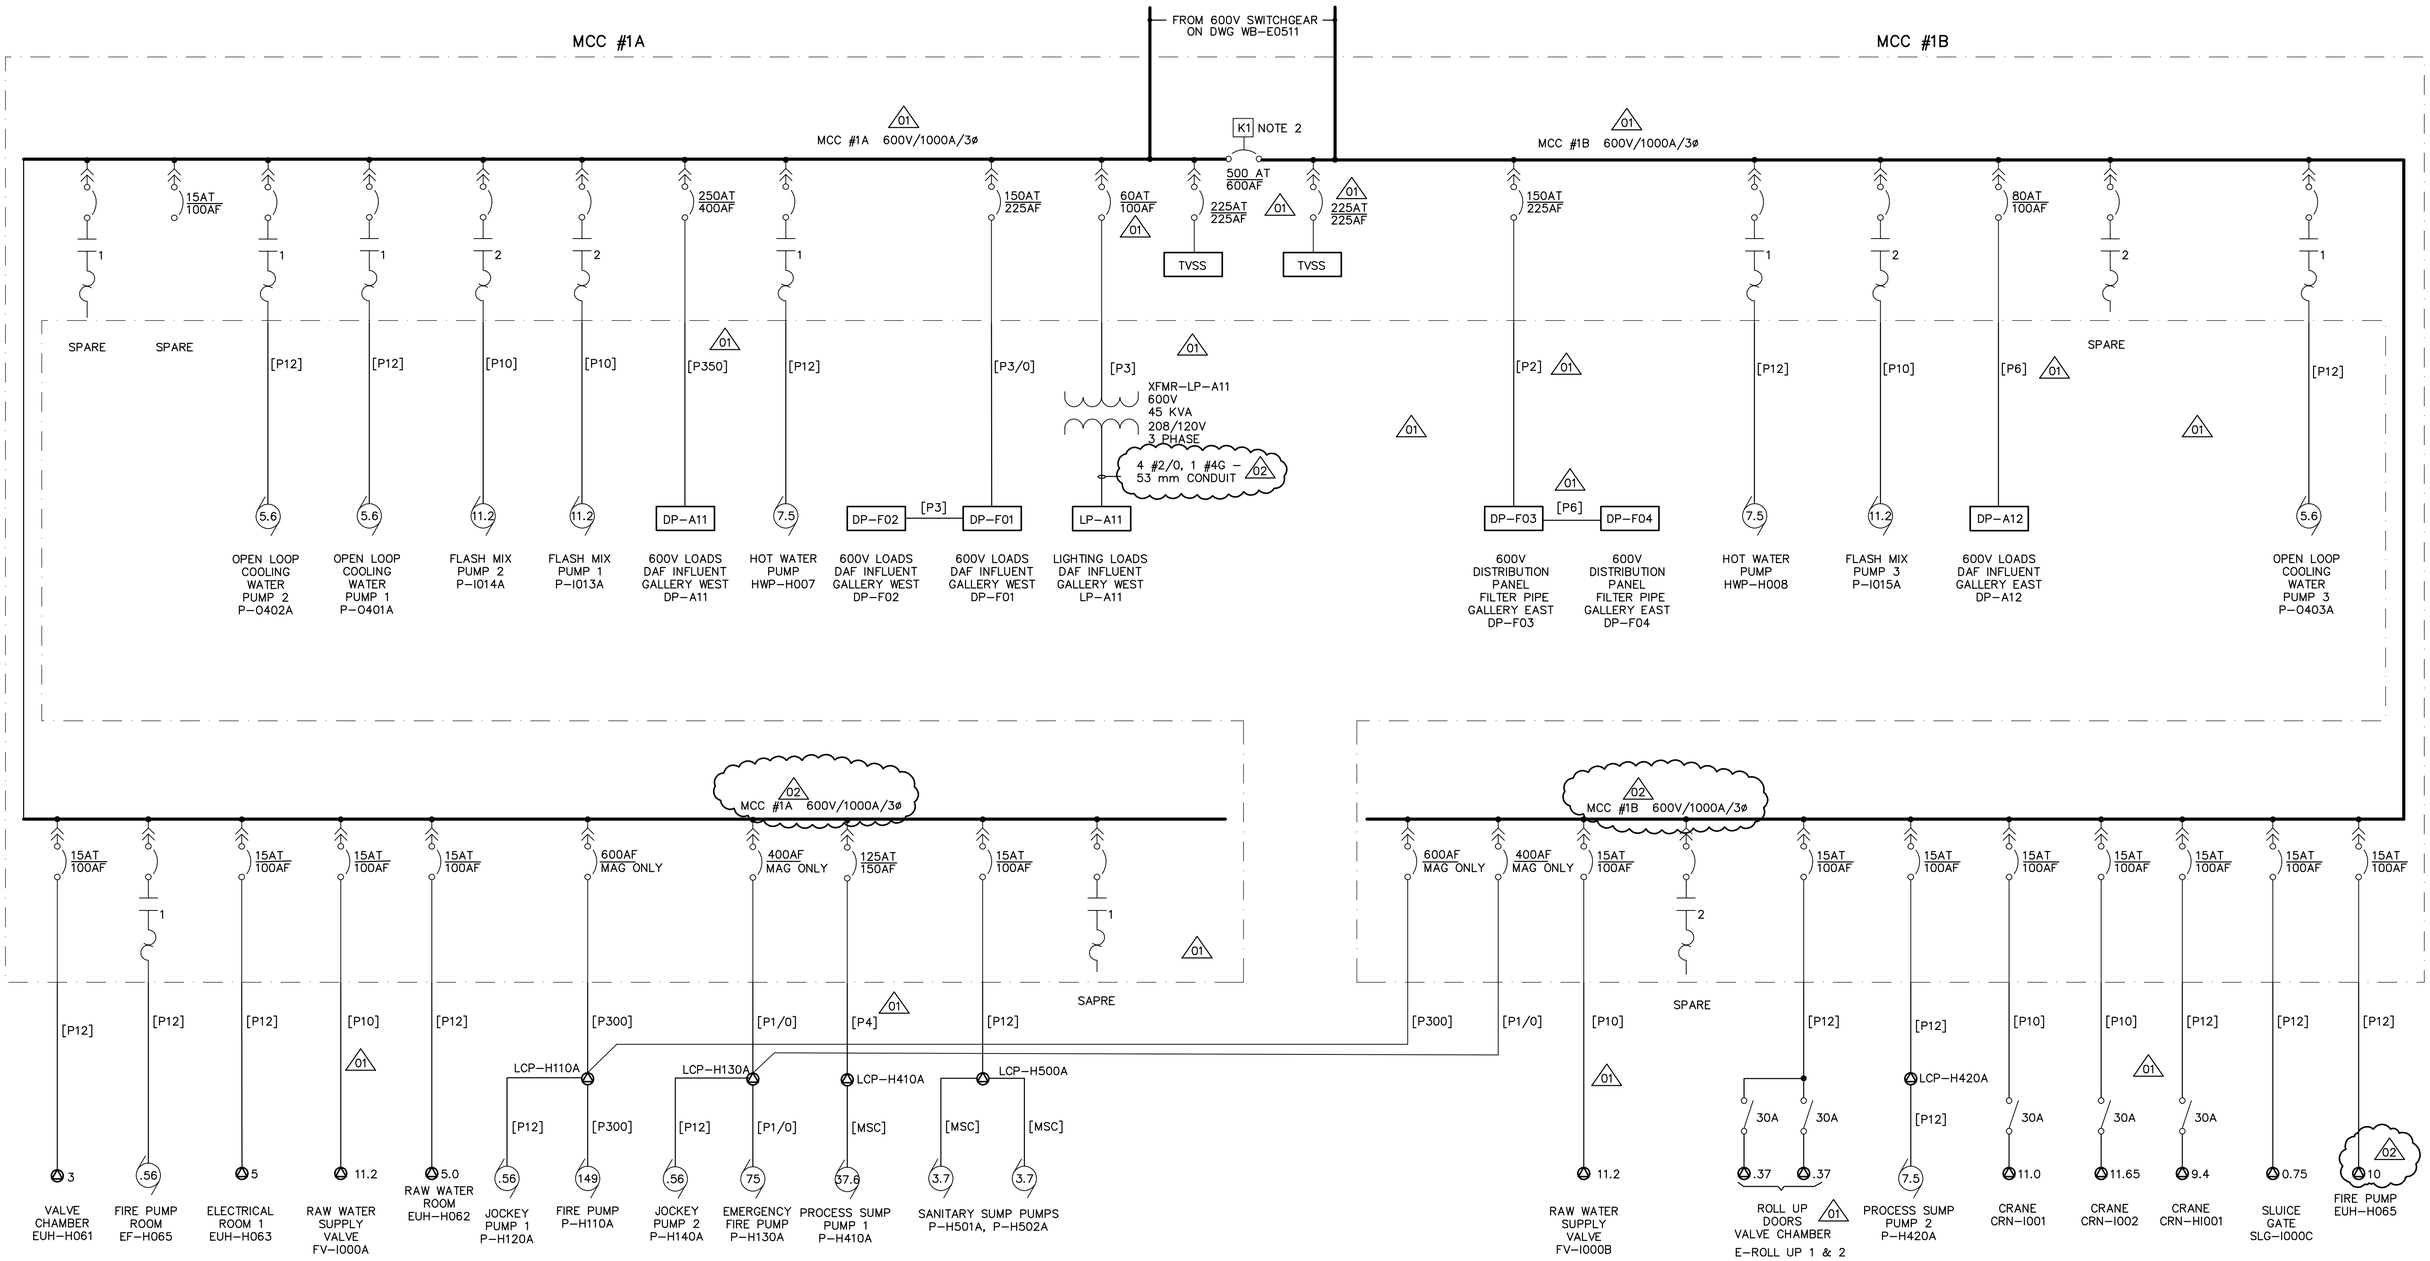

MCC #1A, #1B SINGLE LINE DIAGRAM

NOTES:
1. ALL POWER REQUIREMENTS ARE IN kW.
2. FOR KEY INTERLOCK SCHEME SEE DRAWING WB-E0511.
3. FOR MCC #1A, #1B ELEVATION SEE DRAWING WB-E0514.

APEGM
Certificate of Authorization
CH2M HILL Canada Ltd.
No. 1441 Expiry: April 30, 2007

B.M. ELEV.

NO.	REVISIONS	DATE	BY
02	742-2005 ADDENDUM 4	06/05/12	LL
01	742-2005 ADDENDUM 3	06/05/05	LL
00	ISSUED FOR TENDER	06/03/29	LL

CH2MHILL
Frederickson Cooper ARCHITECTS
EarthTech A Tyco International Ltd. Company

DESIGNED BY	JT	CHECKED BY	ND
DRAWN BY	KJ	APPROVED BY	AHL
SCALE:	NTS	RELEASED FOR CONSTRUCTION BY:	R. SOROKOWSKI
DATE	2005/06/29	DATE	2006/03/29

ENGINEER'S SEAL
ORIGINAL SIGNED BY
L.D. LLEWELLYN
2006/03/29

CONSULTANT DRAWING NO.
WB-E0512

Winnipeg
THE CITY OF WINNIPEG
WATER AND WASTE DEPARTMENT
ENGINEERING DIVISION

WATER TREATMENT PLANT
MAIN BUILDING
MECHANICAL AND ELECTRICAL

ELECTRICAL

600V SIINGLE LINE DIAGRAM

CITY FILE NUMBER
SHEET OF
CITY DRAWING NUMBER
1-0601B-F-E0512-001-02D

Last Save: 2006-05-10 1:35 PM
P:\EARTHTECH\321352WINNIPEGWTP\NDM\DESIGN\ACAD\742-POSTTENDER\DN_WB-E0512_CH2M.DWG