

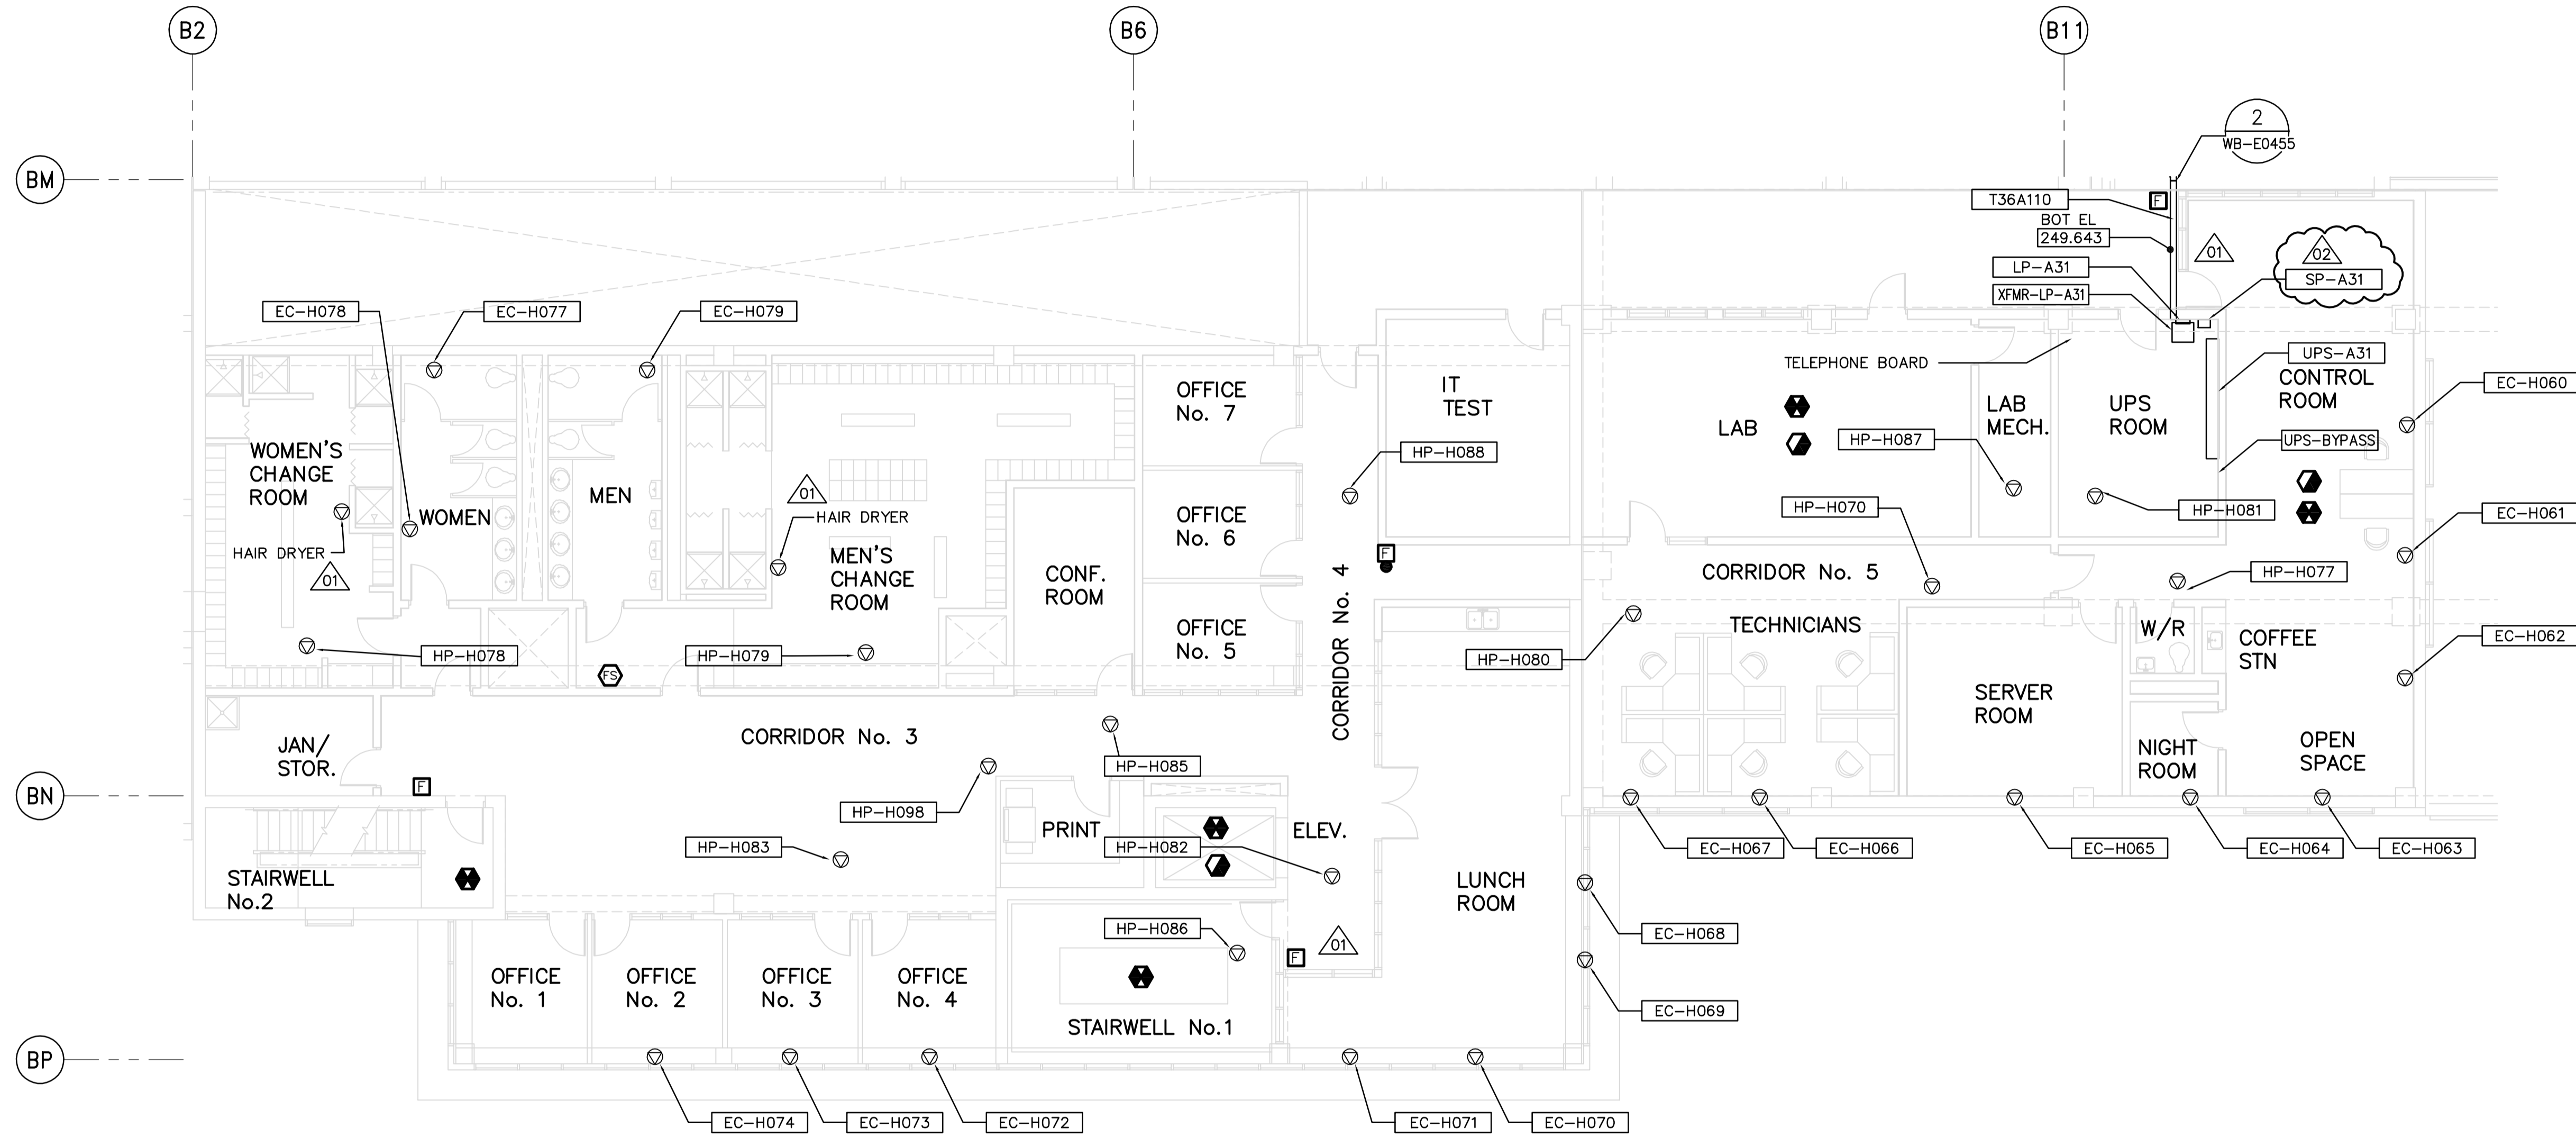


- NOTES:**
1. PROVIDE STAIRWELL SMOKE DETECTORS AS SHOWN ON FIRE PROTECTION DRAWINGS.
 2. ALL 120V AND 208V LOADS ARE FED FROM LP-A31.

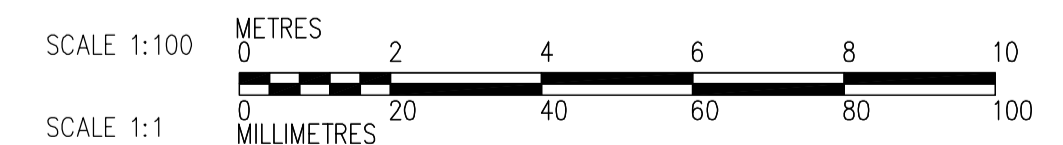

THIRD FLOOR FACILITY PLAN
1:100

CABLE TRAY TAGGING
SEE DEATL
3
WB-E0455

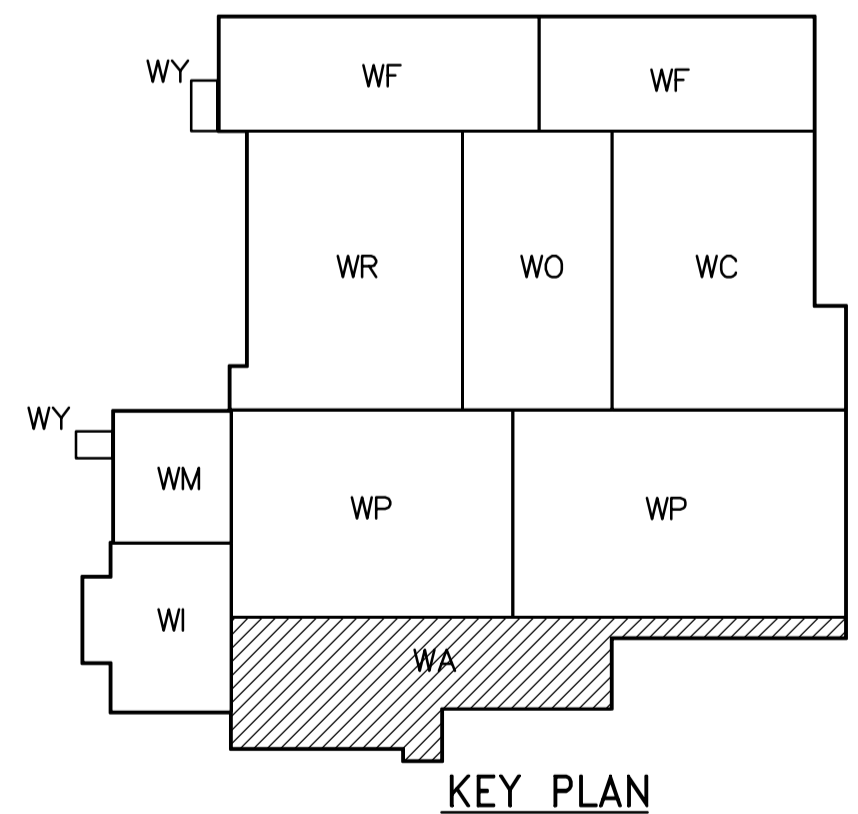

<p>APEGN Certificate of Authorization CH2M HILL Canada Ltd. No. 1441 Expiry: April 30, 2007</p>	<p>Frederickson Cooper ARCHITECTS</p>		<p>A You International Ltd. Company</p>		ENGINEER'S SEAL ORIGINAL SIGNED BY L.D. LLEWELLYN 2006/03/29	<p>THE CITY OF WINNIPEG WATER AND WASTE DEPARTMENT ENGINEERING DIVISION</p>	WATER TREATMENT PLANT ADMINISTRATION MECHANICAL AND ELECTRICAL	CITY FILE NUMBER SHEET OF	
	DESIGNED BY LL CHECKED BY ND DRAWN BY TL APPROVED BY AHL		SCALE: 1:100 RELEASED FOR CONSTRUCTION BY: R. SOROKOWSKI		CONSULTANT DRAWING NO. WA-E0131		ELECTRICAL ADMINISTRATION AREA THIRD FLOOR FACILITY PLAN	CITY DRAWING NUMBER 1-0601A-A-E0131-001-02D	
	NO. REVISIONS DATE BY		DATE 2005/08/18 DATE 2006/03/29						
	02 742-2005 ADDENDUM 4 06/05/12 LL 01 742-2005 ADDENDUM 3 06/05/05 LL 00 ISSUED FOR TENDER 06/03/29 LL								