SHEET: COW-A1 (05/2005)

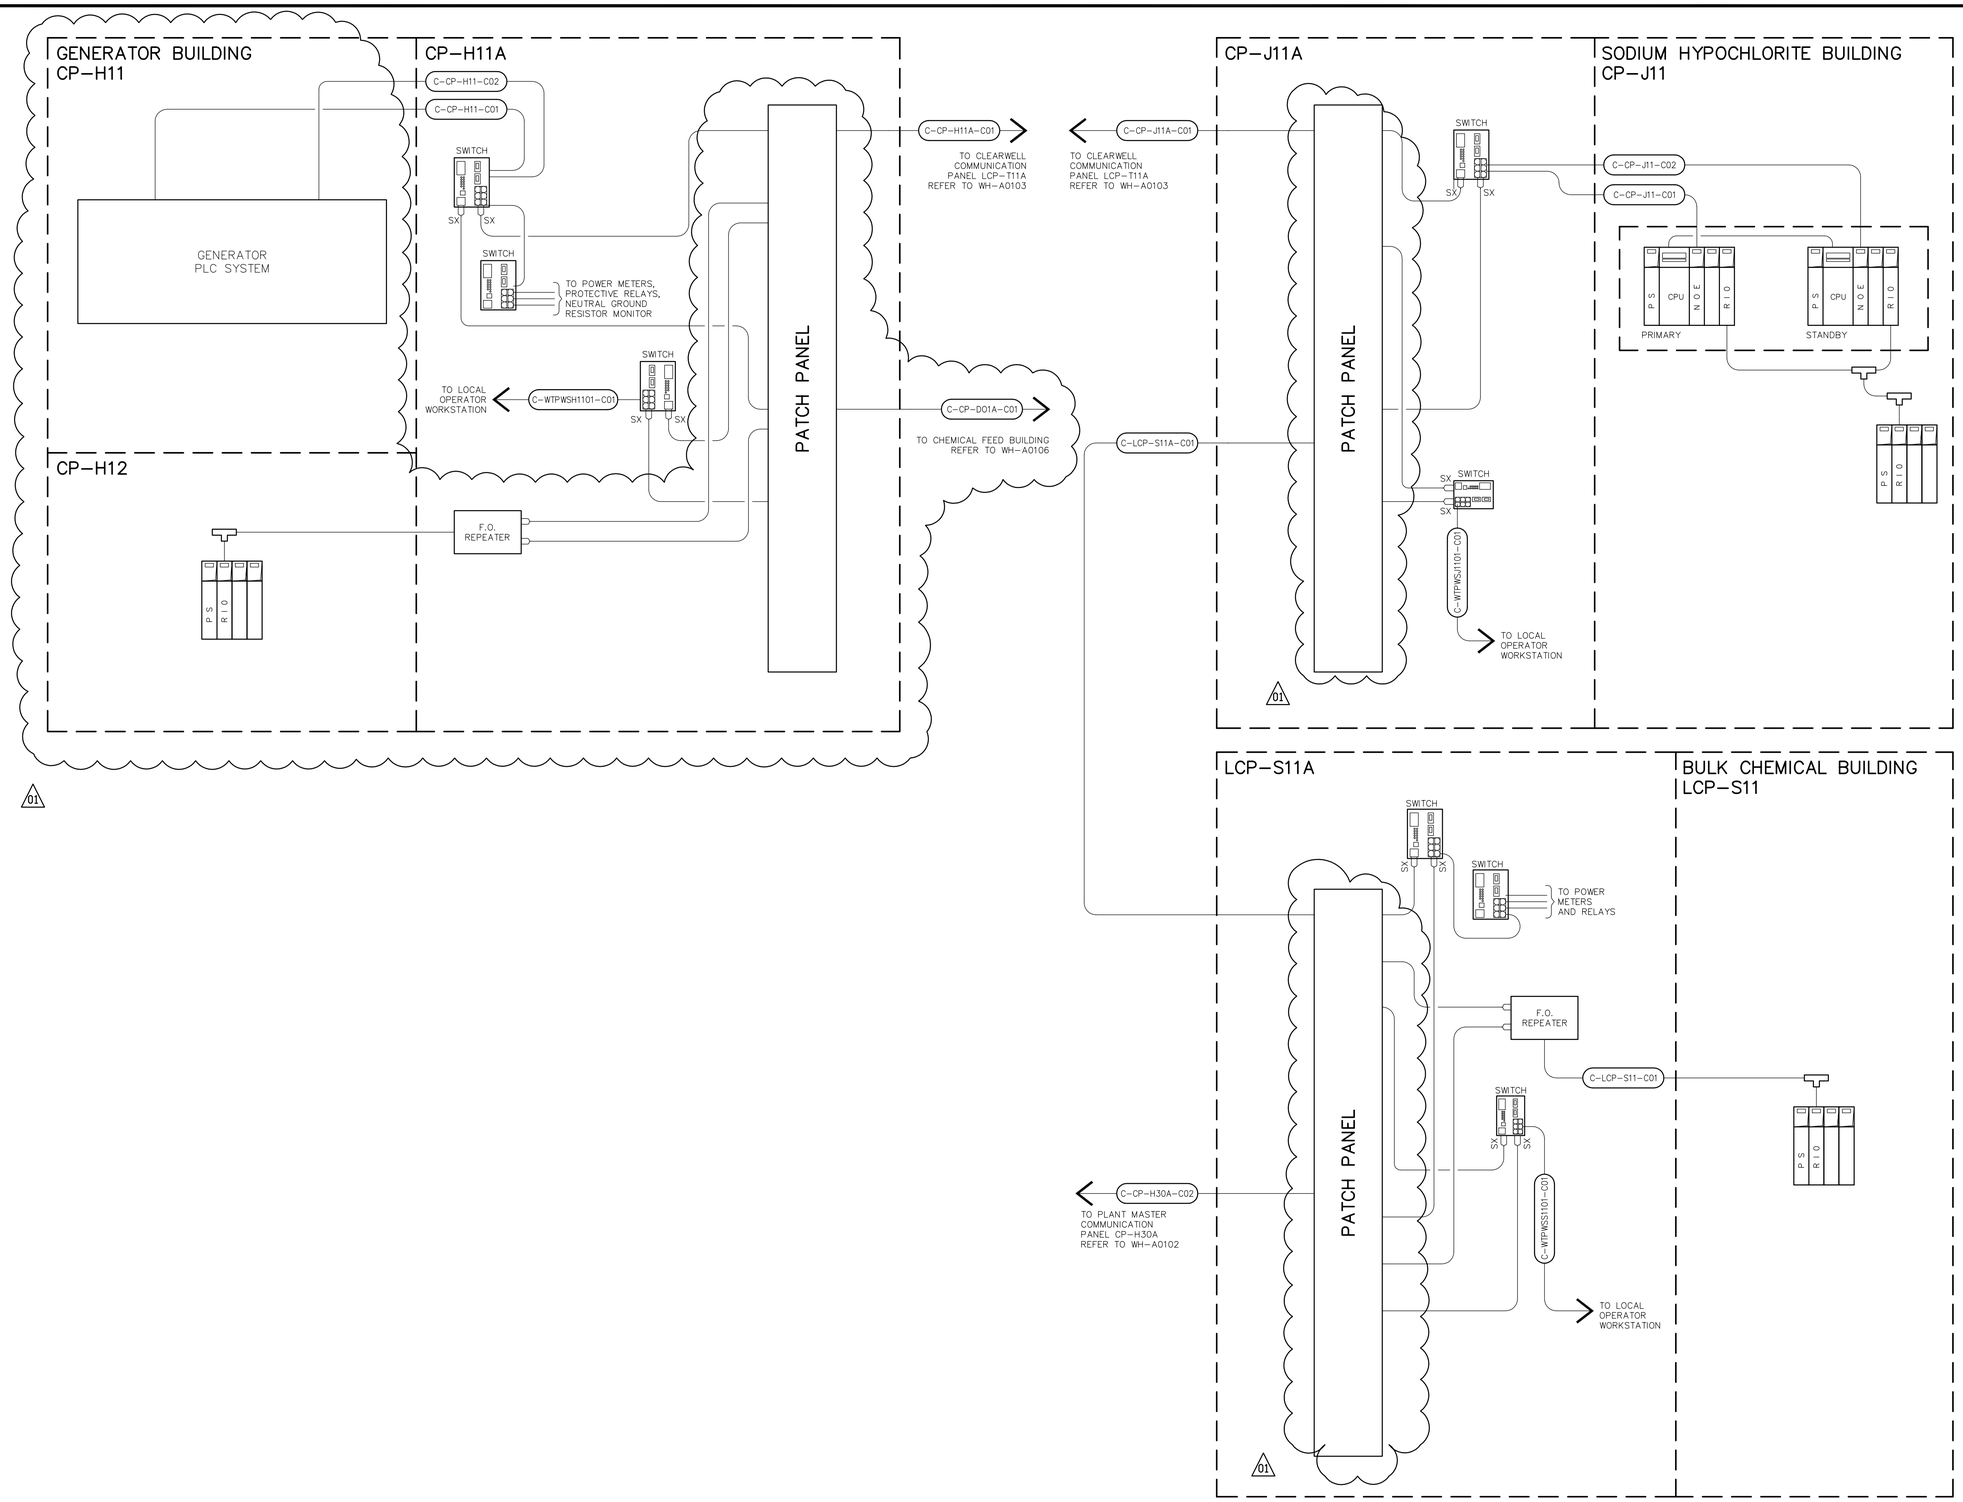

NOTES:

1. ISSUED FOR INFORMATION ONLY. PANELS AND ASSOCIATED CABLING ARE NOT IN CONTRACT 742-2005.

APEGM
Certificate of Authorization
Earth Tech Canada Inc.
No. 730 Expiry: April 30, 2007

B.M.
ELEV.

NO.	REVISIONS	DATE	BY
01	742-2005 ADDENDUM 9	06/06/16	SRP
00	ISSUED FOR TENDER	06/03/29	GLG

CH2MHILL
Frederickson Cooper ARCHITECTS
EarthTech A Tyco International Ltd. Company

DESIGNED BY	SWT	CHECKED BY	SWT
DRAWN BY	SRP/GLG	APPROVED BY	AHL
SCALE:	NONE	RELEASED FOR CONSTRUCTION BY:	R. SOROKOWSKI
DATE	2006/02/02	DATE	2006/03/29

ENGINEER'S SEAL
ORIGINAL SIGNED BY
S.W. TORMEY
2006/03/29

CONSULTANT DRAWING NO.
WH-A0104

Winnipeg
THE CITY OF WINNIPEG
WATER AND WASTE DEPARTMENT
ENGINEERING DIVISION

WATER TREATMENT PLANT
MAIN BUILDING
MECHANICAL AND ELECTRICAL

AUTOMATION / I&C
PLANT COMMUNICATION NETWORK
BLOCK DIAGRAM

CITY FILE NUMBER
SHEET OF
CITY DRAWING NUMBER
1-0601H-E-A0104-001-01D

Last Save: 2006-06-15 10:17 AM

L:\WORK\79000\79538\02A-CAD\INST\CONTR\WTP DETAILED DESIGN\DN_WH-A0104_ET.DWG