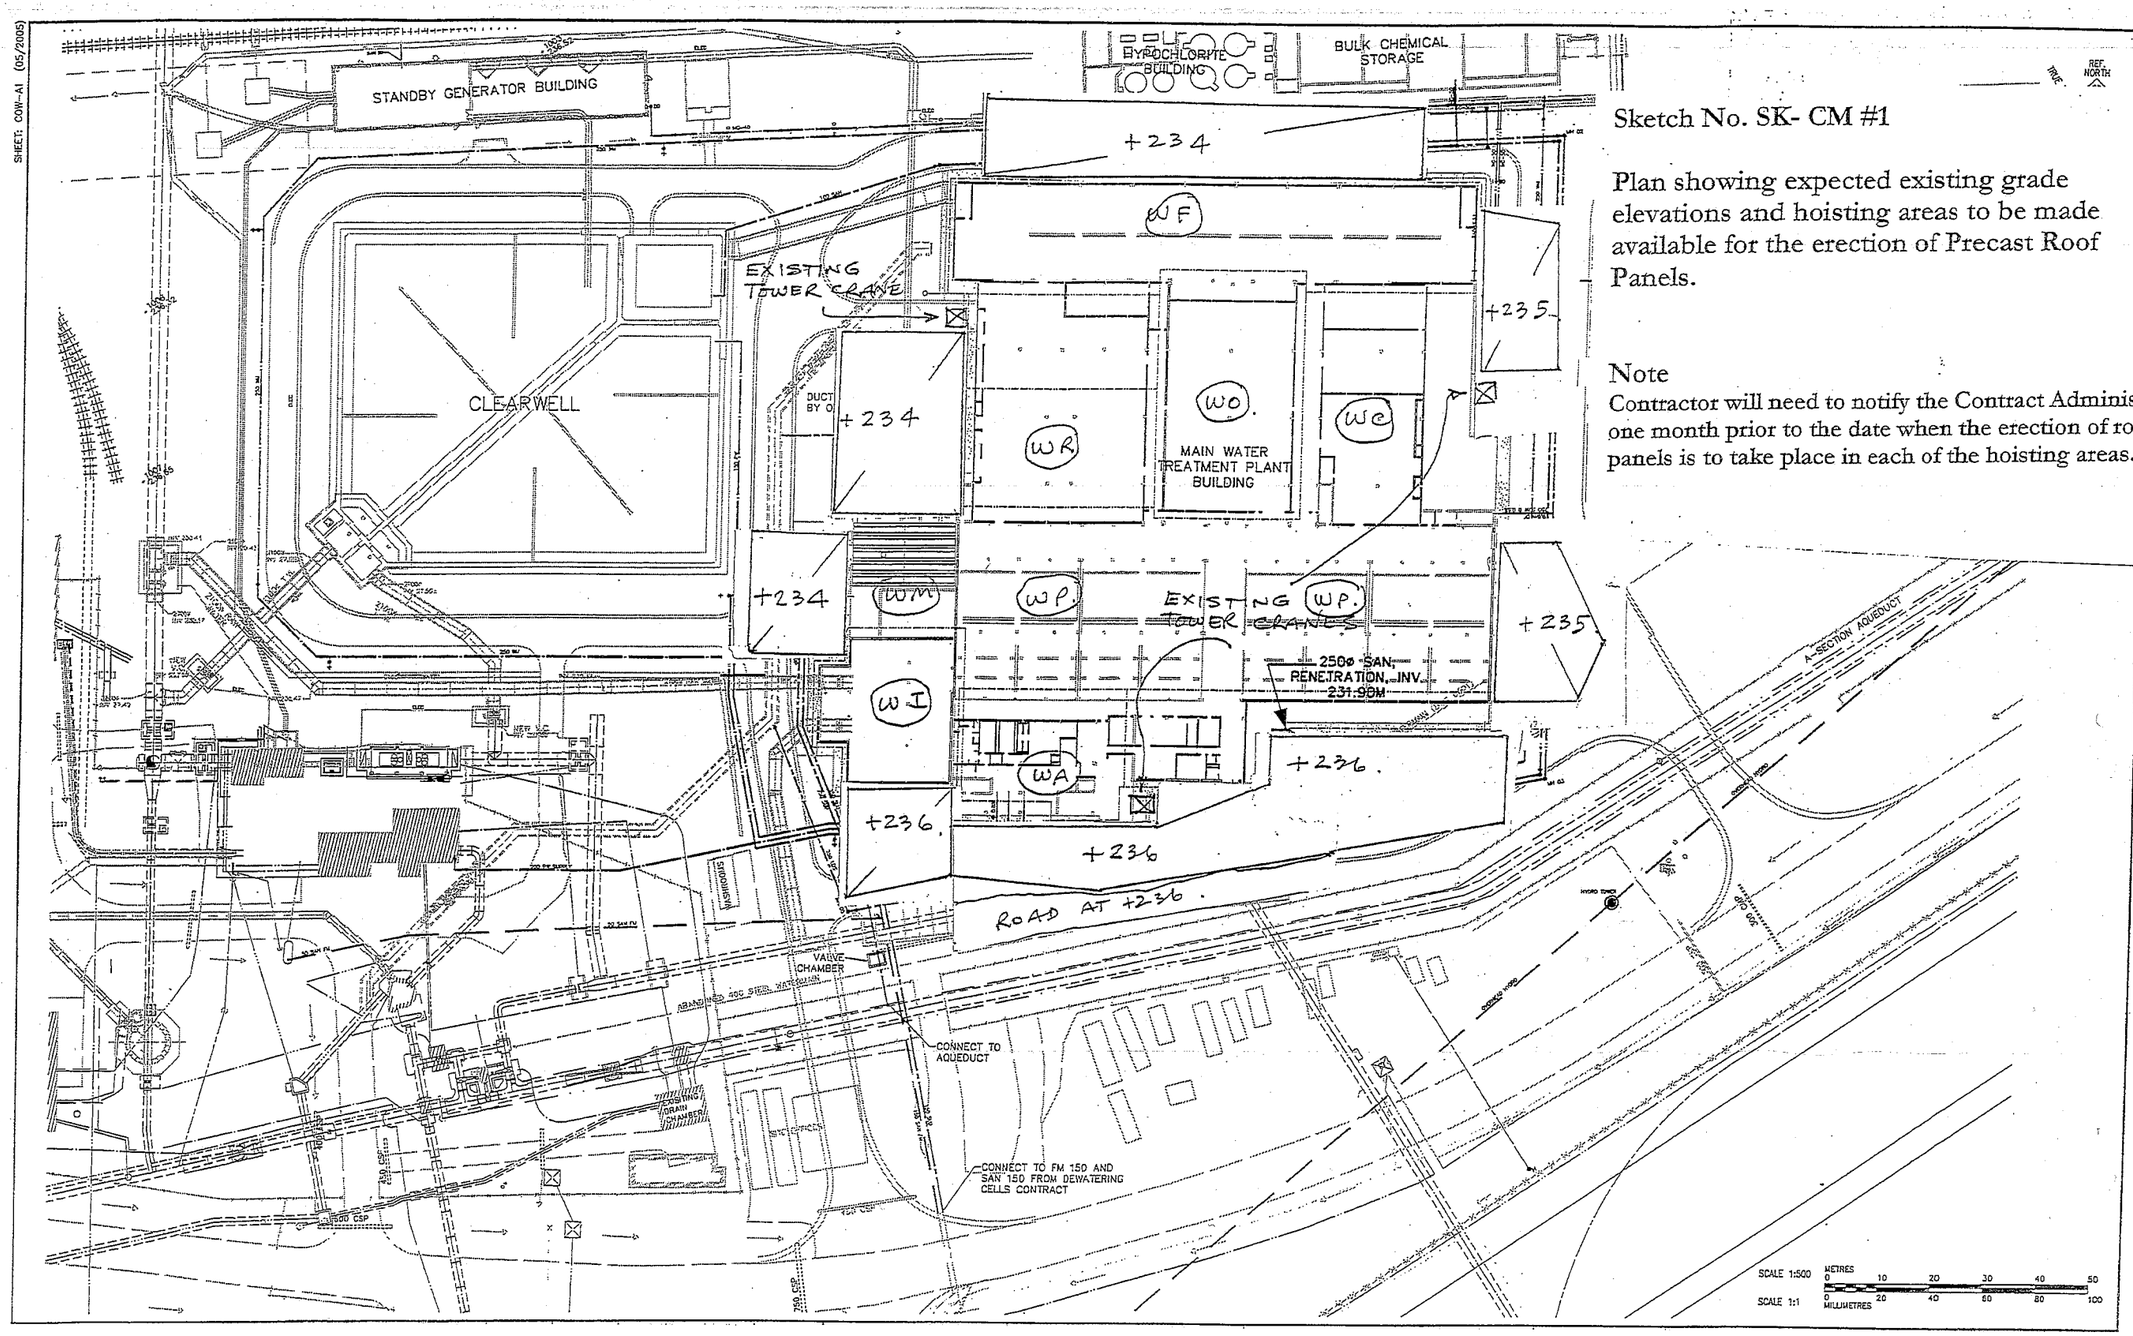

SHEET: COW-A1 (05/2005)

Sketch No. SK- CM #1

Plan showing expected existing grade elevations and hoisting areas to be made available for the erection of Precast Roof Panels.

Note

Contractor will need to notify the Contract Administrator one month prior to the date when the erection of roof panels is to take place in each of the hoisting areas.