



FOR CONTINUATION SEE DRAWING FP1.03

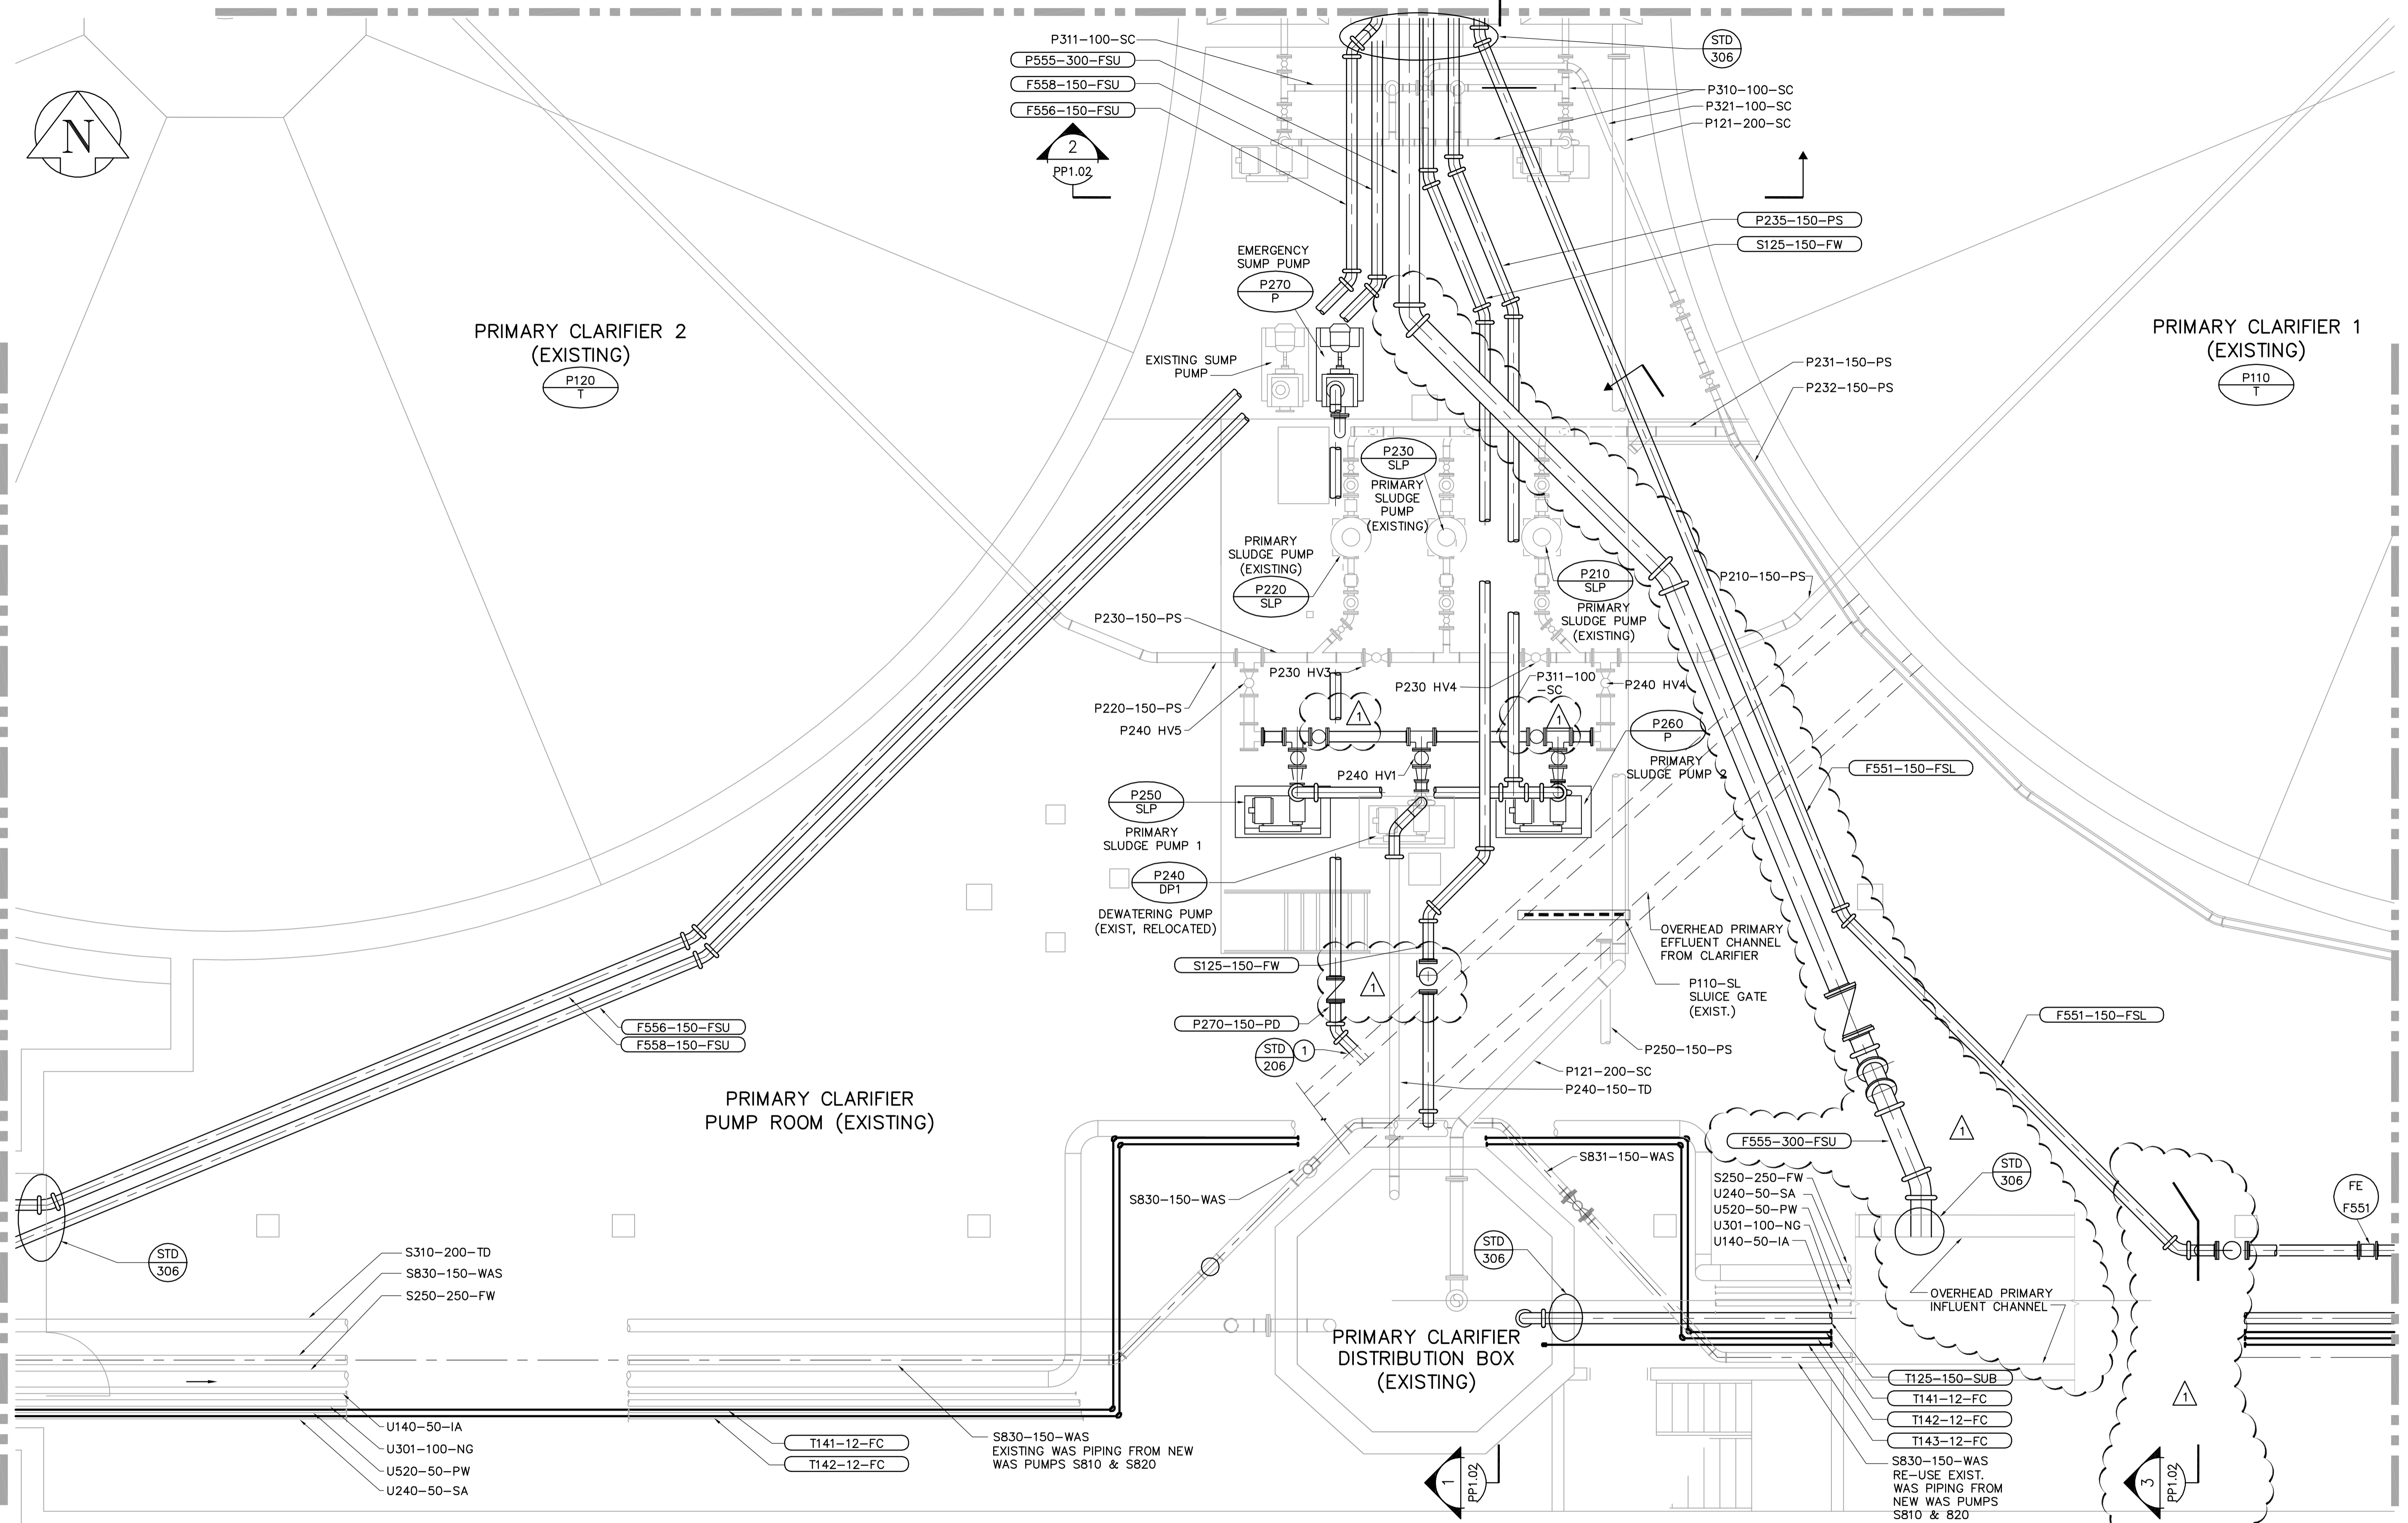

FOR CONTINUATION SEE DRAWING SP1.05

FOR CONTINUATION SEE DRAWING HP1.02

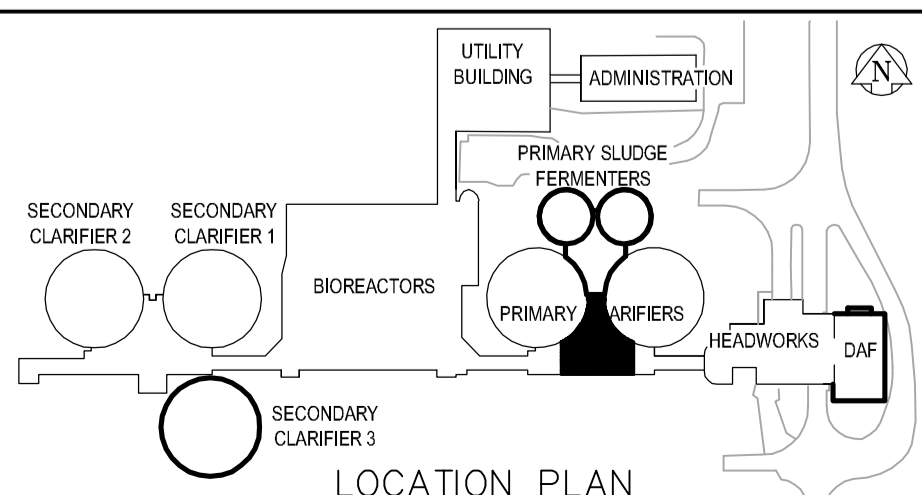

EXISTING PRIMARY CLARIFIERS - PUMP ROOM PLAN
1:50

DRAWING NOTES

1 TIE (P270-150-PD) INTO THE HEAD SPACE ABOVE THE WATER LINE IN THE OVERHEAD PRIMARY EFFLUENT CHANNEL FROM CLARIFIER DOWNSTREAM OF THE EXIST. P110-SL SLUICE GATE.



NO.	REVISIONS	DATE	BY
01	21-2006 ADDENDUM 3	06/05/19	PJY
00	ISSUED FOR TENDER	06/04/26	SRP

EarthTech
A Tyco International Ltd. Company

DESIGNED BY	YL	CHECKED BY	KM
DRAWN BY	PJY	APPROVED BY	JEH

HOR. SCALE: 1:50
VERTICAL SCALE:

RELEASED FOR CONSTRUCTION BY: J. VEILLEUX
DATE: 2006/04/26

ENGINEER'S SEAL

ORIGINAL SIGNED BY
J.E. HUTCHISON
2006/04/26

CONSULTANT DRAWING NO.
PP1.01

THE CITY OF WINNIPEG
WATER AND WASTE DEPARTMENT
ENGINEERING DIVISION

WEWPCC
BIOLOGICAL NUTRIENT REMOVAL UPGRADE
CONTRACT 3

PROCESS
AREA P - PRIMARY CLARIFIERS
PUMP ROOM - PLAN

CITY FILE NUMBER
SHEET OF
CITY DRAWING NUMBER