
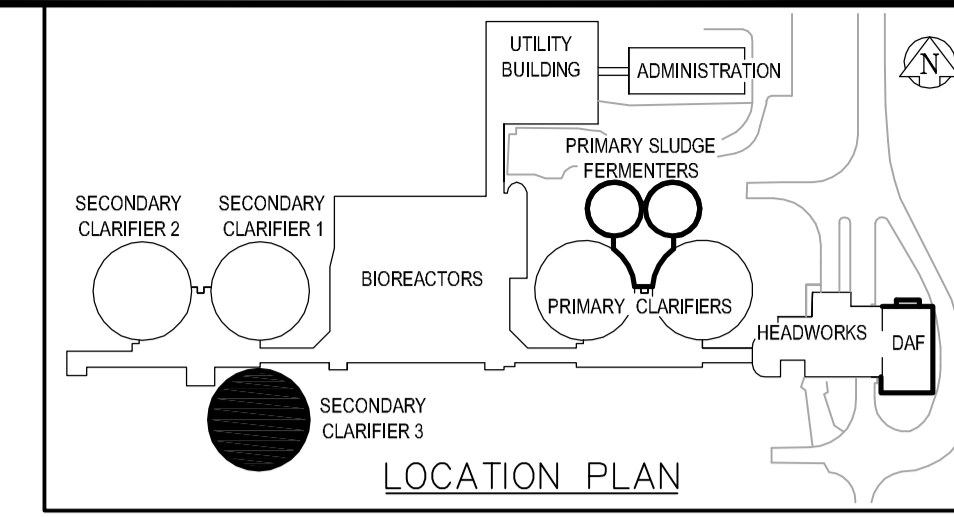


FOR CONTINUATION
SEE DRAWING SP2.04

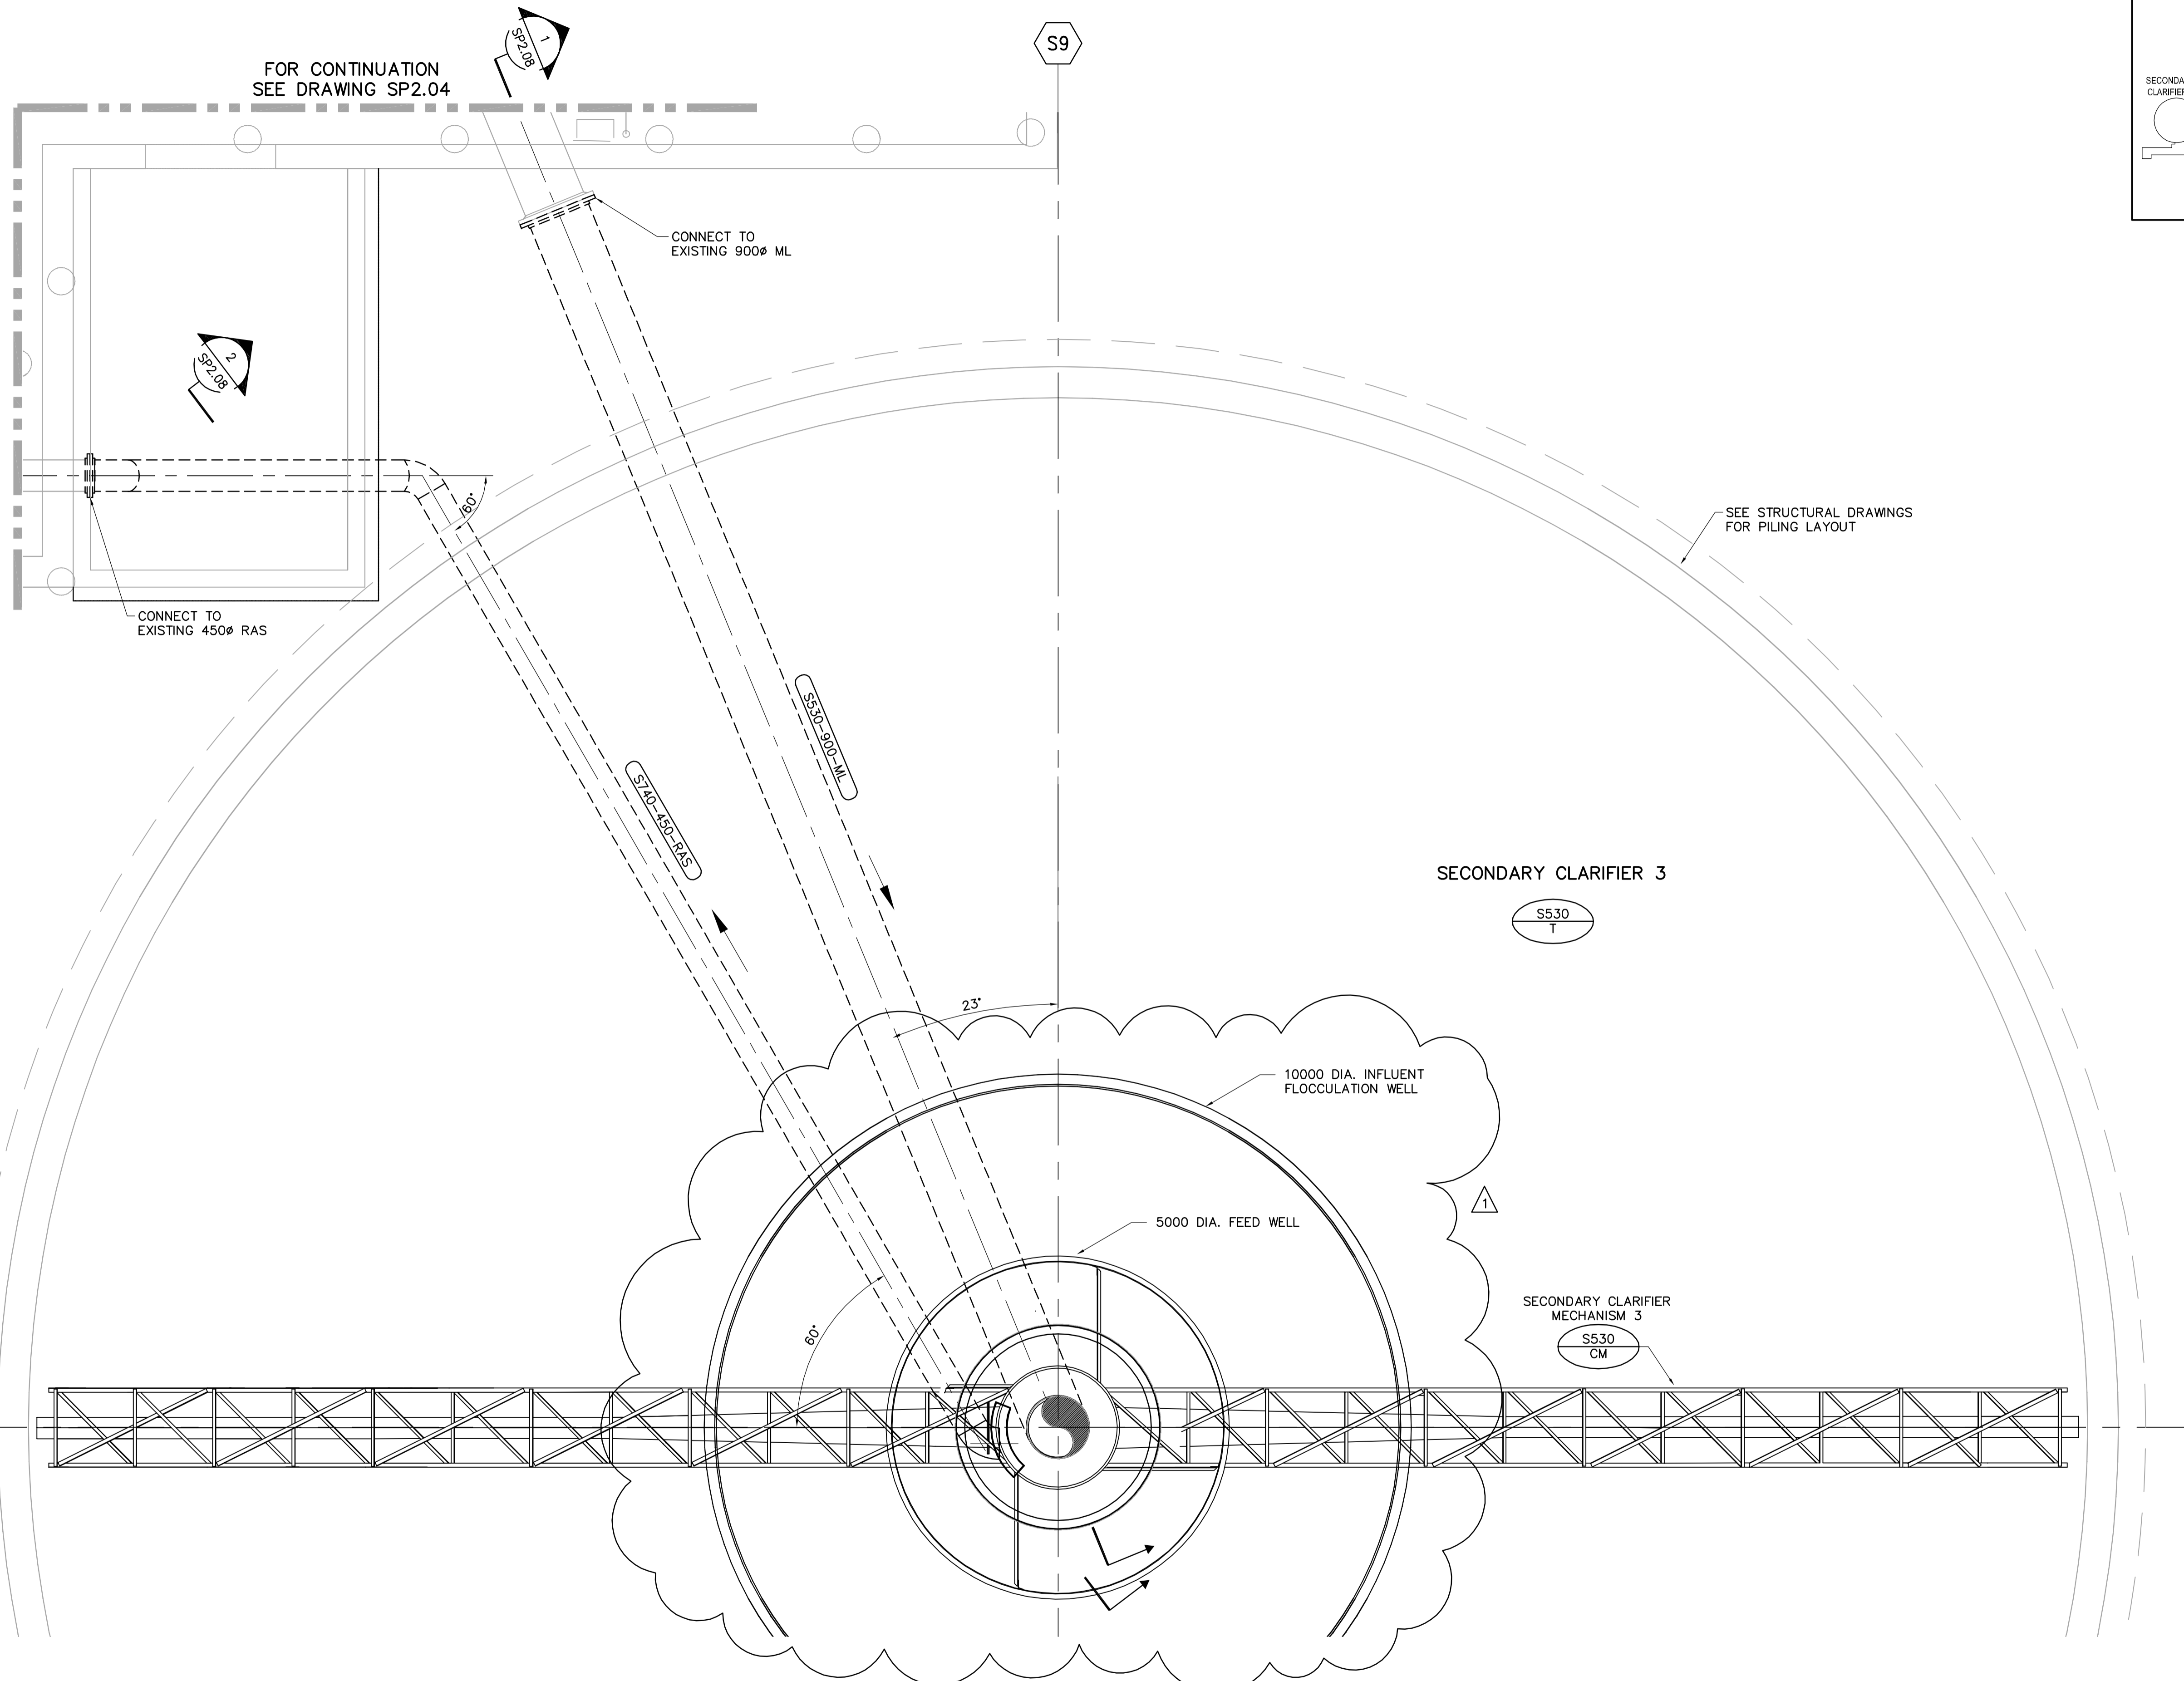

SECONDARY CLARIFIER 3

S530
T

10000 DIA. INFLUENT
FLOCCULATION WELL

5000 DIA. FEED WELL

SECONDARY CLARIFIER
MECHANISM 3

S530
CM

LOWER LEVEL PLAN
1:50



GENERAL NOTES

1. CONTRACTOR TO CONFIRM EXISTING PIPE AND EQUIPMENT DIMENSIONS AND LOCATIONS PRIOR TO CONSTRUCTION.

NO.	REVISIONS	DATE	BY
01	21-2006 ADDENDUM 3	06/05/19	PAL
00	ISSUED FOR TENDER	06/04/26	SRP

EarthTech
A Tyco International Ltd. Company

DESIGNED BY	KS	CHECKED BY	KM
DRAWN BY	PJY	APPROVED BY	JEH

HOR. SCALE: AS NOTED
VERTICAL SCALE:

DATE	2005/10/06	DATE	2006/04/26
------	------------	------	------------

RELEASED FOR CONSTRUCTION BY:
J. VEILLEUX

ENGINEER'S SEAL
ORIGINAL
SIGNED BY
J.E. HUTCHISON
2006/04/26
CONSULTANT DRAWING NO.
SP2.03

THE CITY OF WINNIPEG
WATER AND WASTE DEPARTMENT
ENGINEERING DIVISION

WEWPCC
BIOLOGICAL NUTRIENT REMOVAL UPGRADE
CONTRACT 3

CITY FILE NUMBER
SHEET OF
CITY DRAWING NUMBER

PROCESS
AREA S - SECONDARY CLARIFIER 3
LOWER LEVEL PLAN