SHEET: COW-A1 (03/2005)

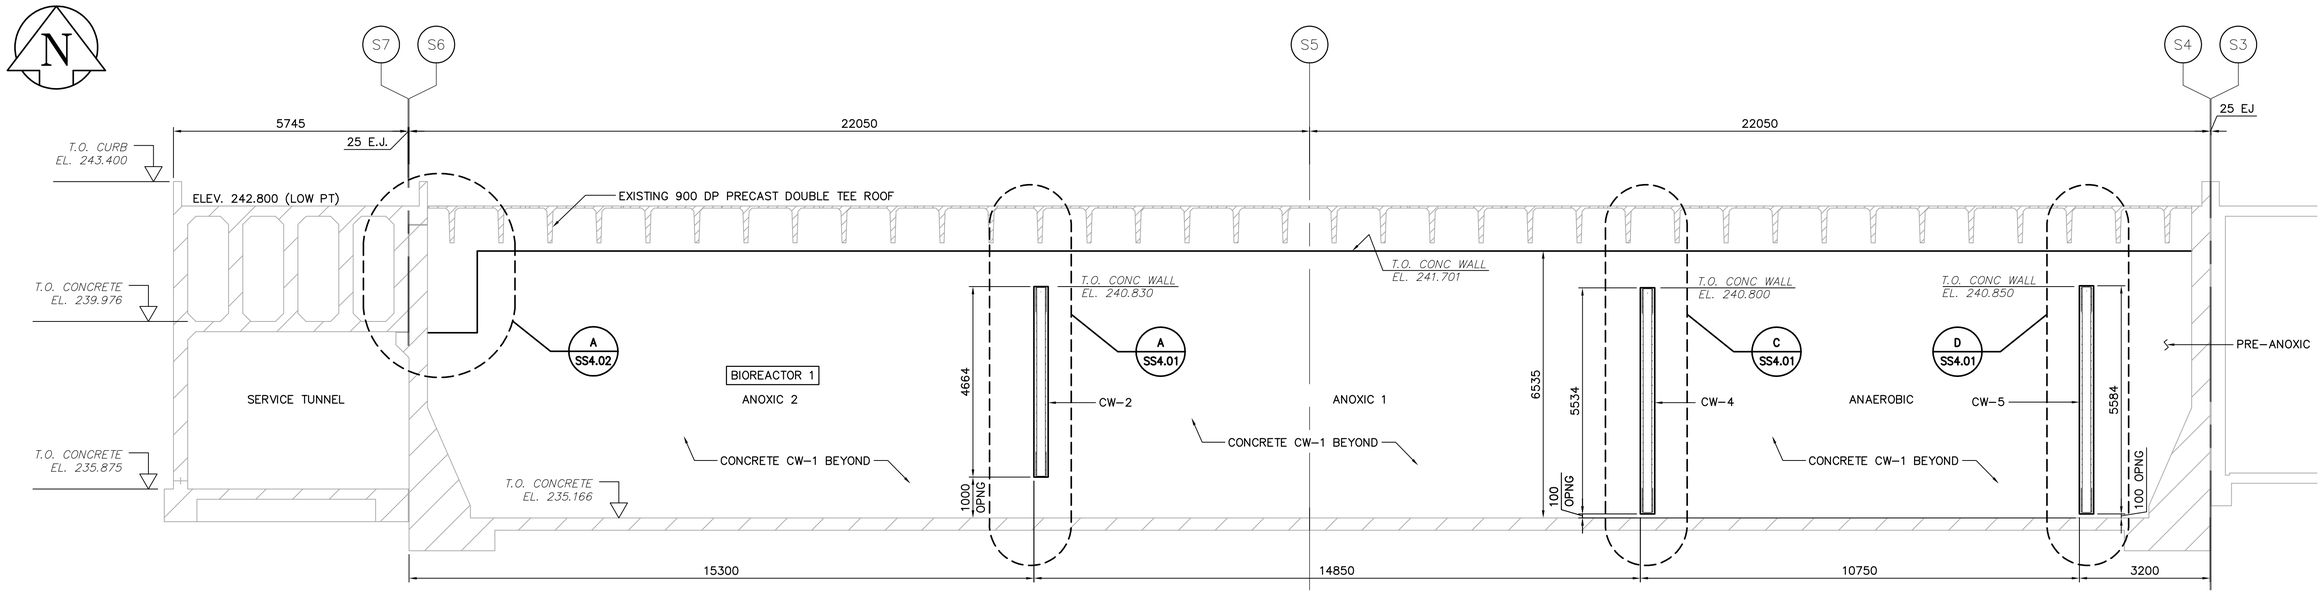


1 SS2.01 **SECTION**
SCALE 1:75

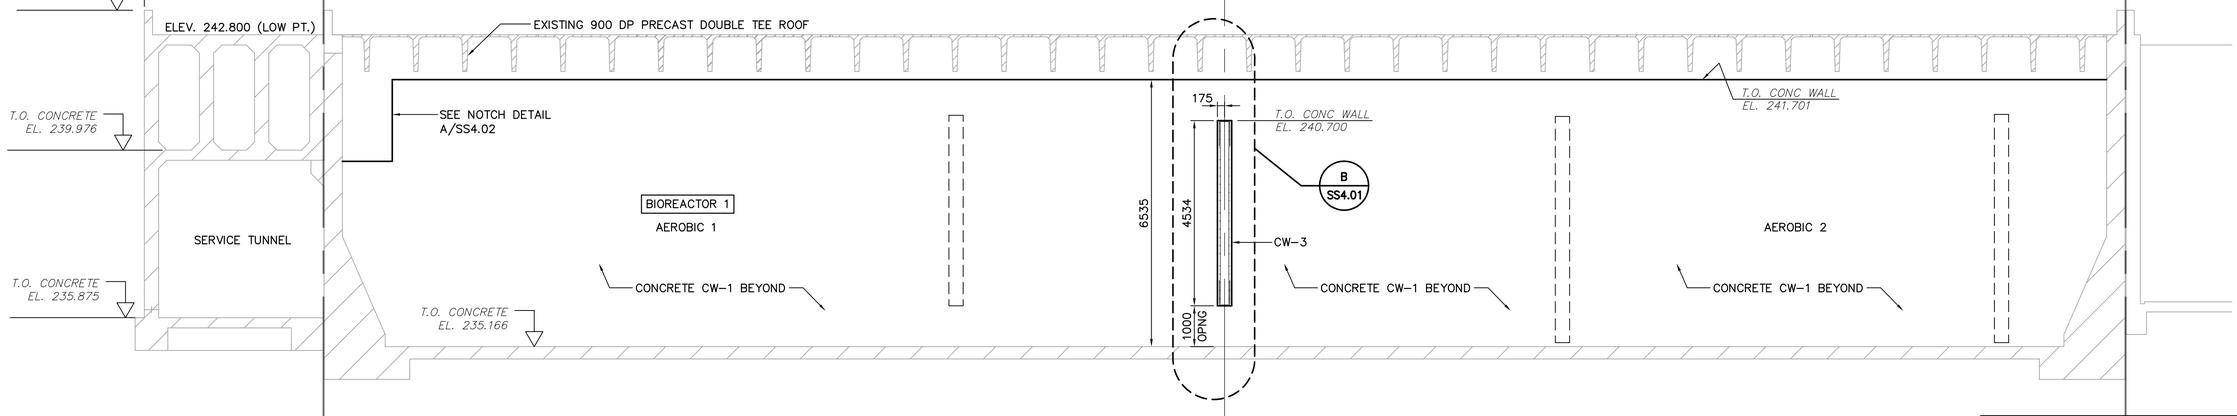


2 SS2.02 **SECTION**
SCALE 1:75

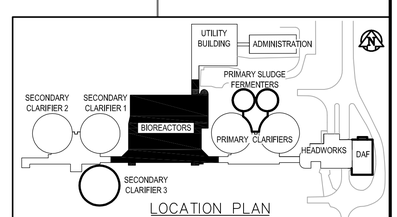

LOCATION PLAN

APEGM
Certificate of Authorization
Earth Tech Canada Inc.
No. 730 Expiry: April 30, 2006

| NO. | REVISIONS | DATE | BY |
|---|---|---|---|
| 01 | 21-2006 ADDENDUM 3 | 06/05/19 | SRP |
| 00 | ISSUED FOR TENDER | 06/04/26 | KK |

B.M. ELEV.

EarthTech
A Tyco International Ltd. Company

| | | | |
|---|---|---|---|
| DESIGNED BY | AA/JB | CHECKED BY | AA/JB |
| DRAWN BY | WDB | APPROVED BY | JEH |
| HOR. SCALE: AS NOTED<br>VERTICAL SCALE: | | RELEASED FOR CONSTRUCTION BY: | J. VEILLEUX |
| DATE | 2005/11/16 | DATE | 2006/04/26 |

ENGINEER'S SEAL
ORIGINAL SIGNED BY
J. BETKE
2006/04/26

CONSULTANT DRAWING NO.
SS3.01

Winnipeg
THE CITY OF WINNIPEG
WATER AND WASTE DEPARTMENT
ENGINEERING DIVISION

WEWPCC
BIOLOGICAL NUTRIENT REMOVAL UPGRADE
CONTRACT 3

CITY FILE NUMBER
SHEET OF

STRUCTURAL
AREA S – BIOREACTORS
BUILDING SECTIONS

CITY DRAWING NUMBER

05/19/06 12:17pm sondra.polten L:\work\76000\76063\02a-CAD\IND\CONTR\Bioreactor\SS3-01.dwg Layout:Layout1