


FOR CONTINUATION
SEE DRAWING FP1.01

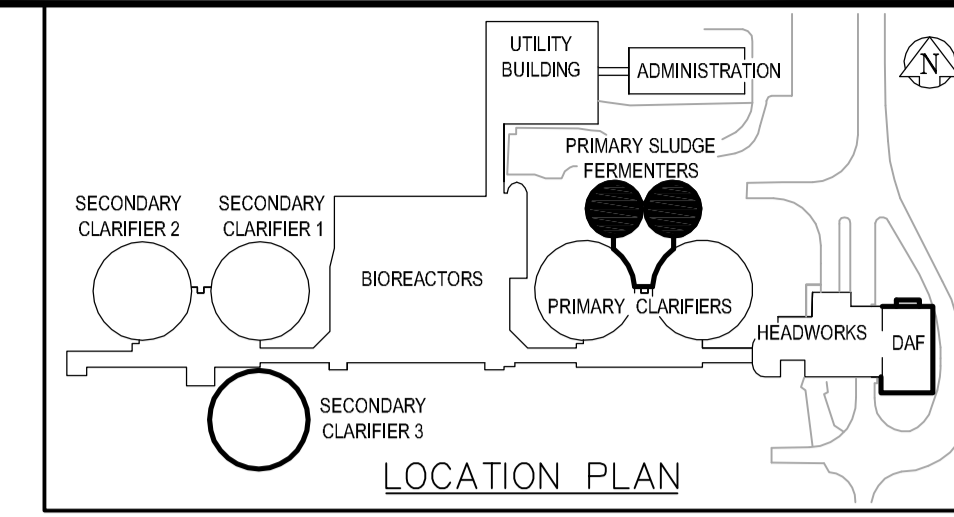

FOR CONTINUATION
SEE DRAWING PP1.01

PLAN - FERMENTER PUMP ROOM
1:50

NOTES:
PIPE DIMENSIONS ADDED.
PIPE DIMENSIONS SHOWN ARE TO THE NEAREST 0.1m±



NO.	REVISIONS	DATE	BY
01	21-2006 ADDENDUM 6	06/06/30	JBC
00	ISSUED FOR TENDER	06/04/26	PJY

EarthTech
A Tyco International Ltd. Company

DESIGNED BY	YL	CHECKED BY	KM
DRAWN BY	PJY	APPROVED BY	JEH

HOR. SCALE: AS NOTED
VERTICAL SCALE: AS NOTED

RELEASED FOR CONSTRUCTION BY:
J. VEILLEUX

DATE: 2005/10/06
DATE: 2006/04/26

ENGINEER'S SEAL
ORIGINAL SIGNED BY
P.R. BARSALOU
2006/04/26
CONSULTANT DRAWING NO.
FP1.03

THE CITY OF WINNIPEG
WATER AND WASTE DEPARTMENT
ENGINEERING DIVISION

WEWPC
BIOLOGICAL NUTRIENT REMOVAL UPGRADE
CONTRACT 3

PROCESS
AREA F - PRIMARY SLUDGE FERMENTER
PUMP ROOM - PLAN

CITY FILE NUMBER
SHEET OF
CITY DRAWING NUMBER

GENERAL NOTES
1. REFER TO MECHANICAL DRAWINGS FOR ALL DUCTING TO THE THERMAL OXIDIZER.