



1 SECTION - BIOREACTOR 1 (TYP. FOR BIOREACTOR 2)
SP1.02 1:100

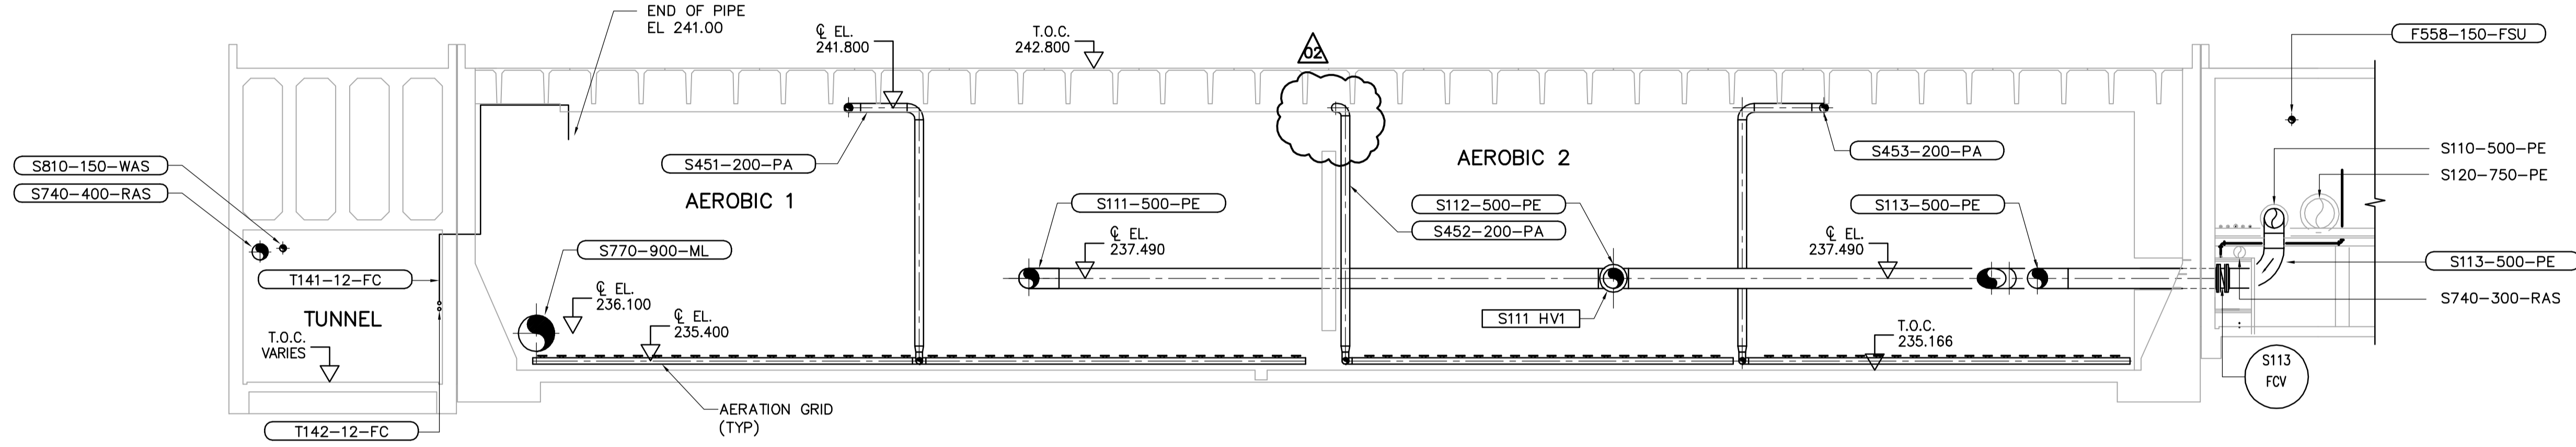

2 SECTION - BIOREACTOR 1 (TYP. FOR BIOREACTOR 2)
SP1.02 1:100

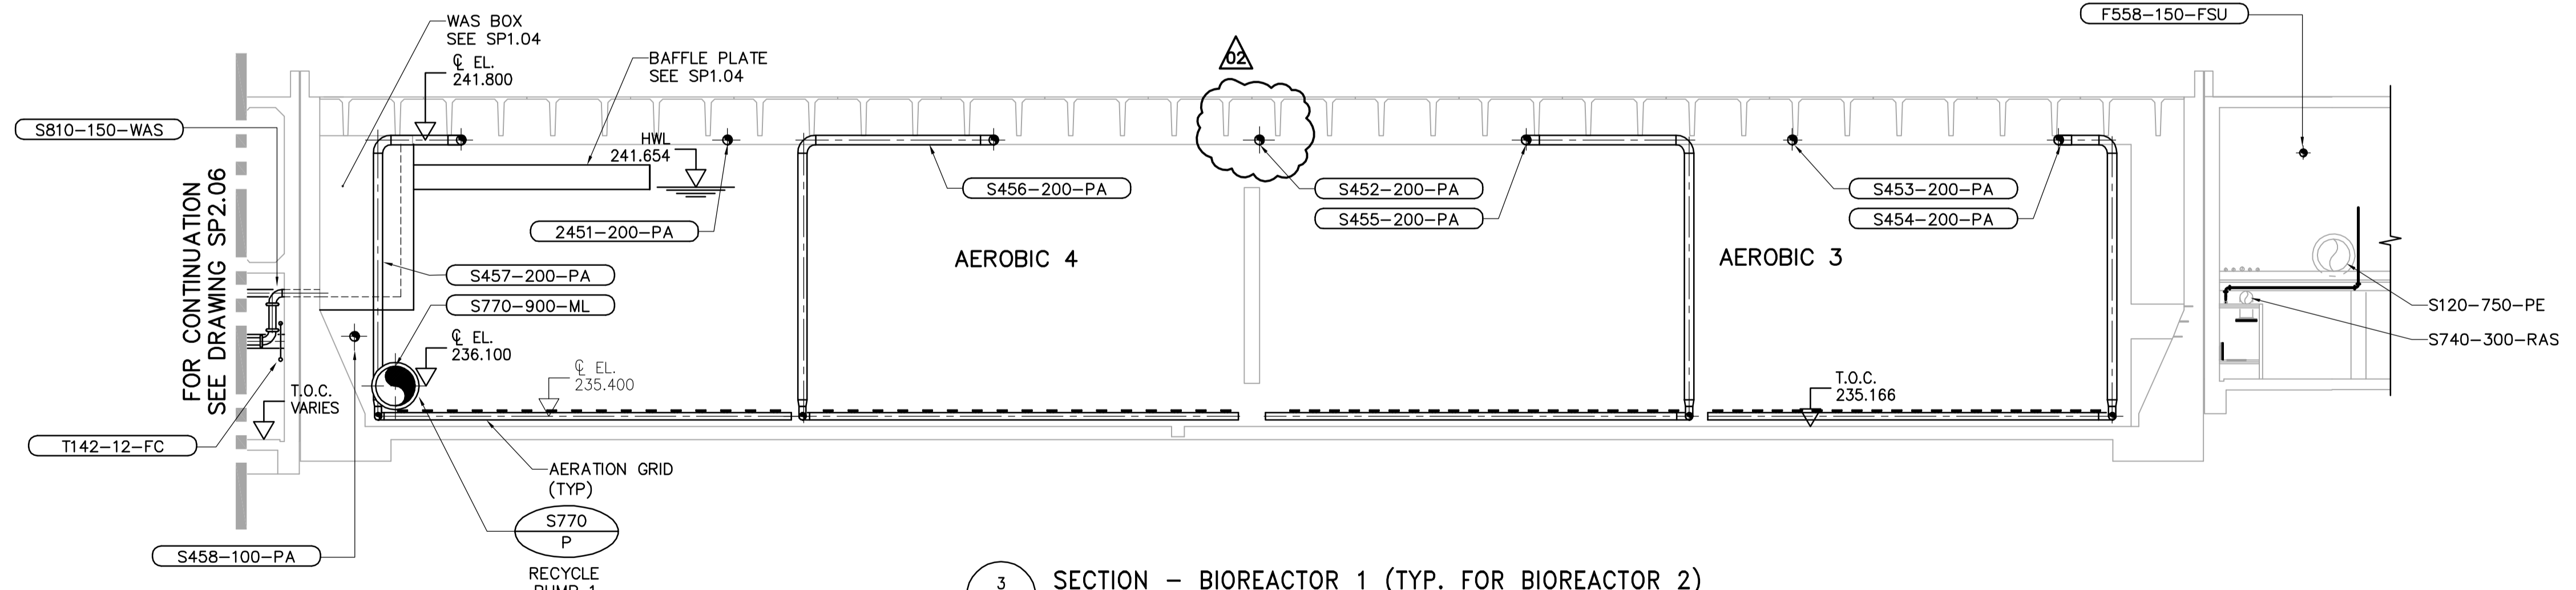

3 SECTION - BIOREACTOR 1 (TYP. FOR BIOREACTOR 2)
SP1.02 1:100

GENERAL NOTES
1. CONTRACTOR TO CONFIRM EXISTING PIPE AND EQUIPMENT DIMENSIONS AND LOCATIONS PRIOR TO CONSTRUCTION.



NO.	REVISIONS	DATE	BY
02	21-2006 ADDENDUM 6	06/06/30	JBC
01	21-2006 ADDENDUM 3	06/05/19	PAL
00	ISSUED FOR TENDER	06/04/26	SRP

EarthTech
A Tyco International Ltd. Company

DESIGNED BY	CL	CHECKED BY	KM
DRAWN BY	RI	APPROVED BY	JEH

HOR. SCALE: AS NOTED
VERTICAL SCALE: AS NOTED

RELEASED FOR CONSTRUCTION BY:
J. VEILLEUX

DATE 2005/10/06 DATE 2006/04/26

ENGINEER'S SEAL
ORIGINAL SIGNED BY
P.R. BARSALOU
2006/04/26
CONSULTANT DRAWING NO.
SP1.06

THE CITY OF WINNIPEG
WATER AND WASTE DEPARTMENT
ENGINEERING DIVISION

WEWPCC
BIOLOGICAL NUTRIENT REMOVAL UPGRADE
CONTRACT 3

PROCESS
AREA S - BIOREACTORS
SECTIONS

CITY FILE NUMBER
SHEET OF
CITY DRAWING NUMBER