SHEET: COW-A1 (03/2005)

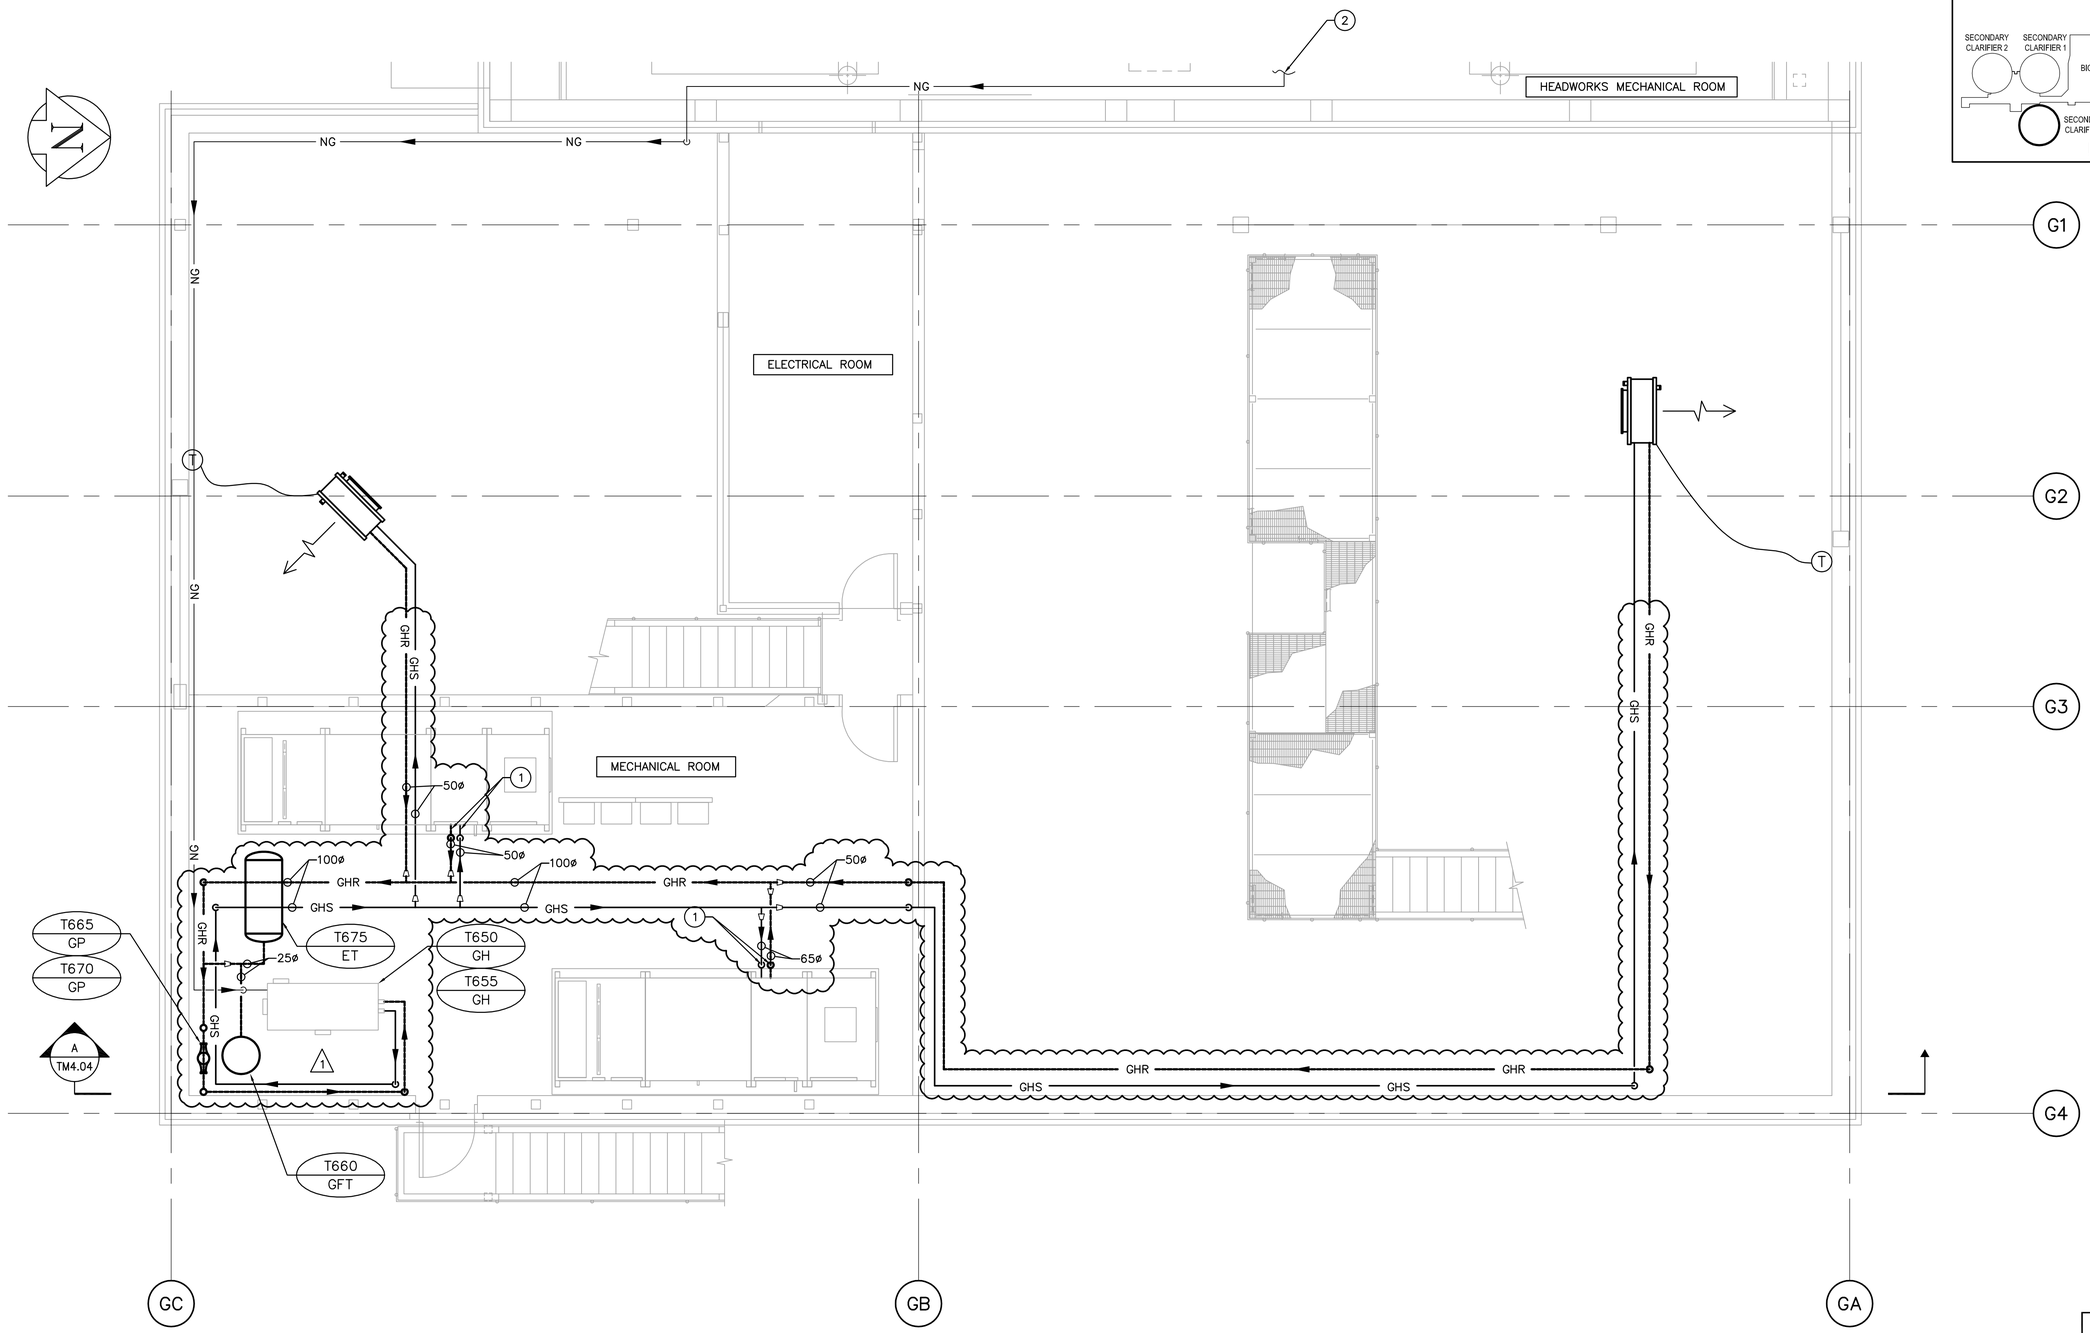

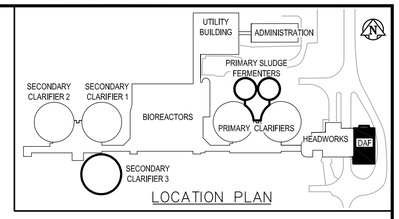

HYDRONIC PLAN

SCALE: 1:50

APEGM
Certificate of Authorization
Earth Tech Canada Inc.
No. 730 Expiry: April 30, 2006

DRAWING NOTES

1. SEE DRAWINGS LM4.06 FOR HEATING CONTROL PIPING AND CONTROL DETAILS.
2. 50ø NG PIPE TIE TO MECHANICAL ROOM IN HEADWORKS BUILDING. SEE DRAWING HM1.02 FOR CONTINUATION.

GENERAL NOTES

1. COORDINATE WITH OTHER TRADES SO AS TO PREVENT CONFLICTS.

B.M.
ELEV.

NO.	REVISIONS	DATE	BY
01	21-2006 ADDENDUM 6	06/06/30	DC
00	ISSUED FOR TENDER	06/04/26	DC

EarthTech
A Tyco International Ltd. Company

DESIGNED BY	AB/LJW	CHECKED BY	PVL
DRAWN BY	LJW	APPROVED BY	JEH
HOR. SCALE: 1:50 VERTICAL SCALE:		RELEASED FOR CONSTRUCTION BY:	J. VEILLEUX
DATE	2006/01/04	DATE	2006/04/26

ENGINEER'S SEAL
ORIGINAL SIGNED BY
A. BURACHYNSKY
2006/04/26

CONSULTANT DRAWING NO.
TM3.01

Winnipeg
THE CITY OF WINNIPEG
WATER AND WASTE DEPARTMENT
ENGINEERING DIVISION

WEWPCC
BIOLOGICAL NUTRIENT REMOVAL UPGRADE
CONTRACT 3

CITY FILE NUMBER
SHEET OF

MECHANICAL
AREA T – DAF THICKENER BUILDING
HYDRONIC PLAN

CITY DRAWING NUMBER