

INSTRUMENT LOOP DIAGRAM


LOOP NO. F661

FIELD PROCESS AREA

FIELD DEVICE PANEL

DCS


REFER TO DCS TERMINAL NUMBERING LEGEND BELOW

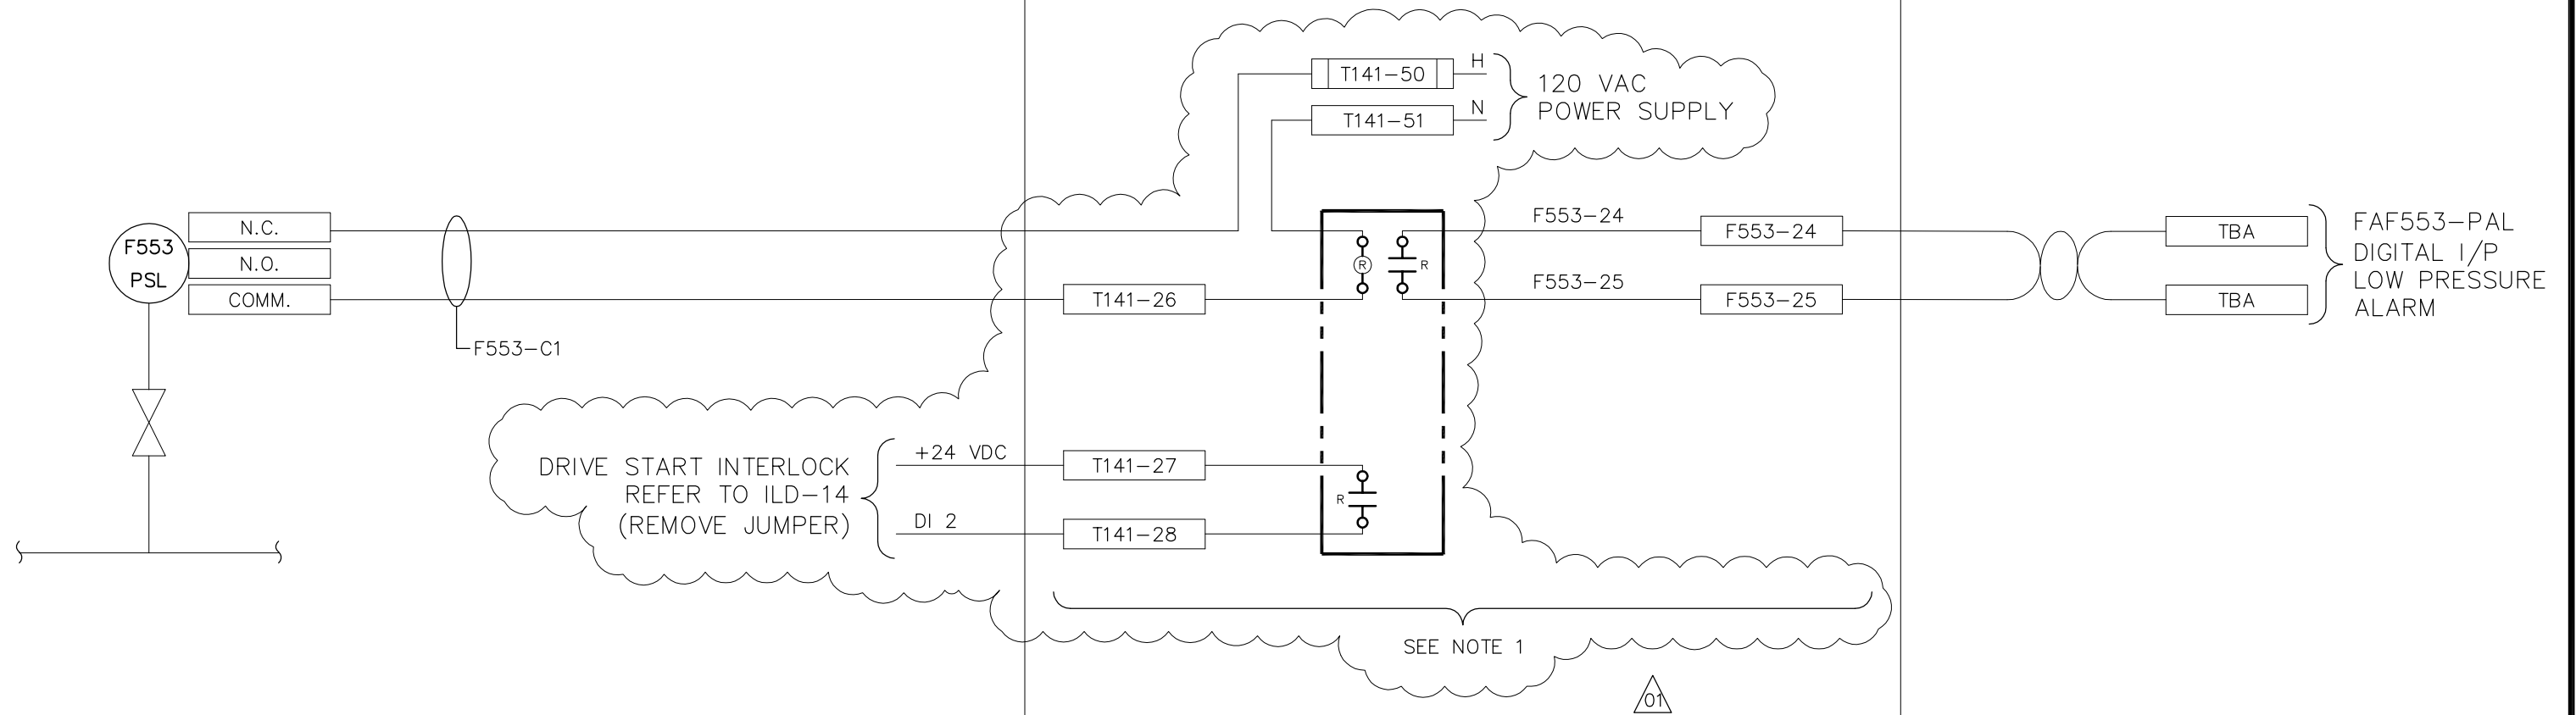

NOTE:
 1. INTERPOSING RELAY IS ONLY REQUIRED FOR T141-FSL, T142-FSL, T143-FSL, AND T444-FSL.



DCS TERMINAL NUMBERING

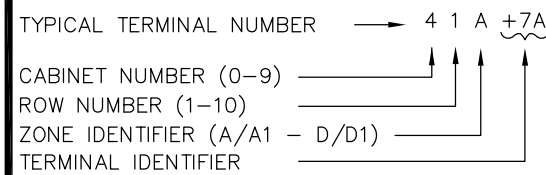

EarthTech Earth Tech (Canada) Inc. Winnipeg, Manitoba 204.477.5381		
06/07/10	21-2006 ADDENDUM 8	BL
DATE	REVISION	APP.

THE CITY OF WINNIPEG
Winnipeg WATER AND WASTE DEPARTMENT
 WEWPCC - BIOLOGICAL NUTRIENT REMOVAL UPGRADE

TYPICAL INSTRUMENT LOOP DIAGRAM
 FIELD MOUNTED PROCESS SWITCH

SCALE AS NOTED
 DATE 2006/06/05
 DES SWT DWN SRP
 CKD BL APP SWT

DRAWING NO.
 ILD-05