


**BLOWER ROOM - LIGHTING & SYSTEM PLAN**  
SCALE: 1:50

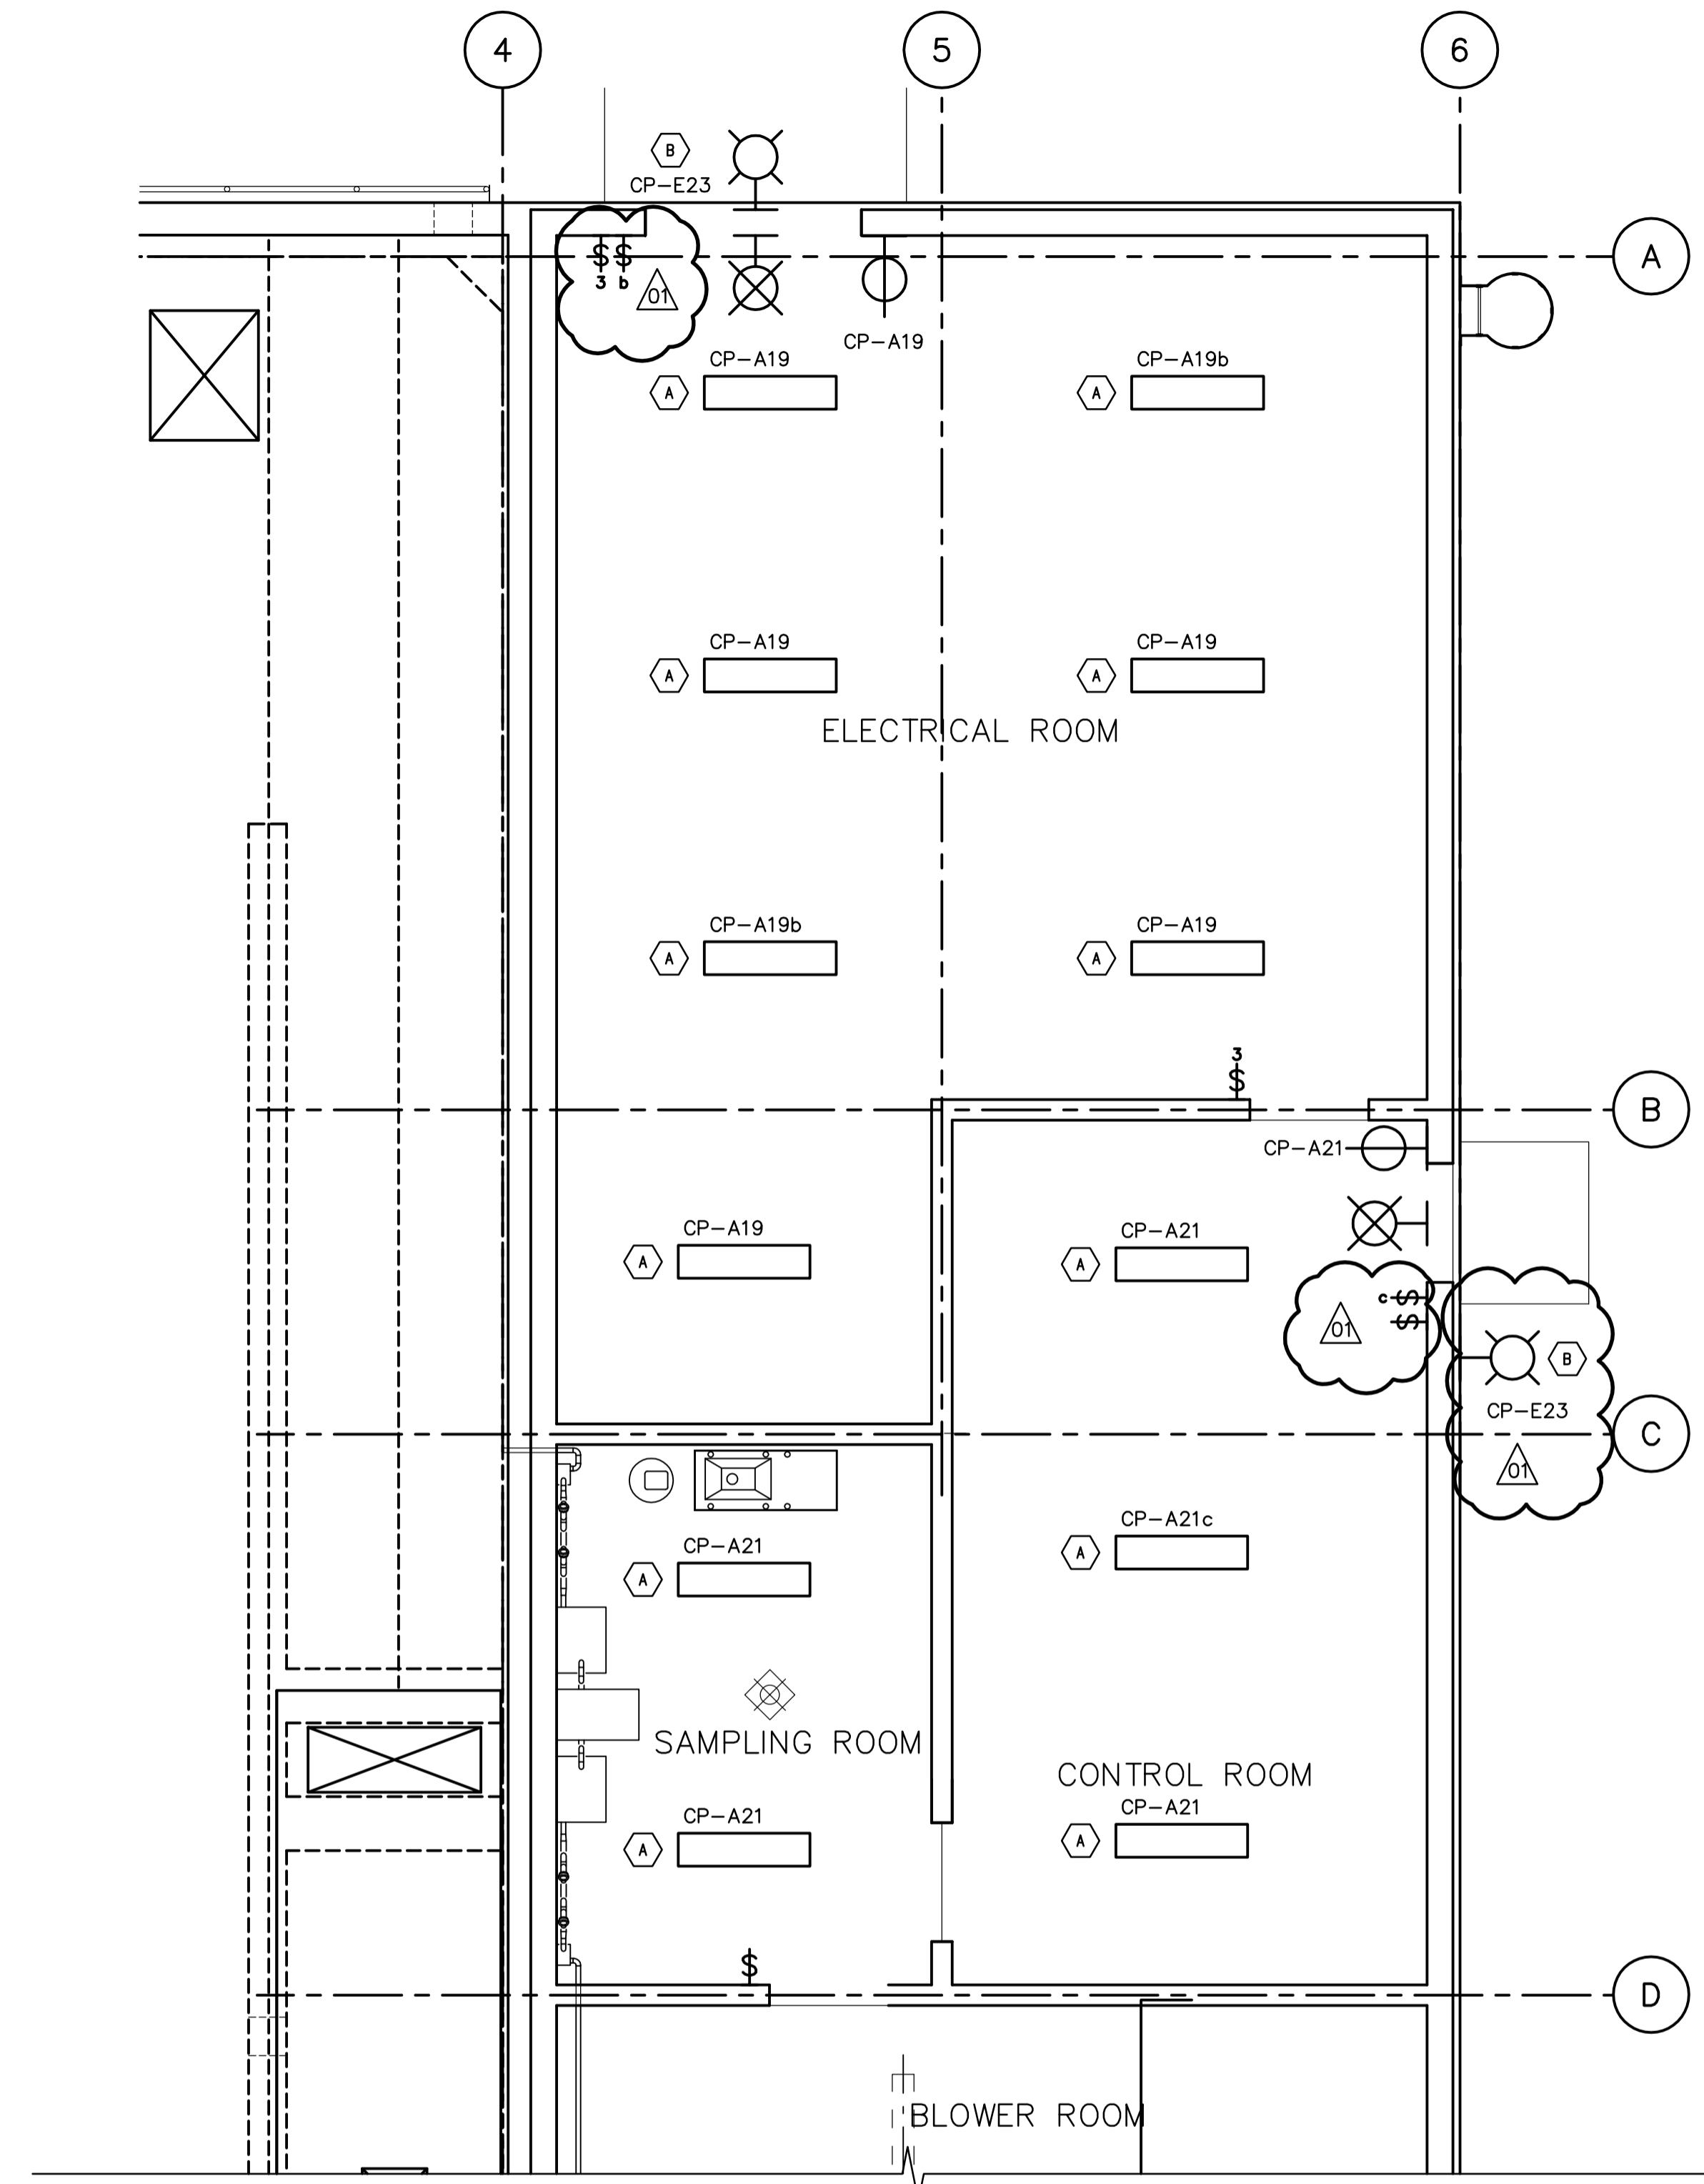

**ELECTRICAL ROOM - LIGHTING & SYSTEM PLAN**  
SCALE: 1:50

- NOTES:
- LIGHTING FIXTURES TO BE SUSPENDED 3000mm ABOVE FINISHED FLOOR. COORDINATE PLACEMENT WITH MECHANICAL TRADE.
  - REFER TO ARCHITECTURAL ELEVATIONS DRAWING A2.01 FOR EXTERIOR LIGHT FIXTURE LOCATIONS.

 Certificate of Authorization Earth Tech Canada Inc. No. 730 Expiry: April 30, 2007	B.M. ELEV.	 A Tyco International Ltd. Company	ENGINEER'S SEAL	 THE CITY OF WINNIPEG WATER AND WASTE DEPARTMENT ENGINEERING DIVISION		
			DESIGNED BY PS		CHECKED BY GSN	ORIGINAL SIGNED BY P. STRYK
			DRAWN BY CPG		APPROVED BY JEH	2005/05/15
			SCALE: 1:50		RELEASED FOR CONSTRUCTION BY: K. MARTENS	CONSULTANT DRAWING NO. E2.03
	NO. REVISIONS	DATE BY	DATE	2006/02/23 DATE 2006/05/15		
	01 291-2006 ADDENDUM 3	06/07/12 CPG				
	00 ISSUED FOR TENDER	06/05/15 CPG				
				NEWPC CENTRATE NUTRIENT TREATMENT NITROGEN REMOVAL FACILITY		
				ELECTRICAL BLOWER/ELECTRICAL/CONTROL ROOM PLAN LIGHTING AND SYSTEMS		
				CITY FILE NUMBER		
				SHEET OF		
				CITY DRAWING NUMBER		