




1 BUILDING SECTION
 A1.01 1:125

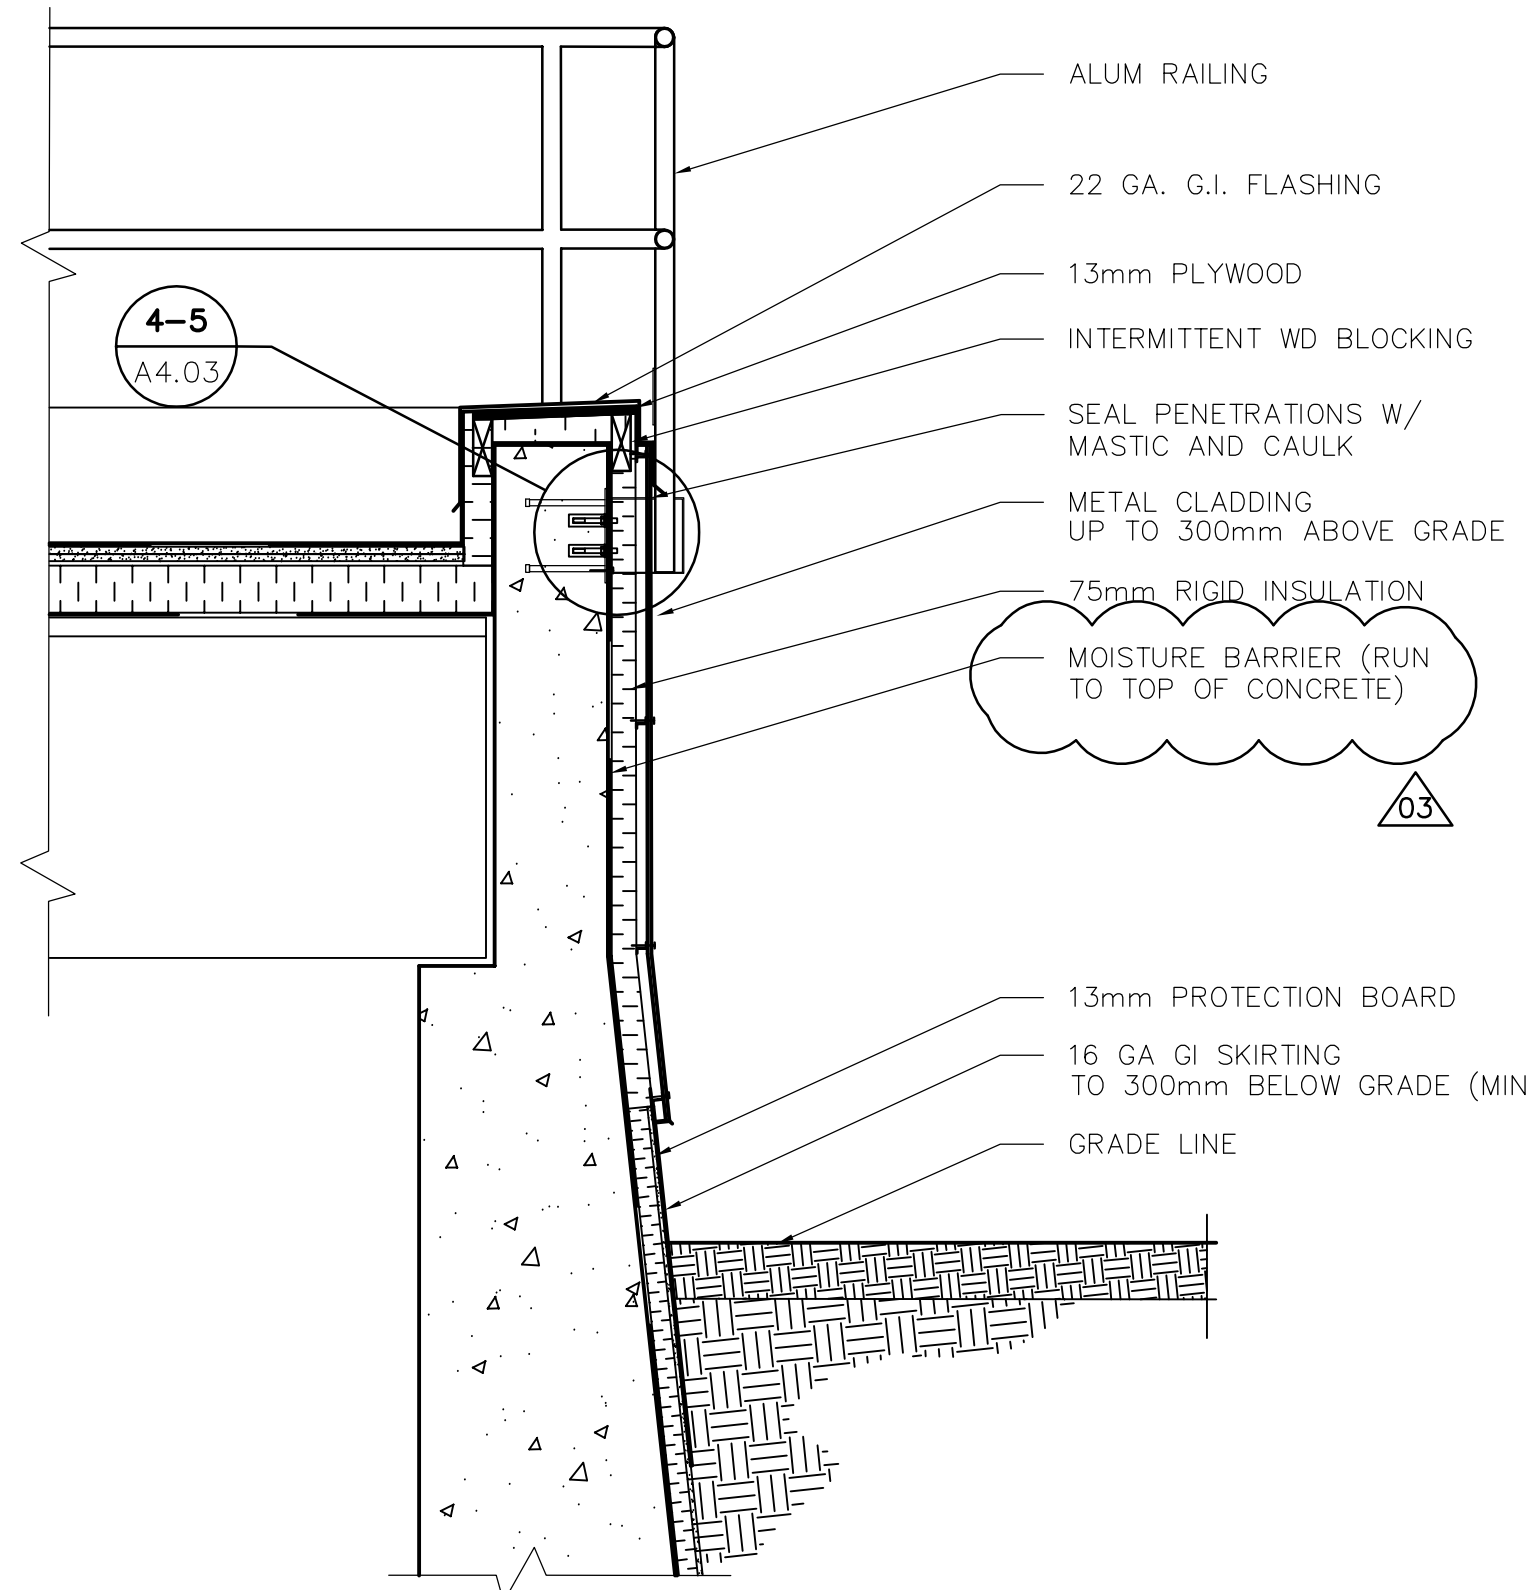

4 SBR WALL DETAIL SECTION
 A3-02 1:20

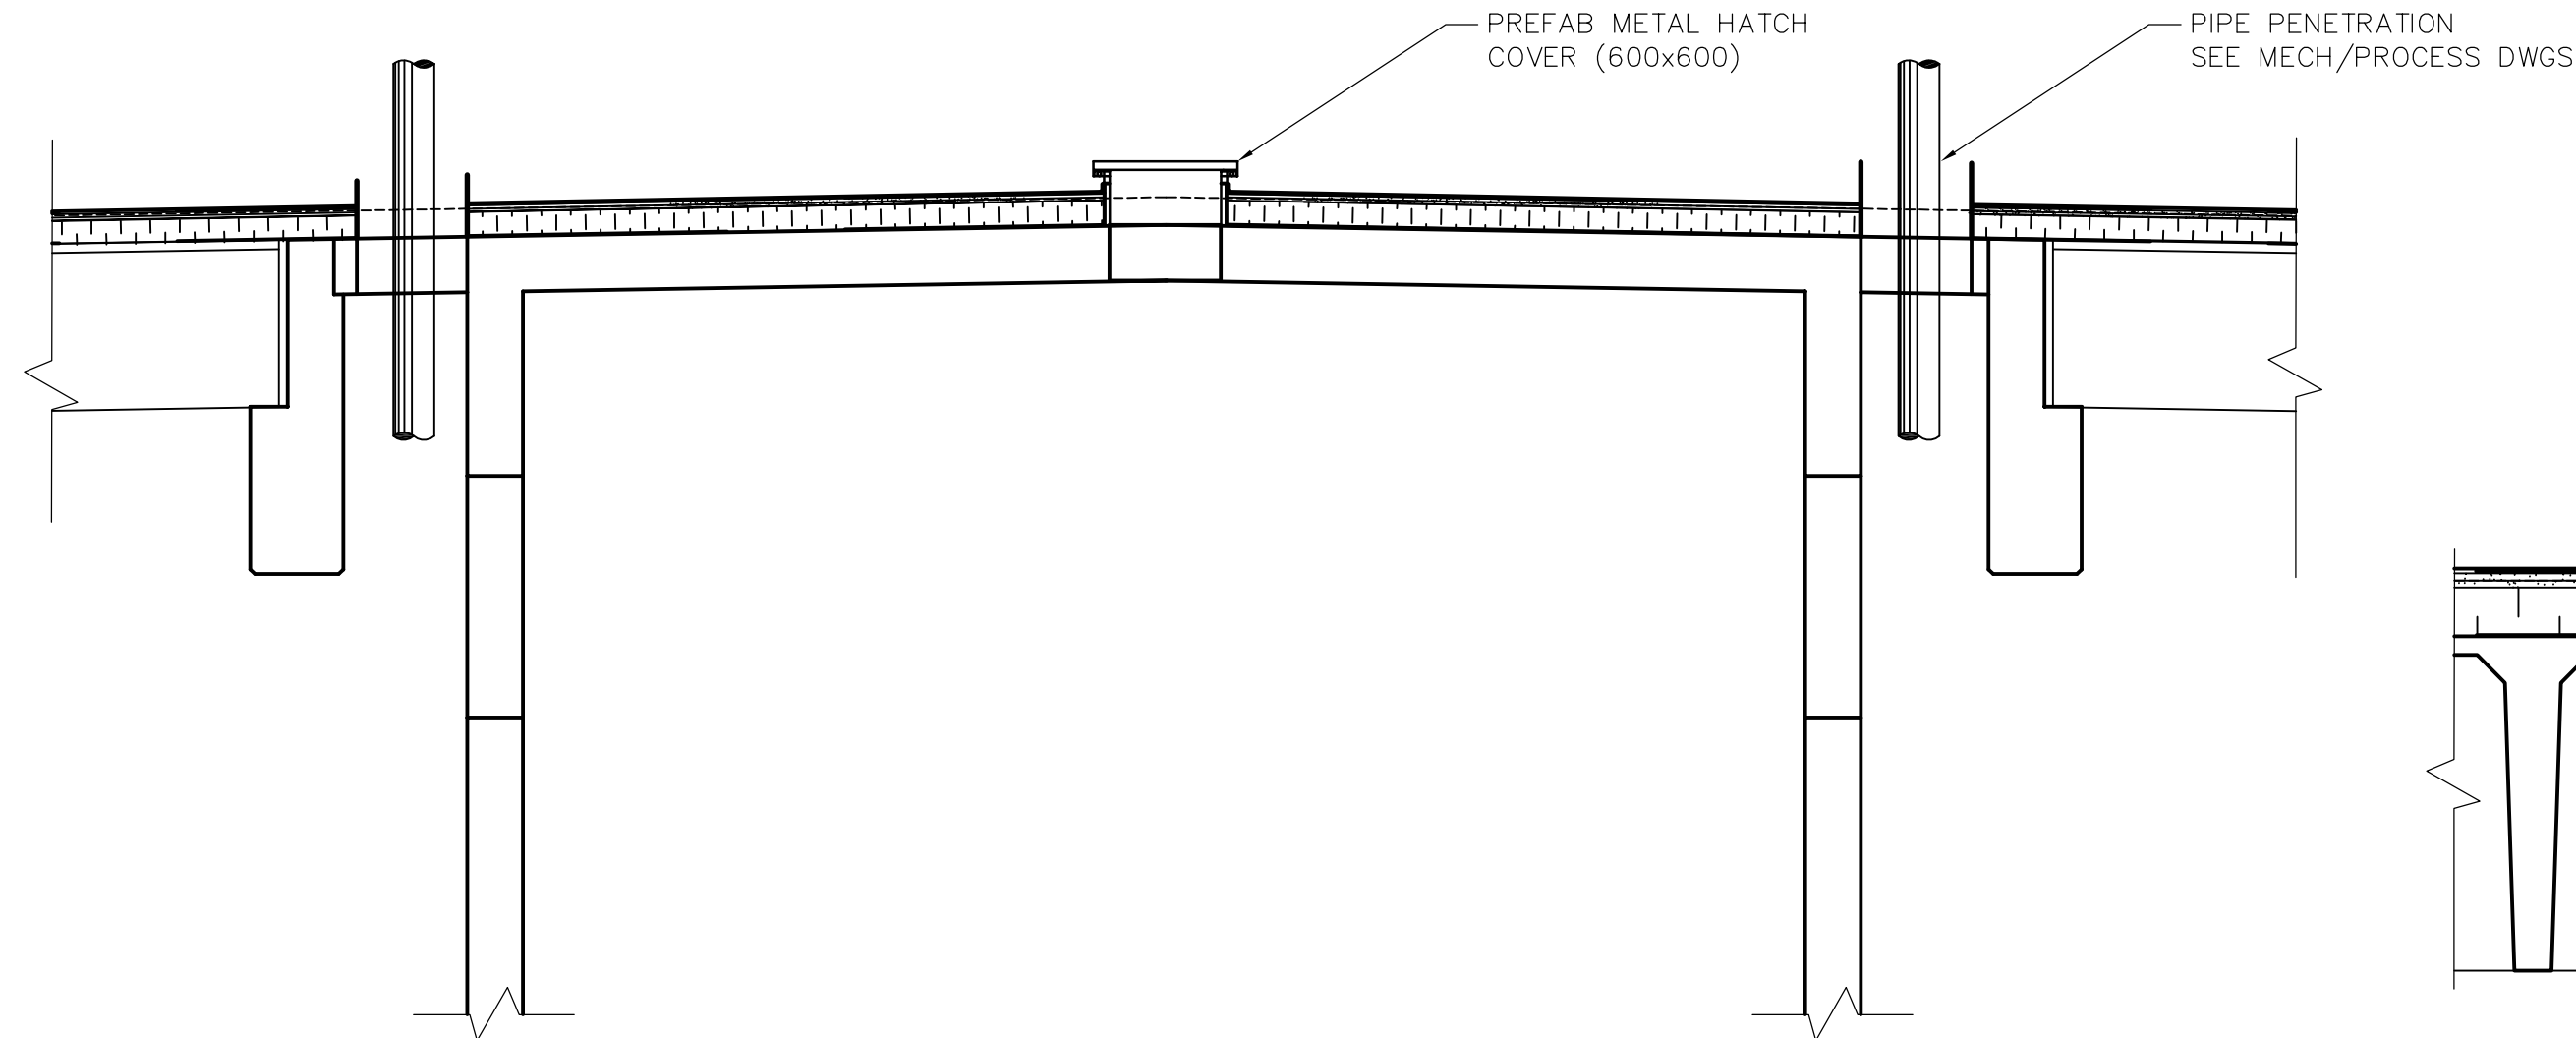

2 DETAIL SECTION
 A3.02 1:40

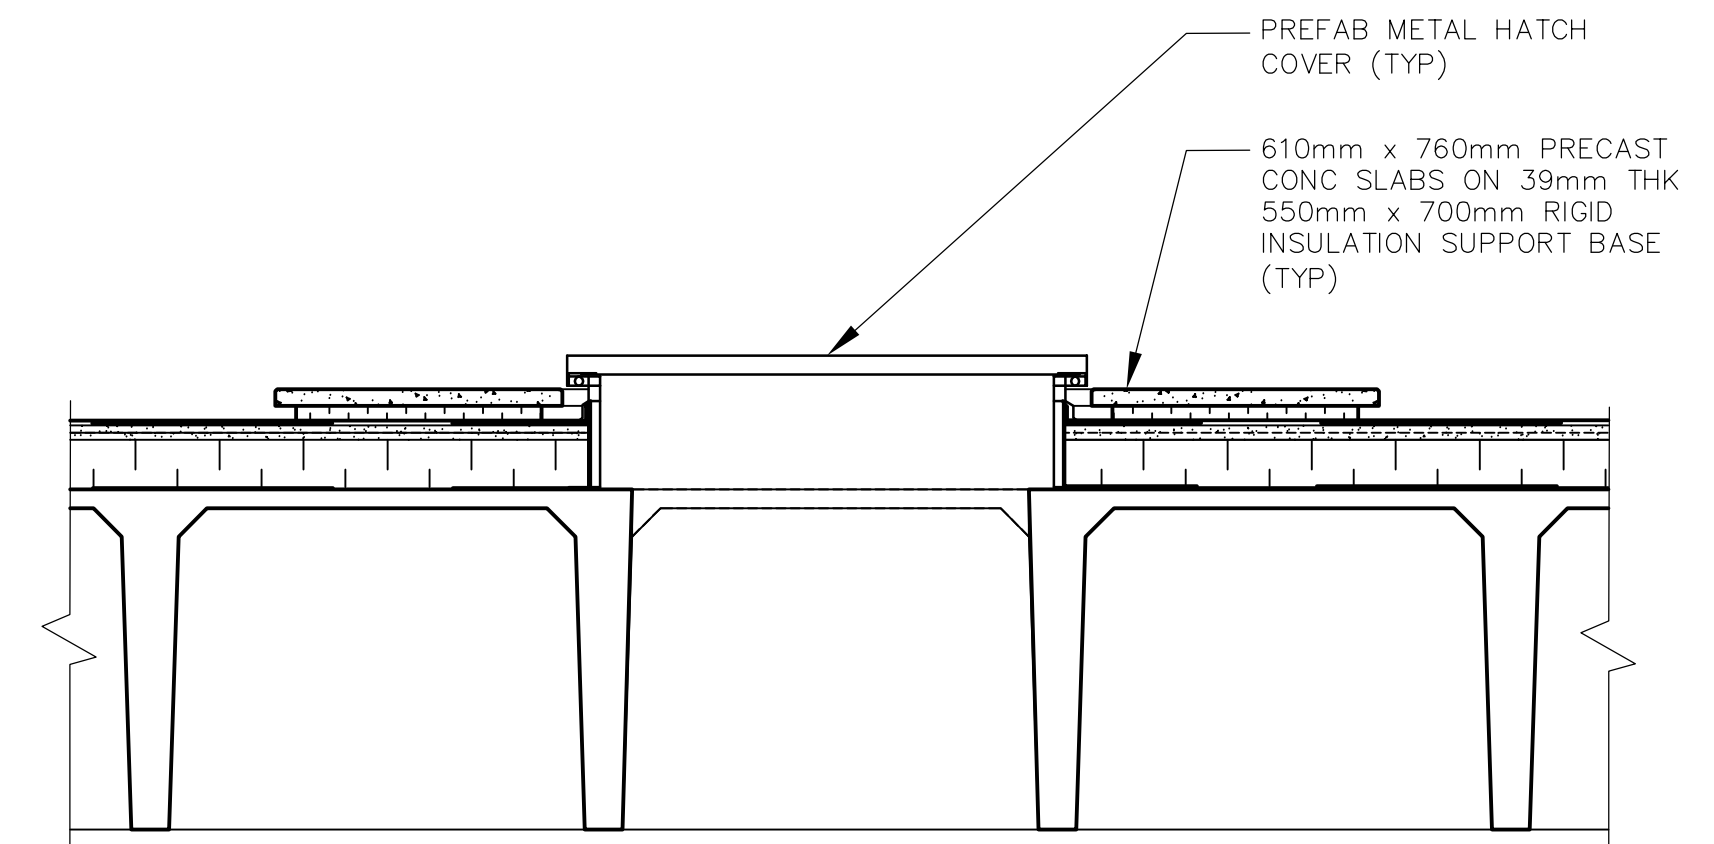

3 ROOF HATCH DETAIL (TYP)
 A1.02 1:20



| | | | | | |
|-----------------|----------|-------------------------------|------------|------|------------|
| B.M. ELEV. | | | | | |
| DESIGNED BY | NC | CHECKED BY | LK | | |
| DRAWN BY | AL | APPROVED BY | JEH | | |
| HOR. SCALE: | AS NOTED | RELEASED FOR CONSTRUCTION BY: | K. MARTENS | | |
| VERTICAL SCALE: | | DATE | 2006/03/21 | DATE | 2006/05/15 |
| NO. REVISIONS | | DATE | | DATE | |

EarthTech
 A Tyco International Ltd. Company

ENGINEER'S SEAL
 ORIGINAL SIGNED BY
 N. COOPER
 2006/05/15

THE CITY OF WINNIPEG
 WATER AND WASTE DEPARTMENT
 ENGINEERING DIVISION

**NEWPCC CENTRATE NUTRIENT TREATMENT
 NITROGEN REMOVAL FACILITY**

ARCHITECTURAL
 BUILDING SECTION & DETAILS

CITY FILE NUMBER
 SHEET OF
 CITY DRAWING NUMBER

CONSULTANT DRAWING NO.
 A3.01