SHEET: COW-A1 (05/2005)

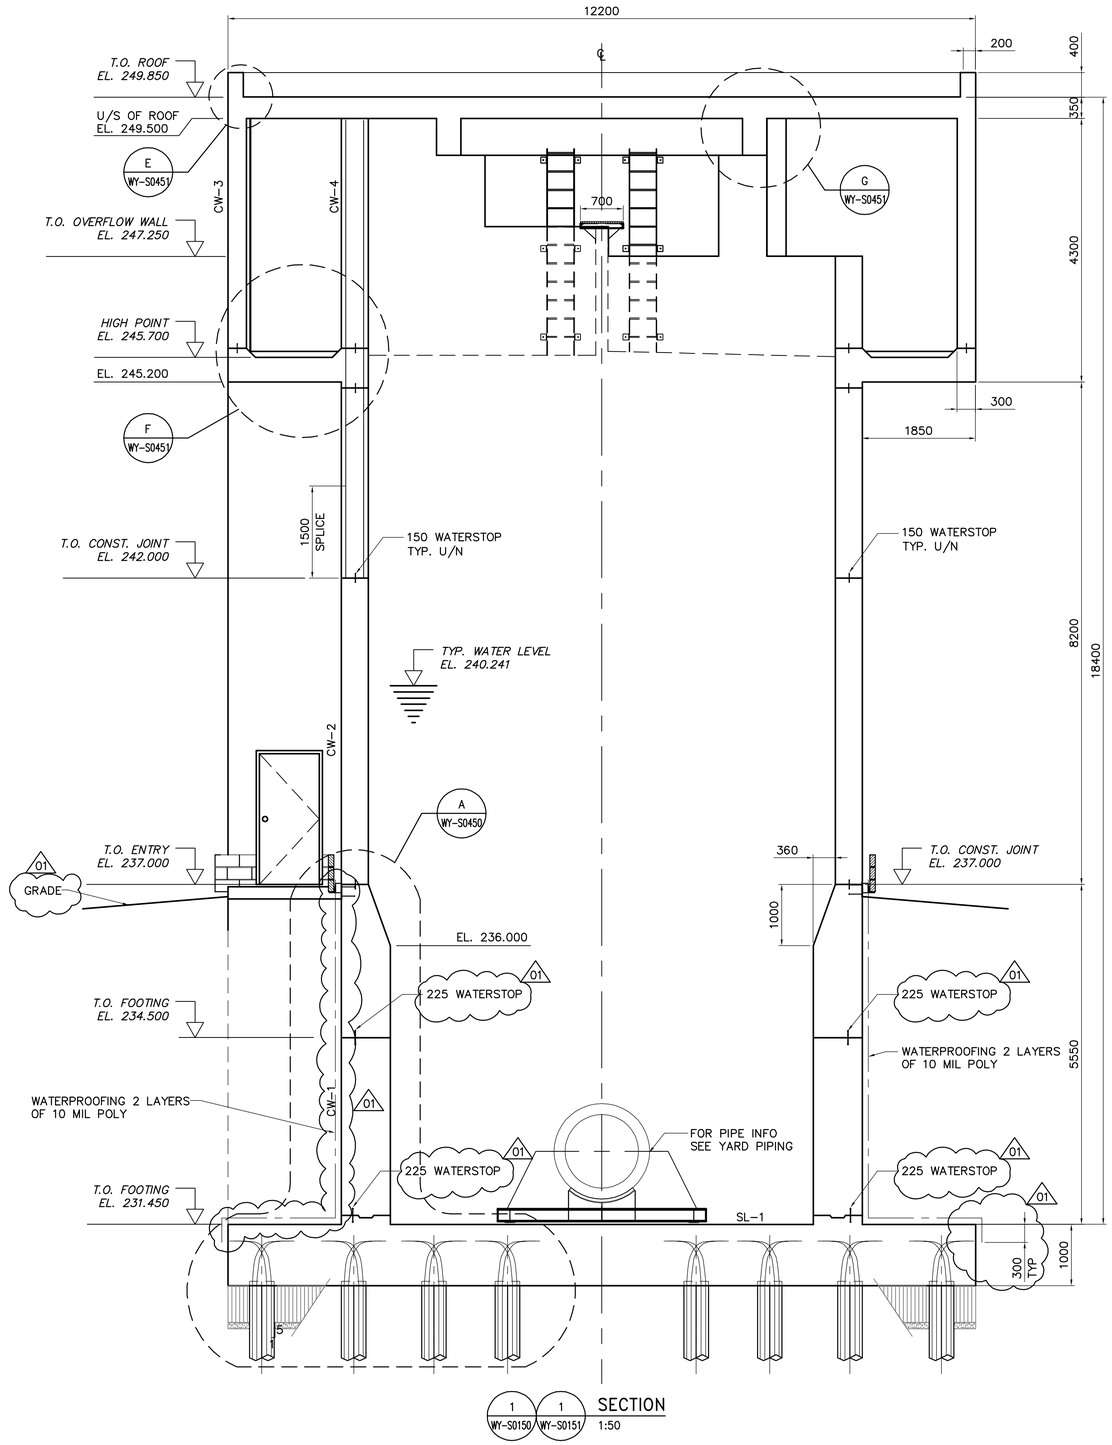

1 WY-S0150 1 WY-S0151 SECTION 1:50

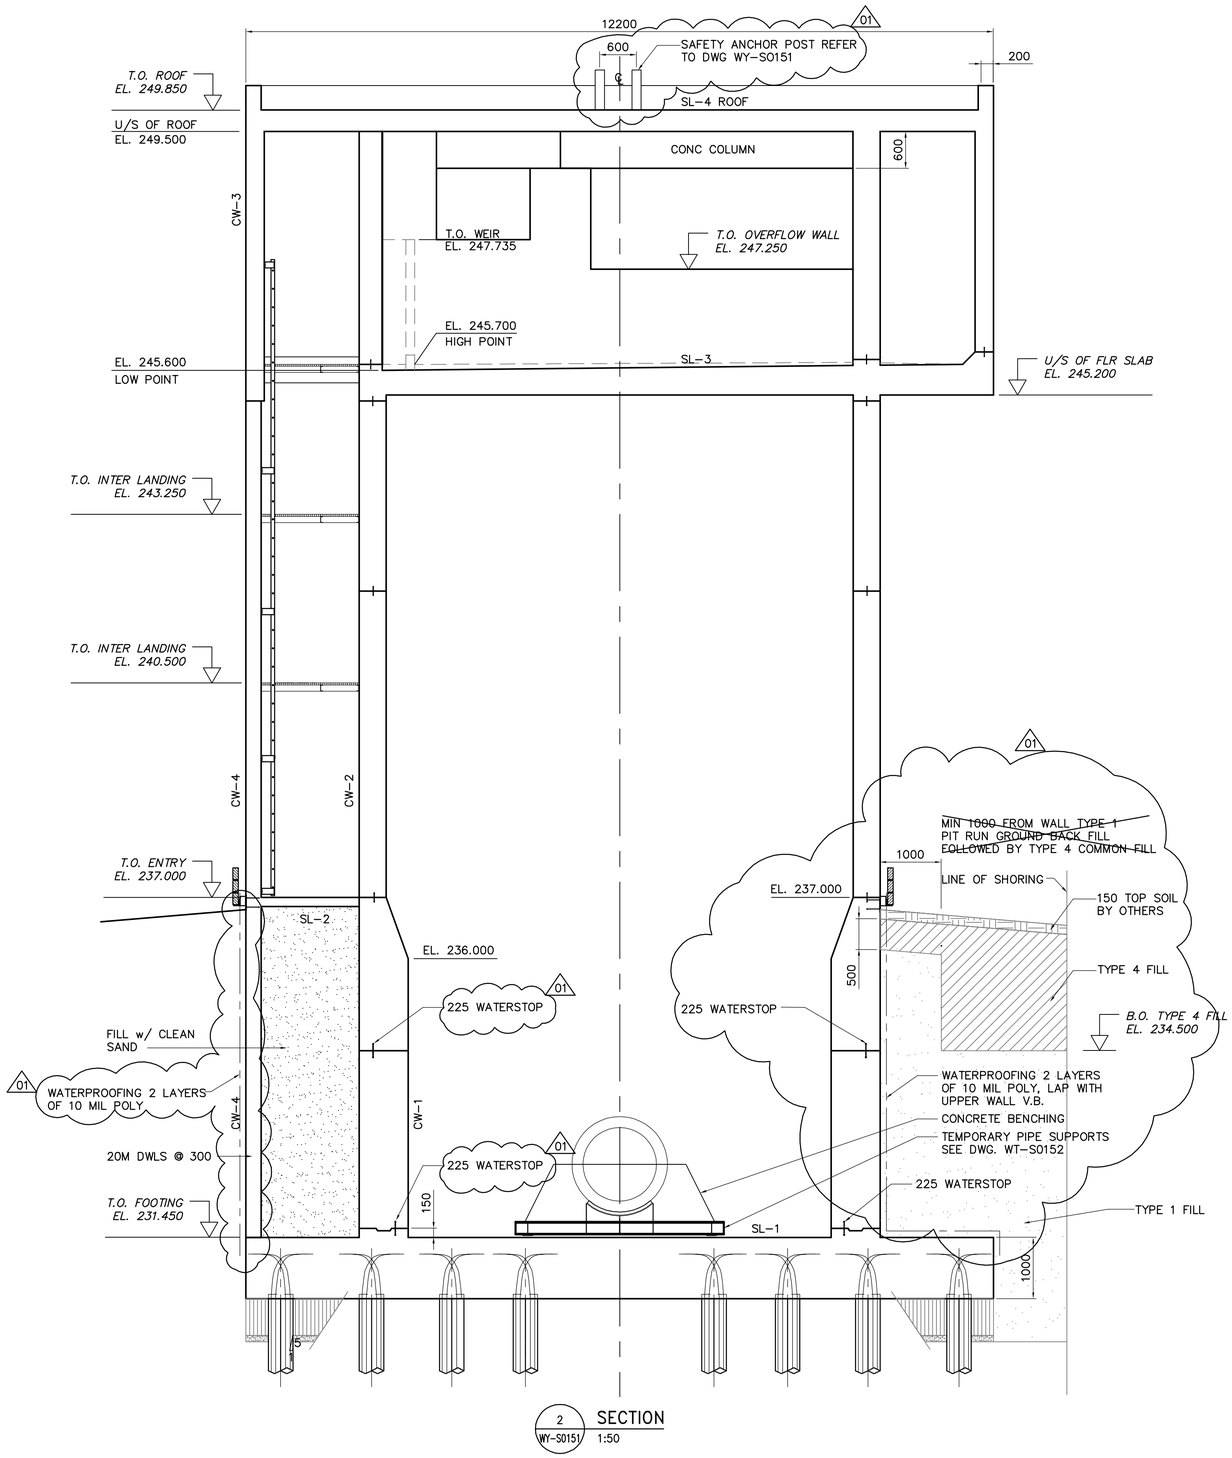

2 WY-S0151 SECTION 1:50

NO.	REVISIONS	DATE	BY
01	37-2006 ADDENDUM 1	06/05/24	NS
00	ISSUED FOR TENDER	06/05/03	KK

APEGM
Certificate of Authorization
Earth Tech Canada Inc.
No. 730 Expiry: April 30, 2007

B.M. ELEV.

CH2MHILL
Frederickson Cooper ARCHITECTS
EarthTech A Tyco International Ltd. Company

DESIGNED BY	FK	CHECKED BY	GGP
DRAWN BY	WDB / KK	APPROVED BY	AHL
SCALE:	AS NOTED	RELEASED FOR CONSTRUCTION BY:	R. SOROKOWSKI
DATE	2006/01/13	DATE	2006/05/03

ENGINEER'S SEAL
ORIGINAL SIGNED BY
F.A. KEMP
2006/05/03

CONSULTANT DRAWING NO.
WY-S0250

Winnipeg
THE CITY OF WINNIPEG
WATER AND WASTE DEPARTMENT
ENGINEERING DIVISION

WATER TREATMENT PLANT
YARD PIPING AND VALVE CHAMBERS
SURGE TOWER CONSTRUCTION

STRUCTURAL SECTIONS

CITY FILE NUMBER
SHEET OF
CITY DRAWING NUMBER
1-0601Y-A-S0250-001-01D

Last Save: 2006-05-25 10:10 AM

L:\WORK\79000\79538\02A-CAD\IND\CONTR\SURGE TOWER\DN_WY-S0250_ET.DWG