
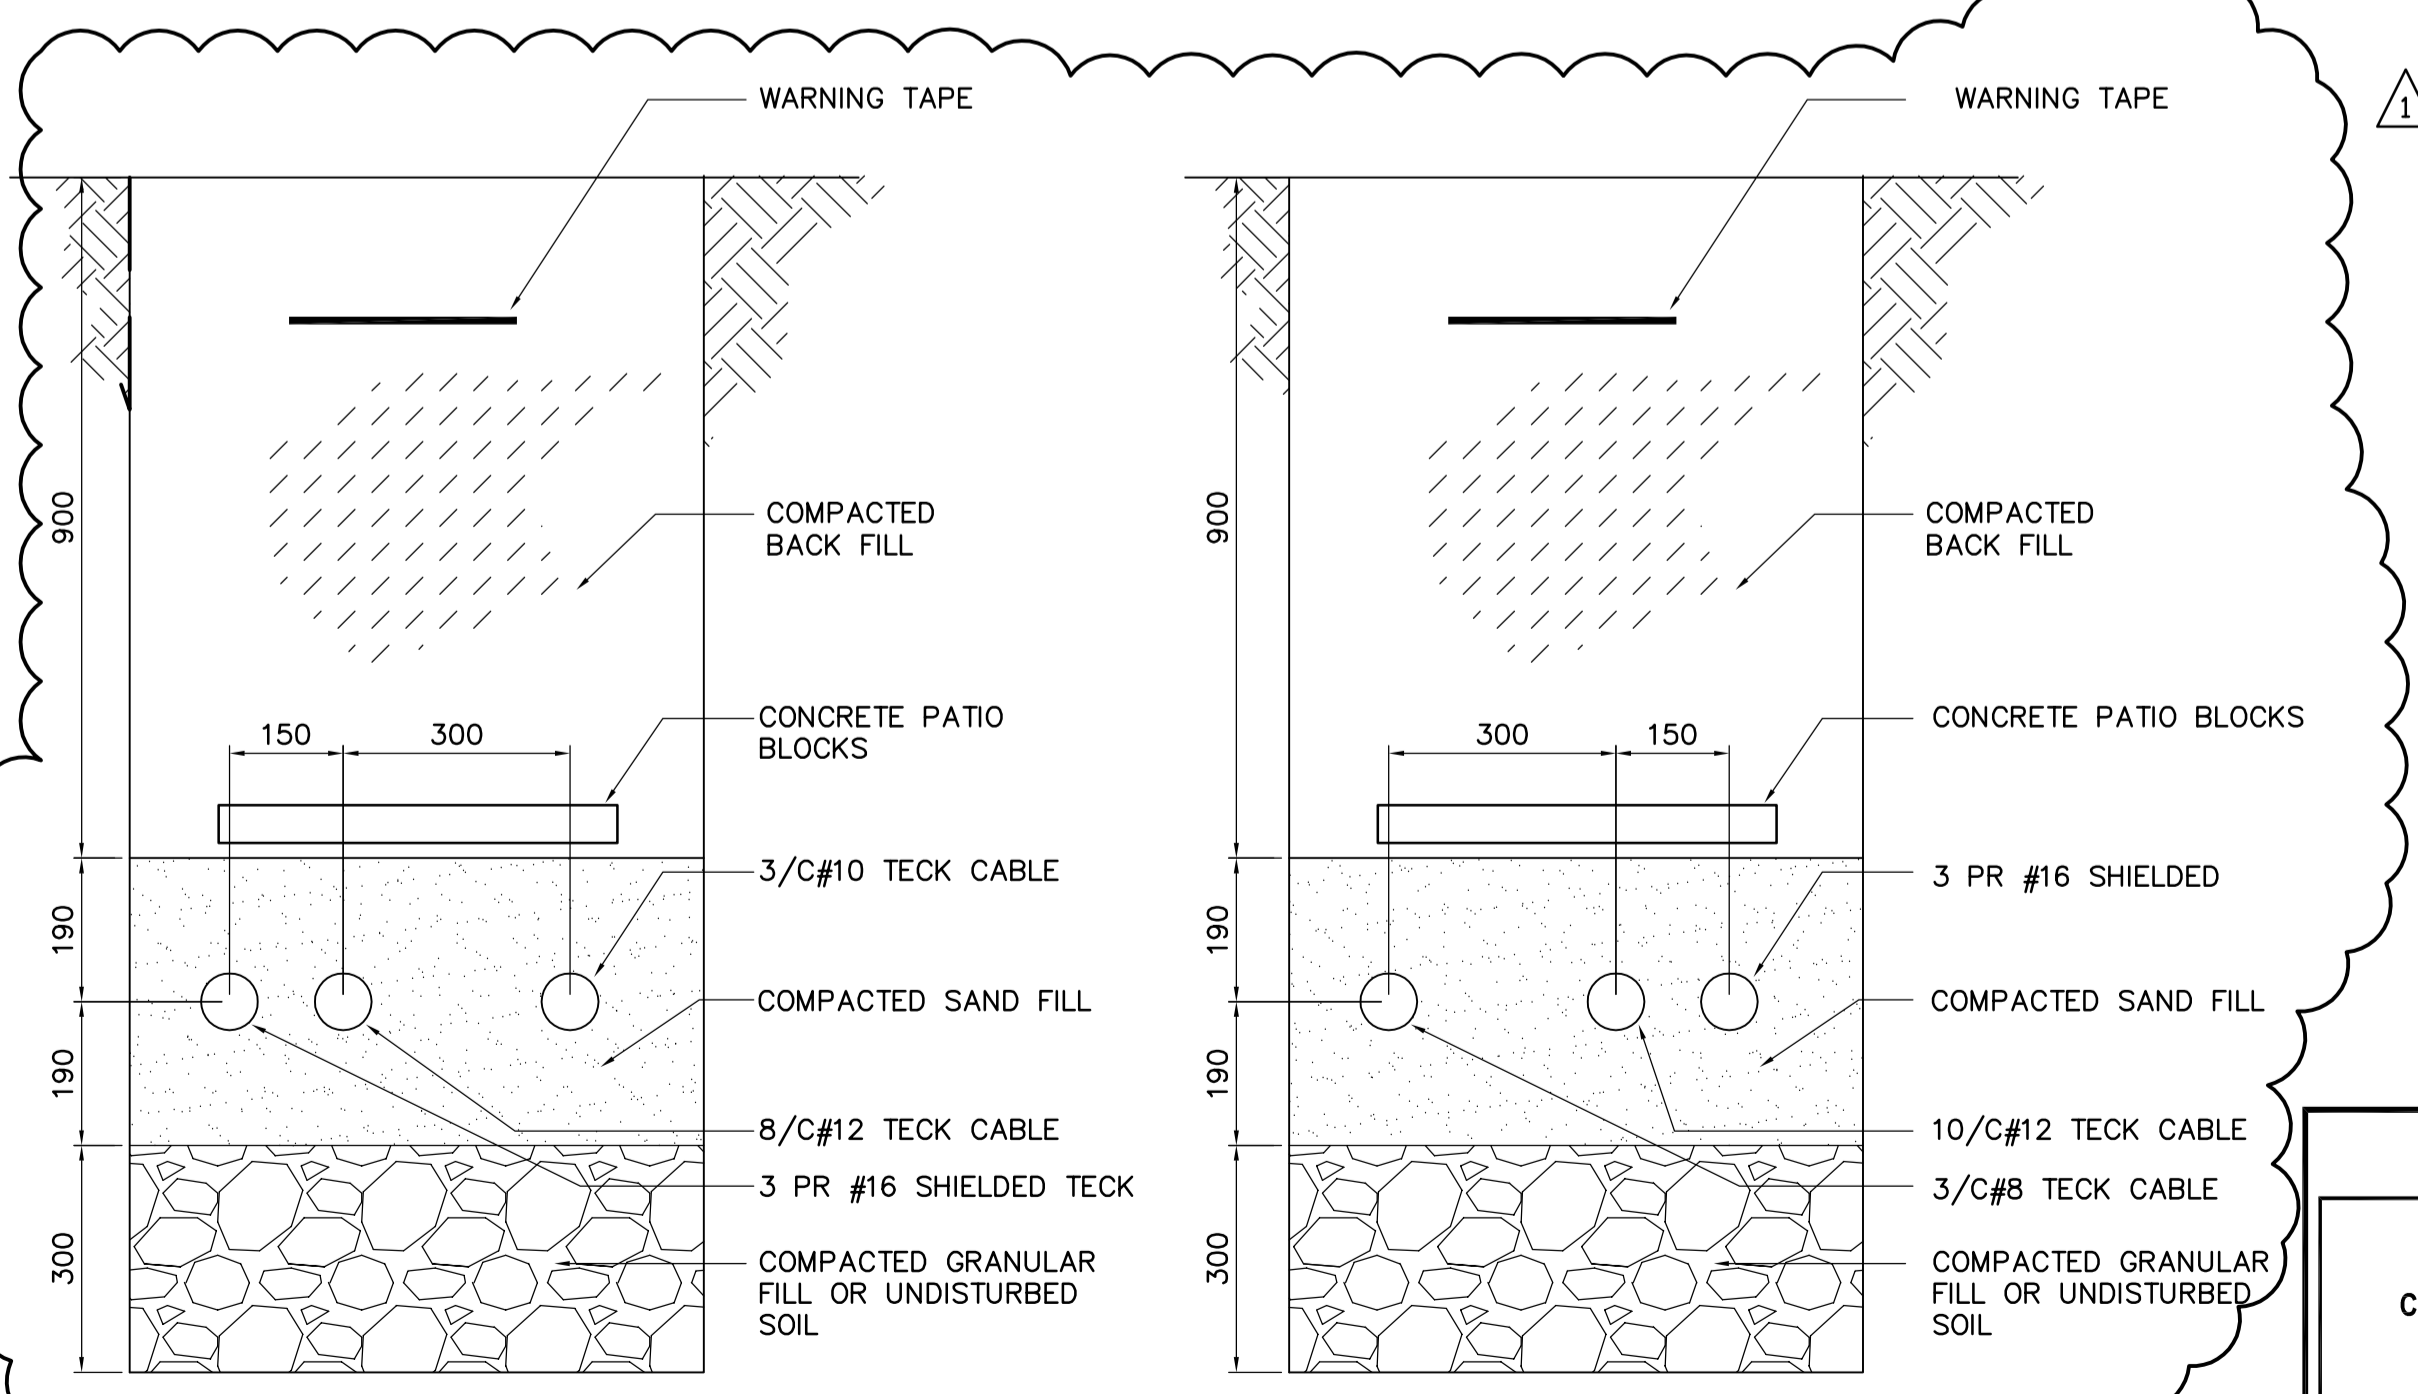
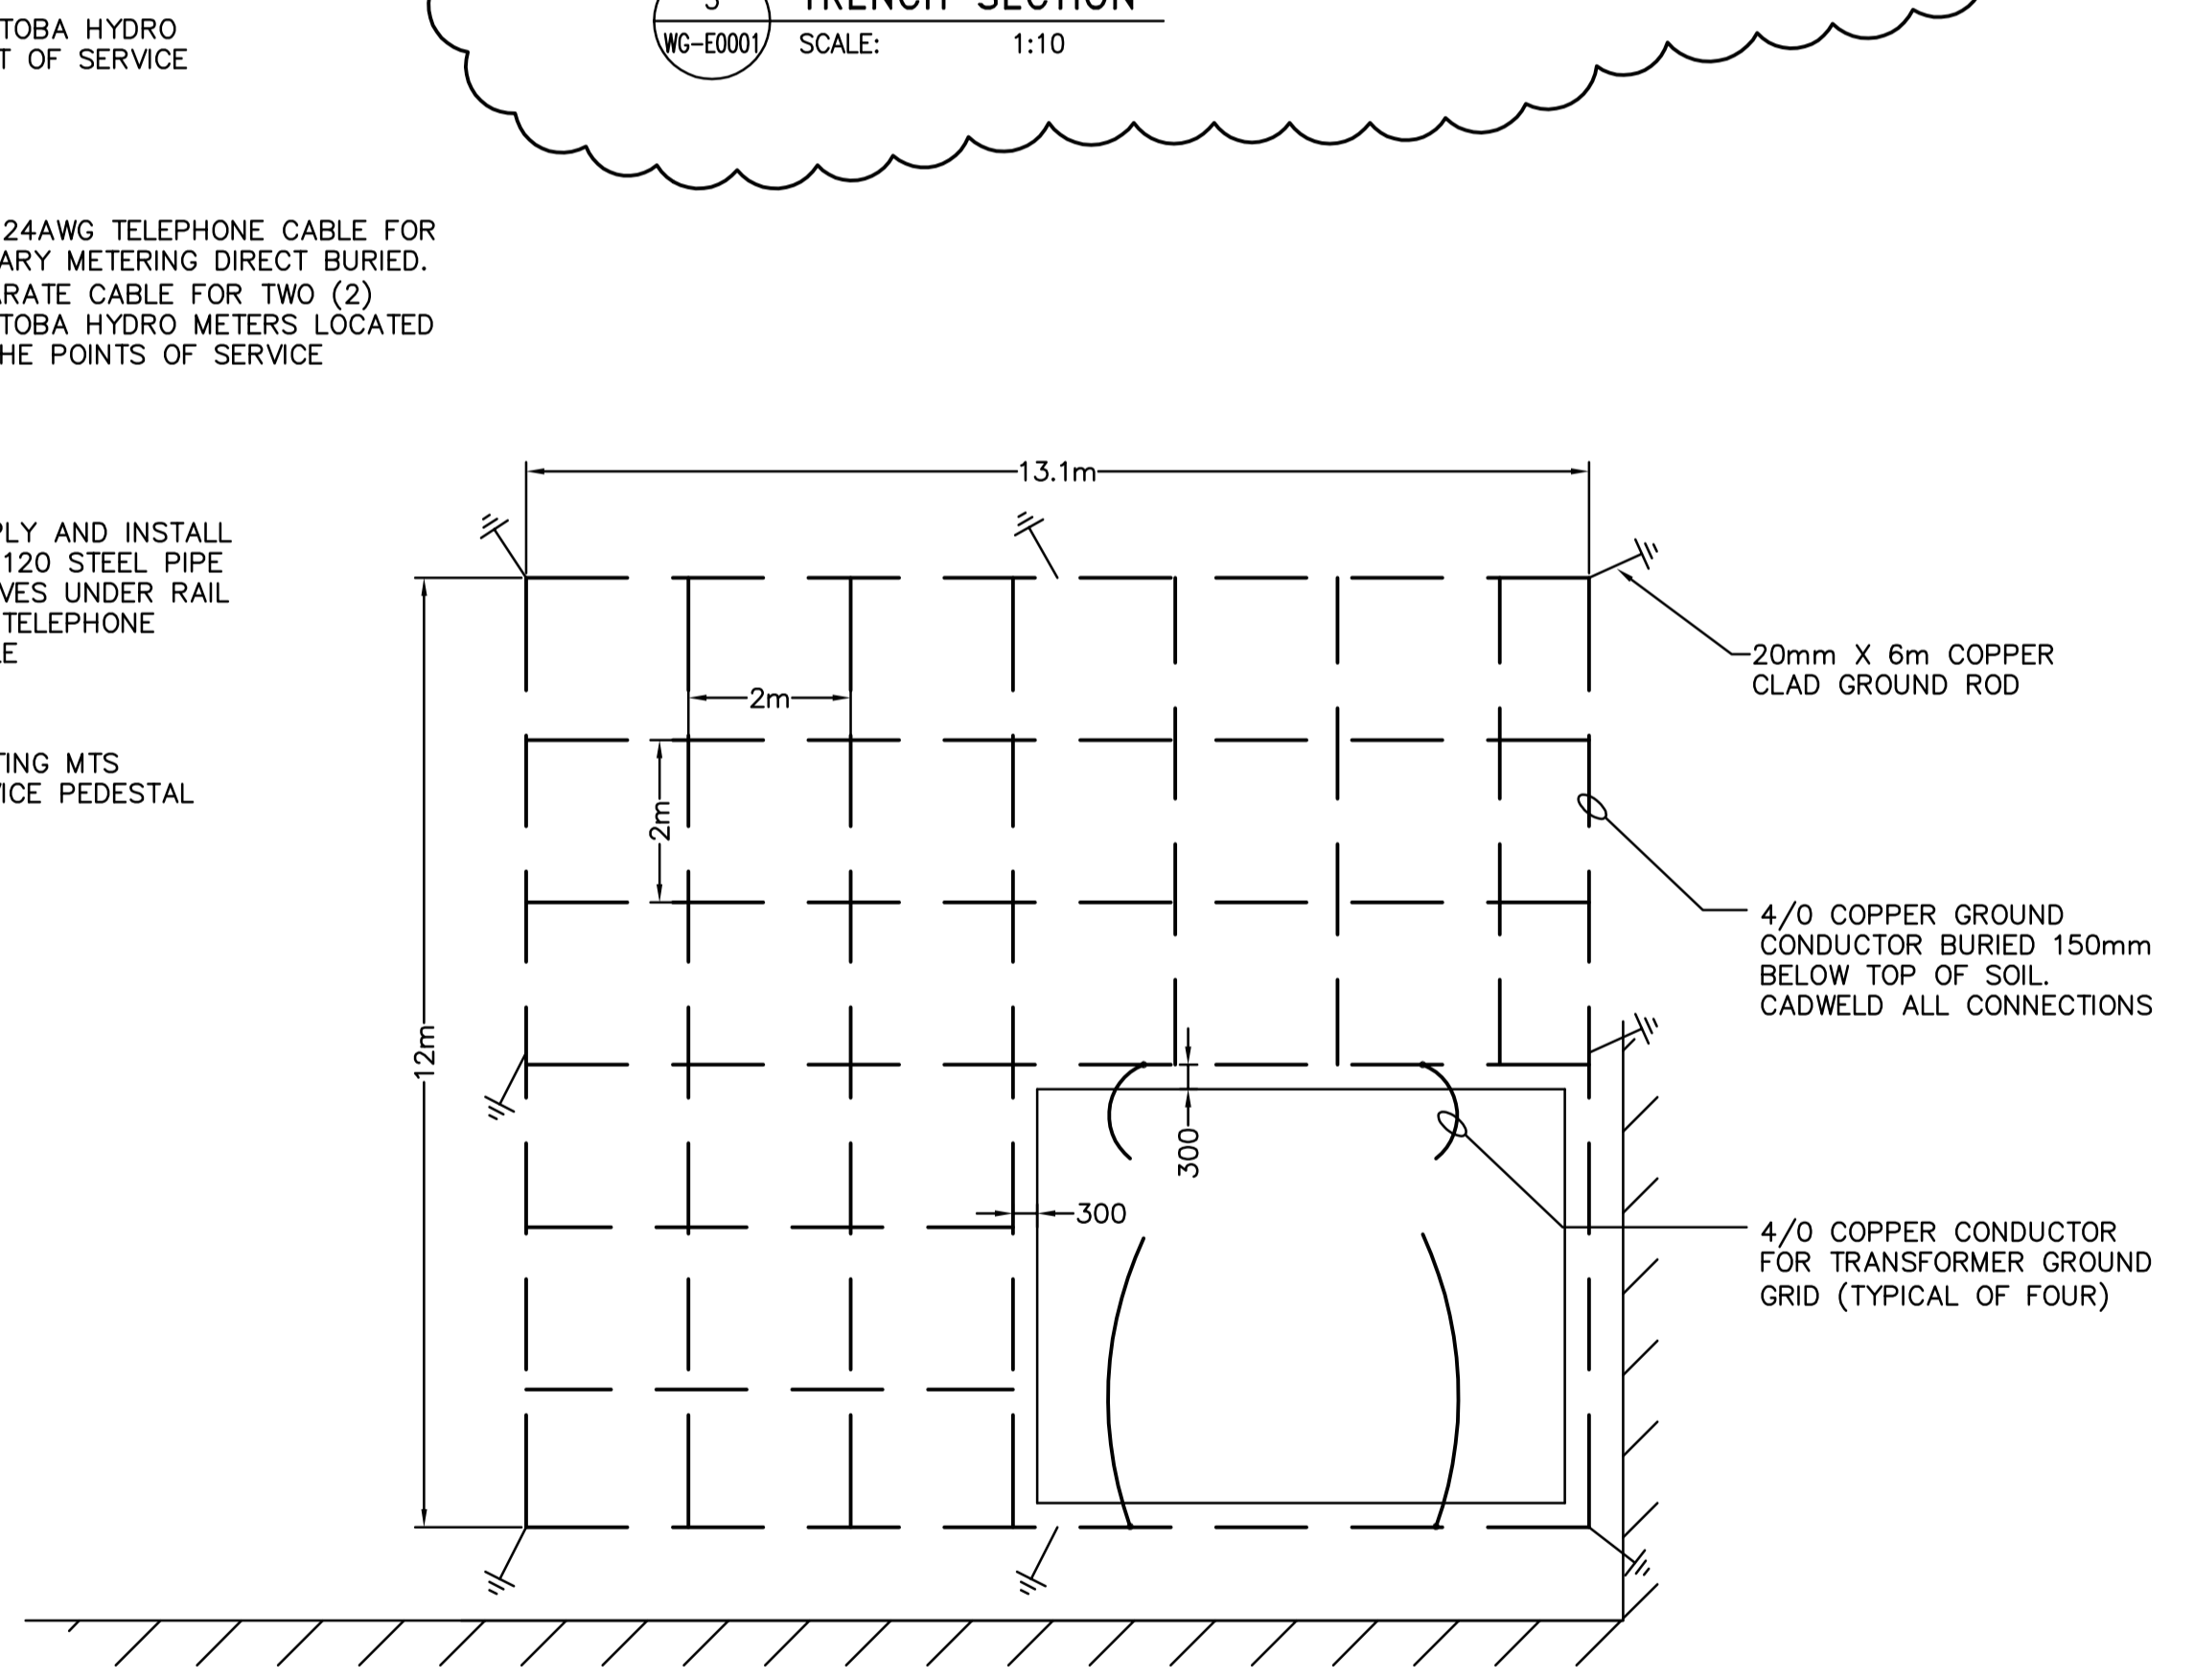
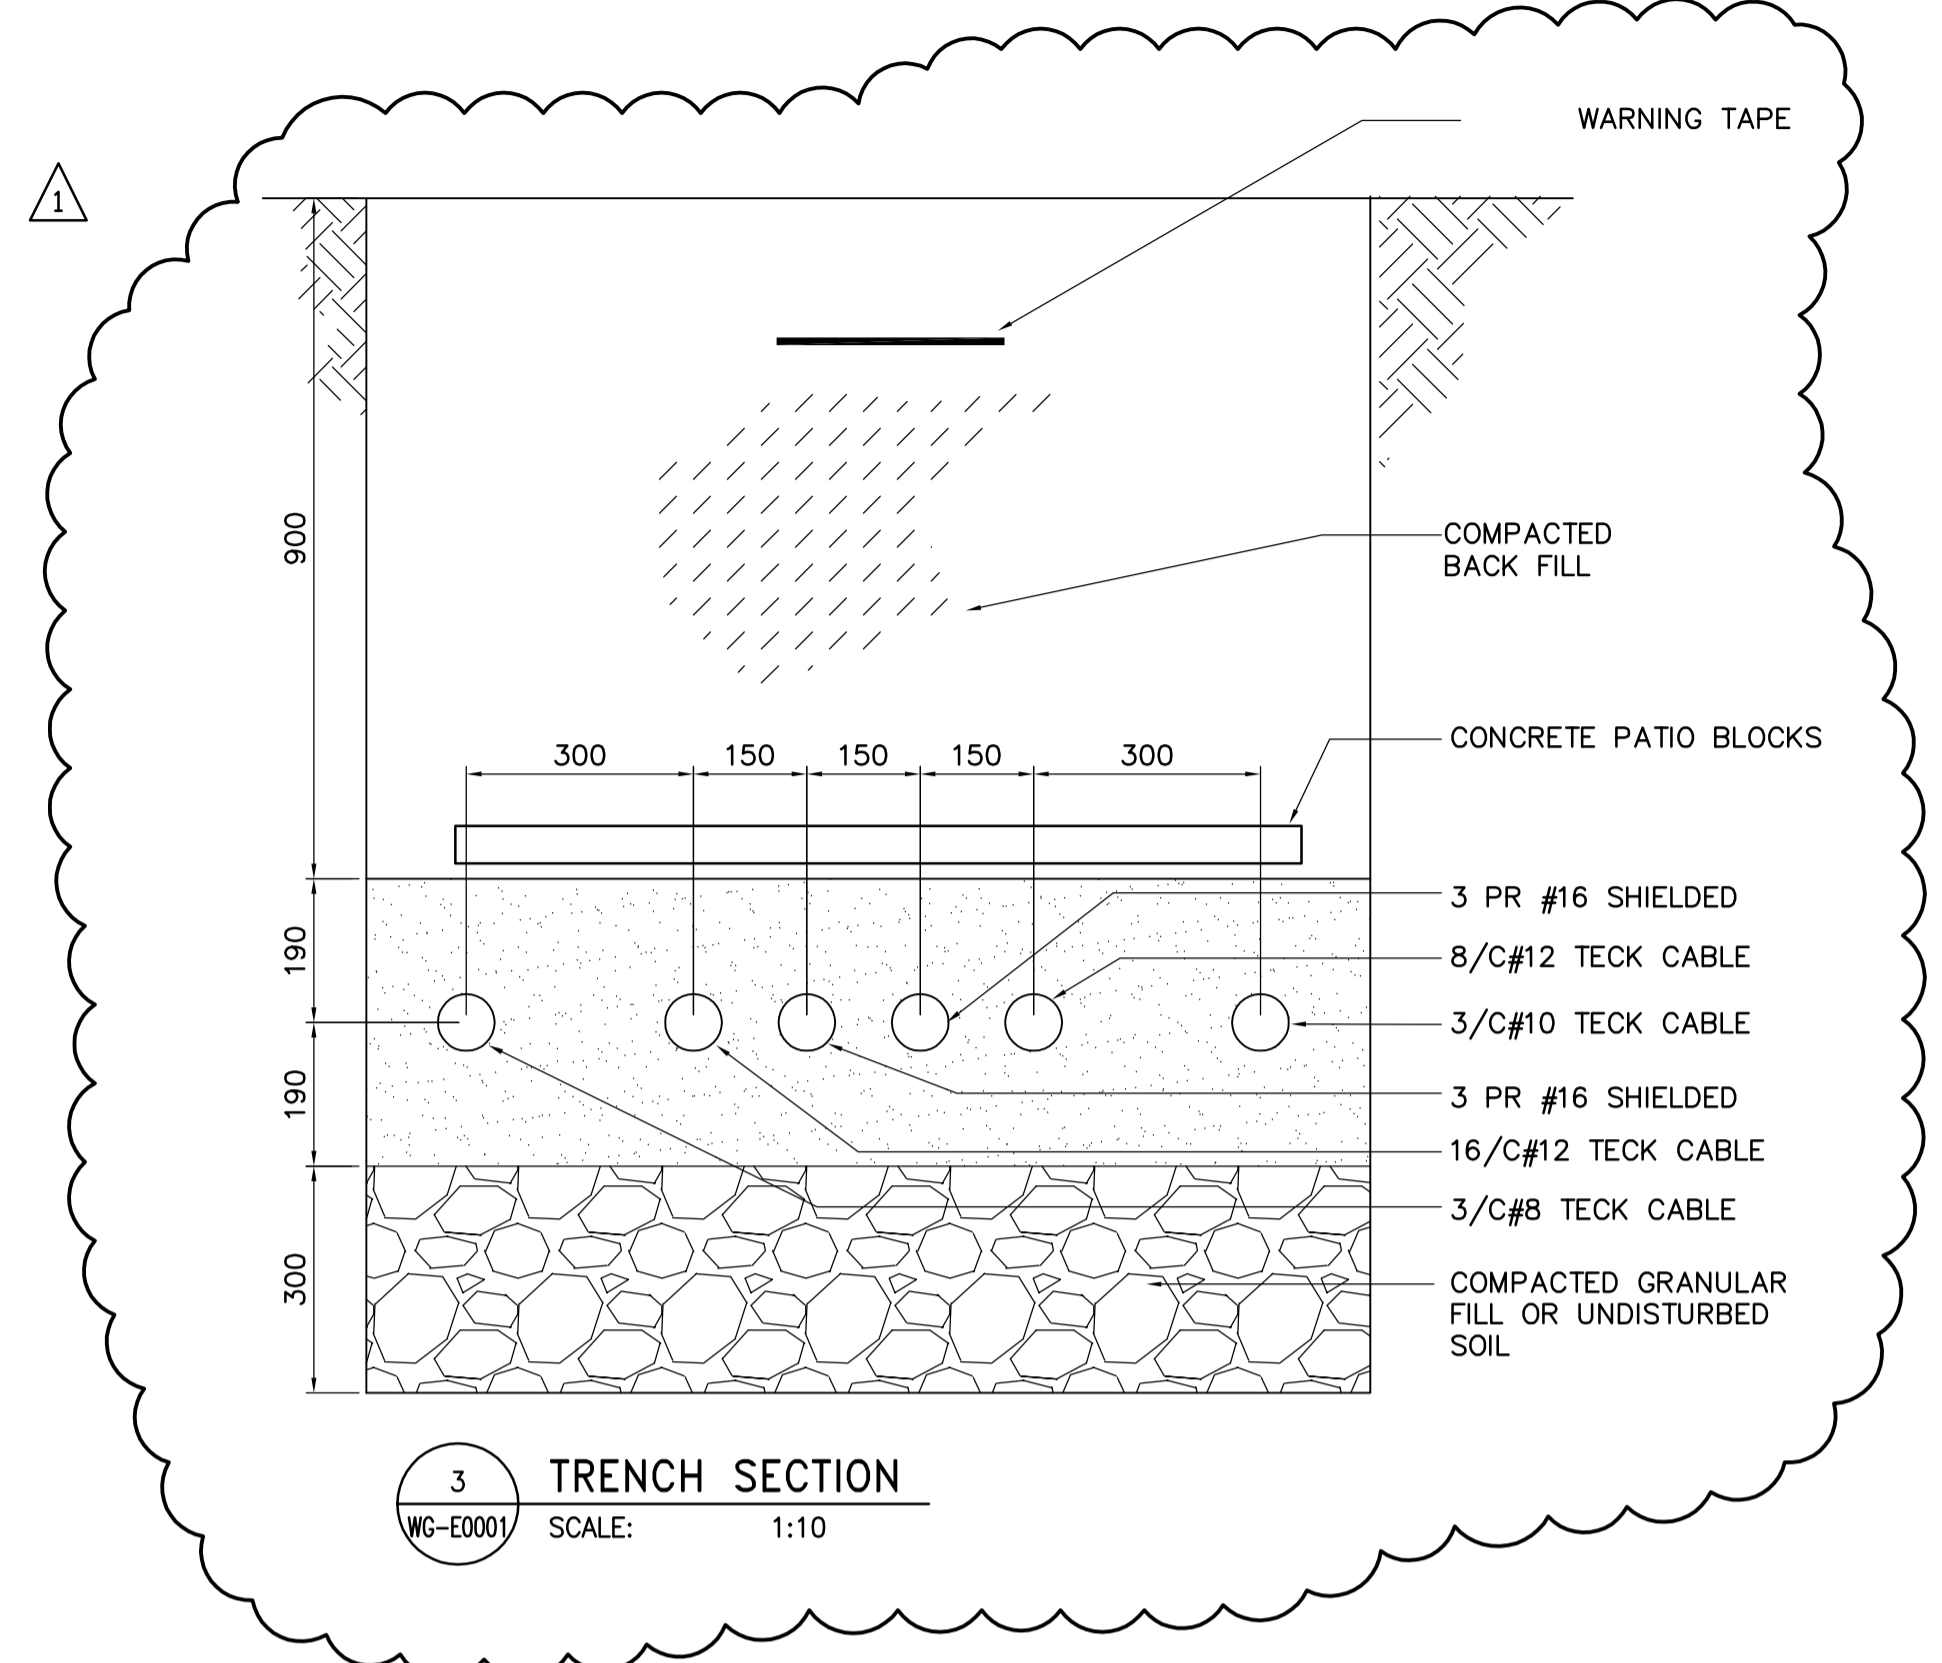


COLOR LEGEND

HYDRO LINE (OVERHEAD)	---
HYDRO LINE (UNDERGROUND)	—
GAS LINE	— · — · — ·

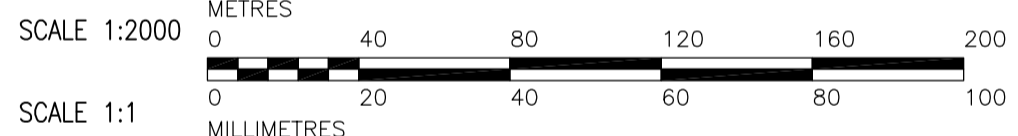

 Certificate of Authorization Earth Tech Canada Inc. No. 730 Expiry: April 30, 2007	B.M. ELEV.	 Frederickson Cooper ARCHITECTS	 A Tyco International Ltd. Company	ENGINEER'S SEAL	 THE CITY OF WINNIPEG WATER AND WASTE DEPARTMENT ENGINEERING DIVISION	
				DESIGNED BY: BLM		CHECKED BY: PS
		DRAWN BY: ERC	APPROVED BY: AHL	2006/08/30		CITY FILE NUMBER
		SCALE: AS SHOWN	RELEASED FOR CONSTRUCTION BY: R. SOROKOWSKI	CONSULTANT DRAWING NO. WG-E0003		SHEET OF
	01 498-2006 ADDENDUM 3 06/09/29 ERC				CITY DRAWING NUMBER	
	00 ISSUED FOR TENDER 06/08/30 ERC				1-0601-A-E0003-001-01D	
	NO. REVISIONS	DATE	DATE 2006/08/15	DATE 2006/08/30		