SHEET: COW-A1 (05/2005)

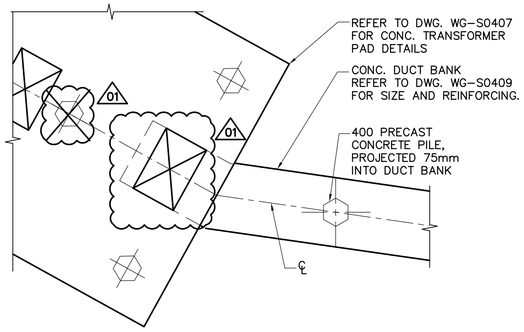

A PLAN DETAIL
WG-S0451 20:1

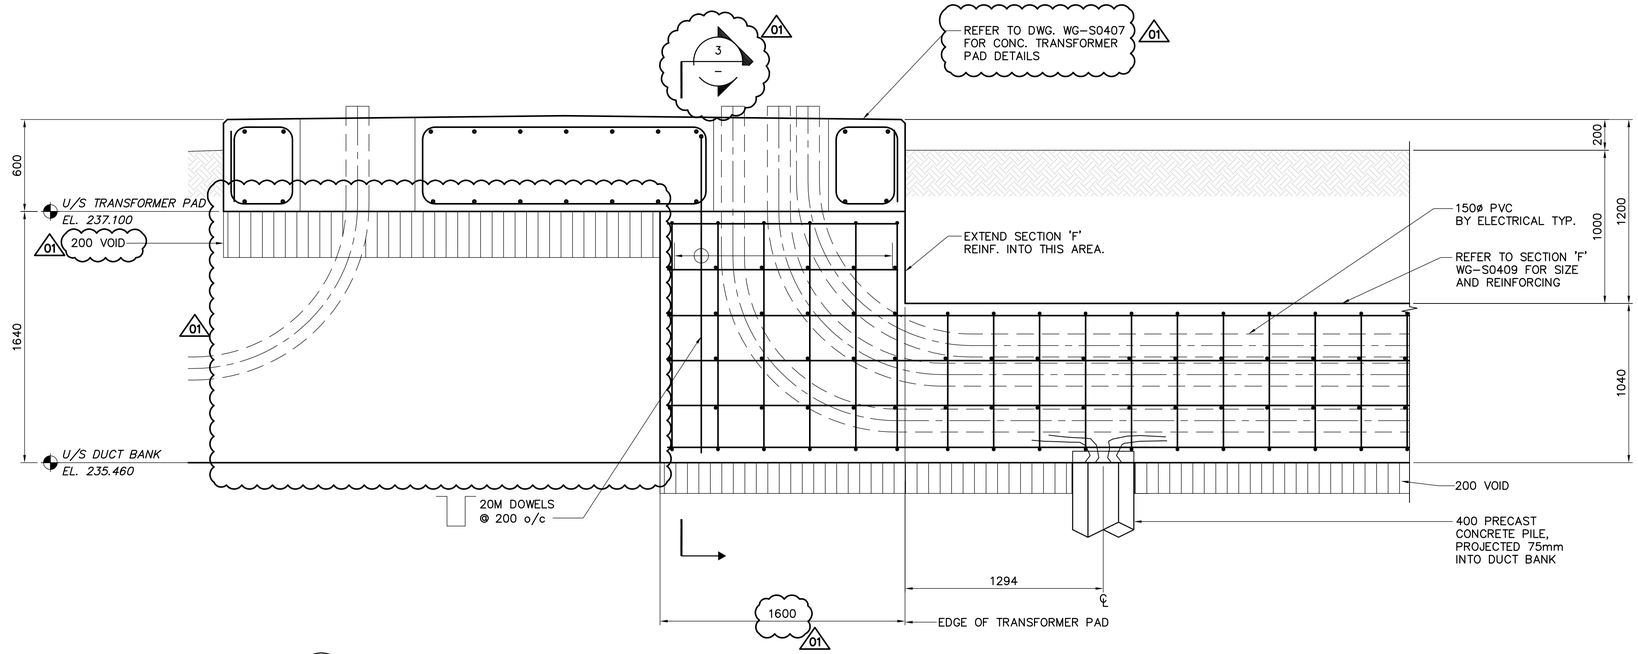

1 SECTION
WG-S0451 1:20

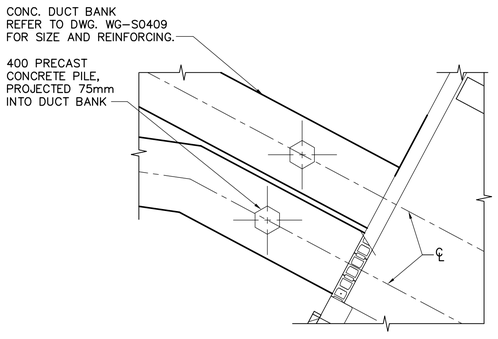

B PLAN DETAIL
WG-S0451 20:1

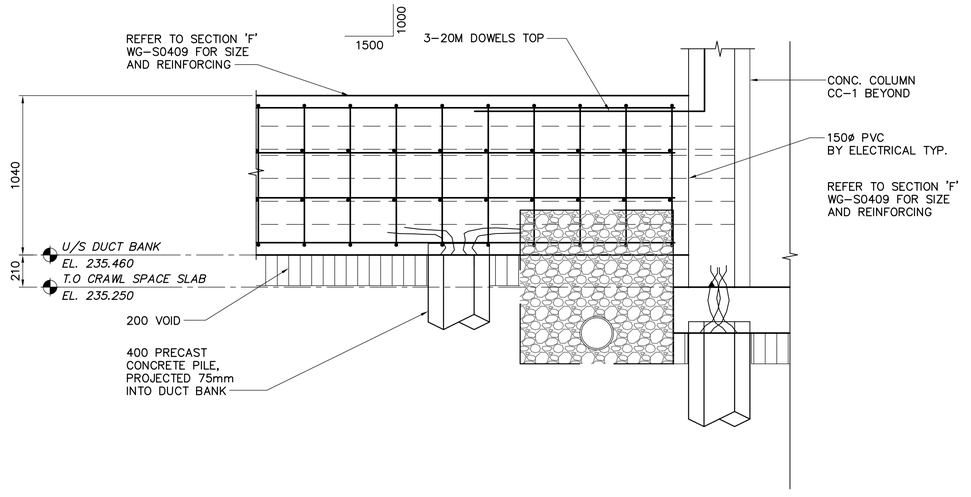

2 SECTION
WG-S0451 1:20

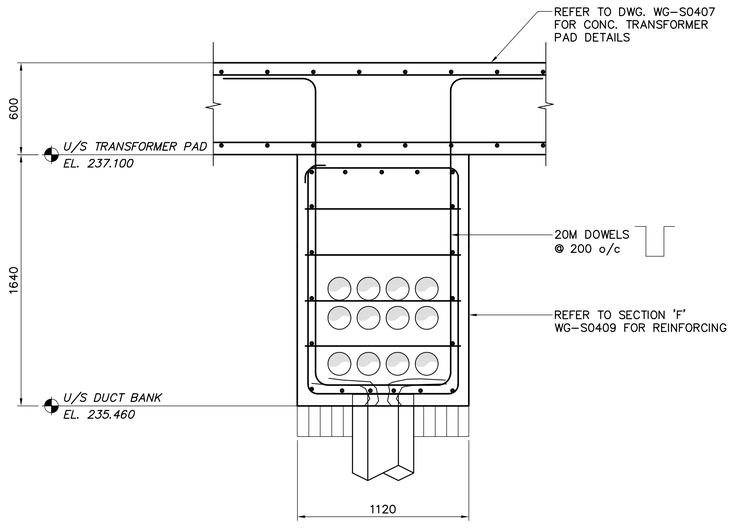

3 SECTION
– 1:20

APEGM
Certificate of Authorization
Earth Tech Canada Inc.
No. 730 Expiry: April 30, 2007

B.M.
ELEV.

NO.	REVISIONS	DATE	BY
01	498-2006 ADDENDUM 6	06/10/16	KK
00	ISSUED FOR TENDER	06/08/28	KK

CH2MHILL
Fredericksen Cooper ARCHITECTS
EarthTech A Tyco International Ltd. Company

DESIGNED BY	AP/GGP	CHECKED BY	GGP
DRAWN BY	KK	APPROVED BY	AHL
SCALE:	AS SHOWN	RELEASED FOR CONSTRUCTION BY:	R. SOROKOWSKI
DATE	2006/07/04	DATE	2006/08/30

ENGINEER'S SEAL
ORIGINAL SIGNED BY
A. POCHANART
2006/08/30

CONSULTANT DRAWING NO.
WG-S0452

Winnipeg
THE CITY OF WINNIPEG
WATER AND WASTE DEPARTMENT
ENGINEERING DIVISION

WATER TREATMENT PLANT
EMERGENCY POWER GENERATOR

CITY FILE NUMBER
SHEET OF

STRUCTURAL
DUCT BANK SECTIONS

CITY DRAWING NUMBER
1-0601G-A-S0452-001-01D

Last Save: 2006-10-17 10:13 AM

L:\WORK\79000\79538\02A-CAD\IND\CONTR\GENSET\DN_WG-S0452_ET.DWG