




1 EMERGENCY EGRESS HUT - N. ELEVATION (SOUTH MIRRORED)  
1:25

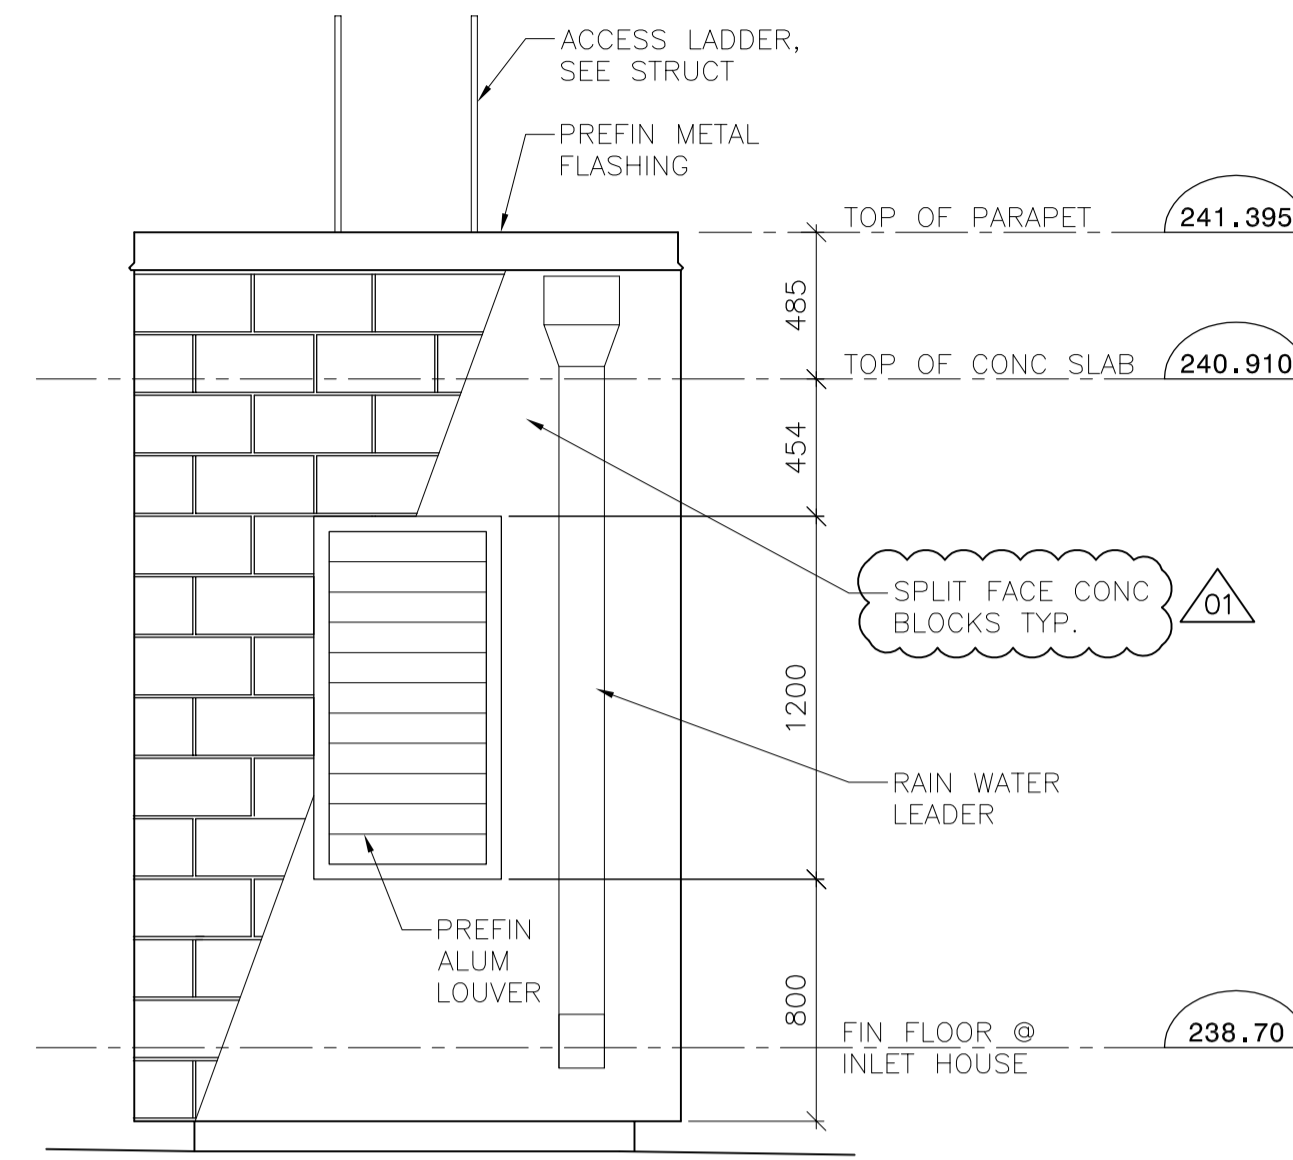

2 EMERGENCY EGRESS HUT - E. ELEVATION  
1:25

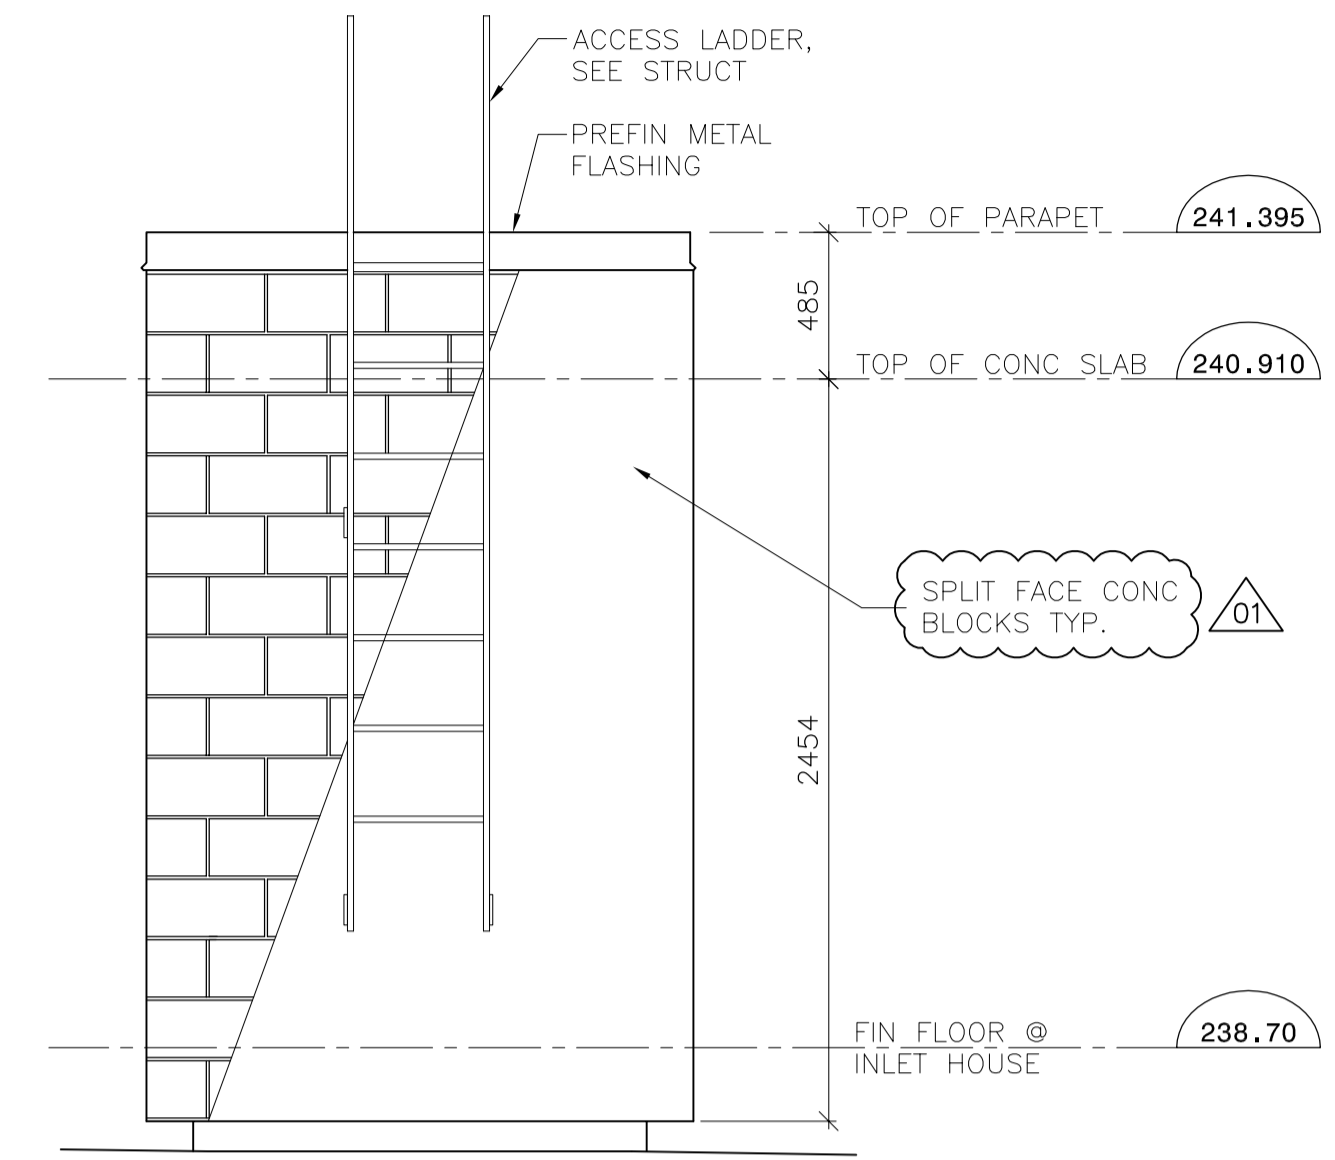

3 EMERGENCY EGRESS HUT - W. ELEVATION  
1:25

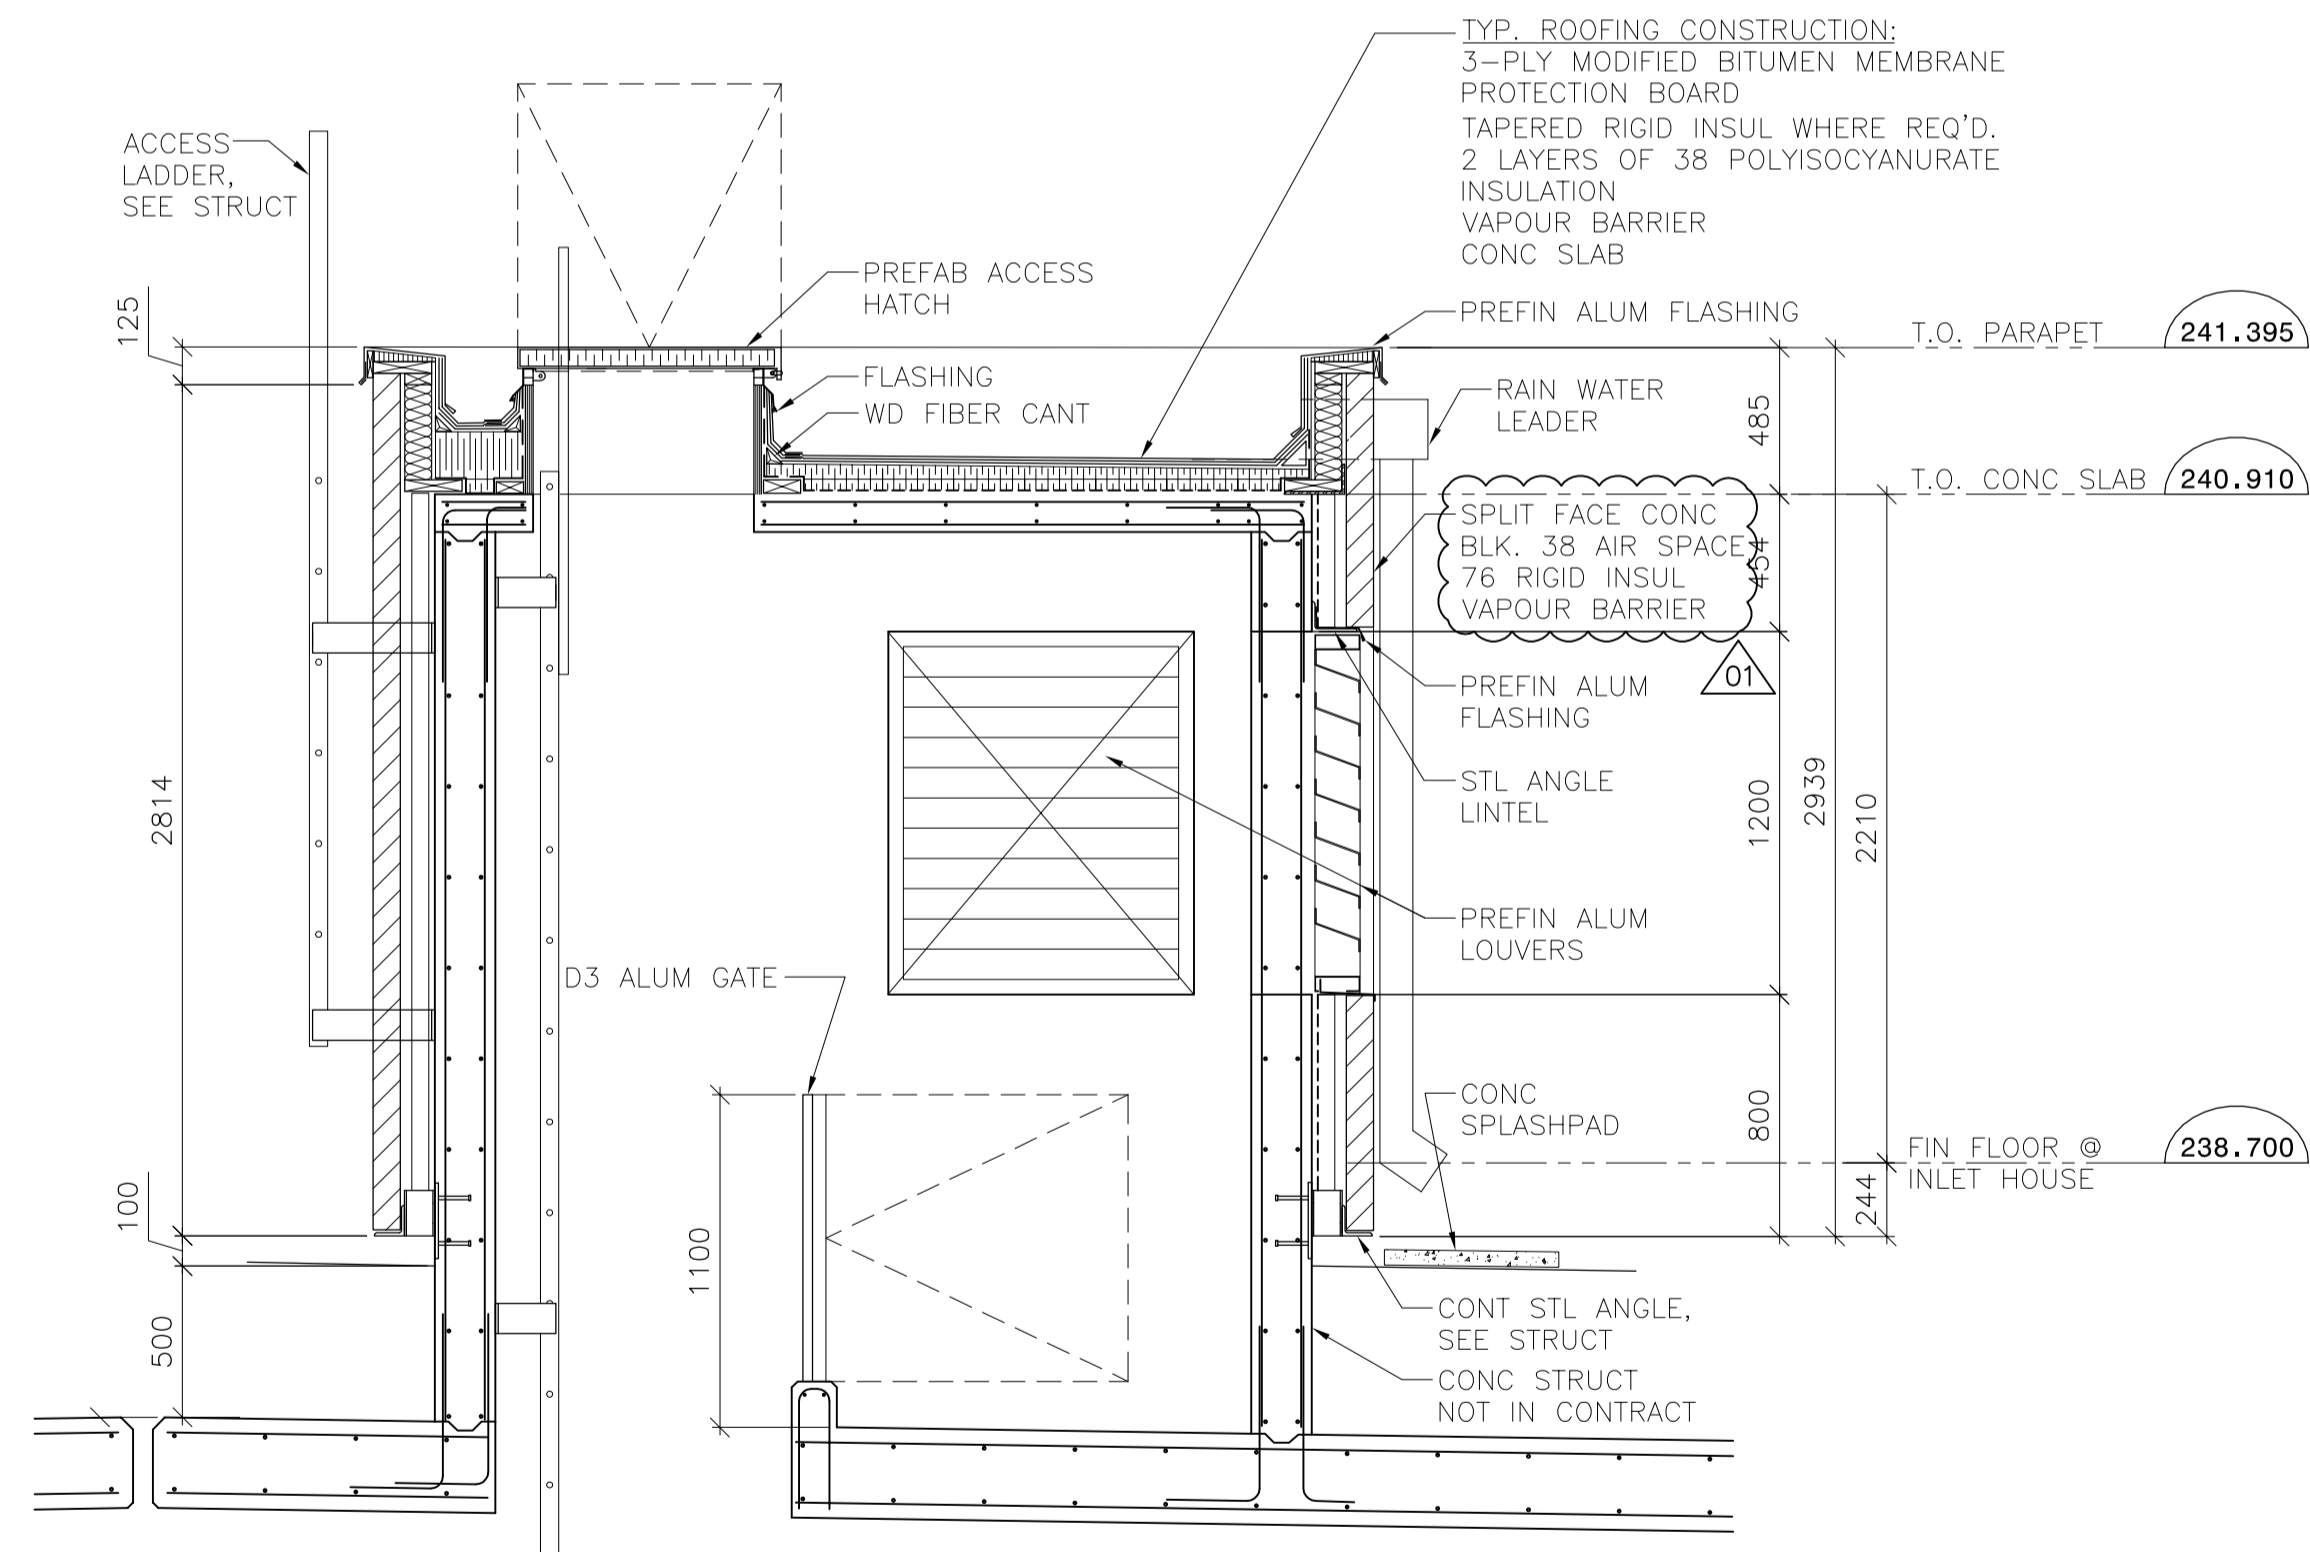

4 EMERGENCY EGRESS HUT - TYPICAL SECTION  
WT-B0002 1:25

NOTE:  
EMERGENCY EGRESS HUTS CONCRETE STRUCTURAL NOT IN THIS CONTRACT.

B.M. ELEV.		 		 <small>A Tyco International Ltd. Company</small>		ENGINEER'S SEAL		 <b>THE CITY OF WINNIPEG</b> WATER AND WASTE DEPARTMENT ENGINEERING DIVISION	
		DESIGNED BY	BS	CHECKED BY	MK	ORIGINAL SIGNED BY		CITY FILE NUMBER	
		DRAWN BY	GGP/WC	APPROVED BY	AHL	N. COOPER		SHEET OF	
		SCALE:	AS NOTED	RELEASED FOR CONSTRUCTION BY:		06/08/30		CITY DRAWING NUMBER	
01 498-2006 ADDENDUM 6 06/10/16 KK				R. SOROKOWSKI		CONSULTANT DRAWING NO.		1-06011-A-B0005-001-01D	
00 ISSUED FOR TENDER 06/08/28 WDB						WT-B0005			
NO. REVISIONS		DATE	05/04/04	DATE	06/08/30				