




A PLAN DETAIL
WG-S0451 20:1

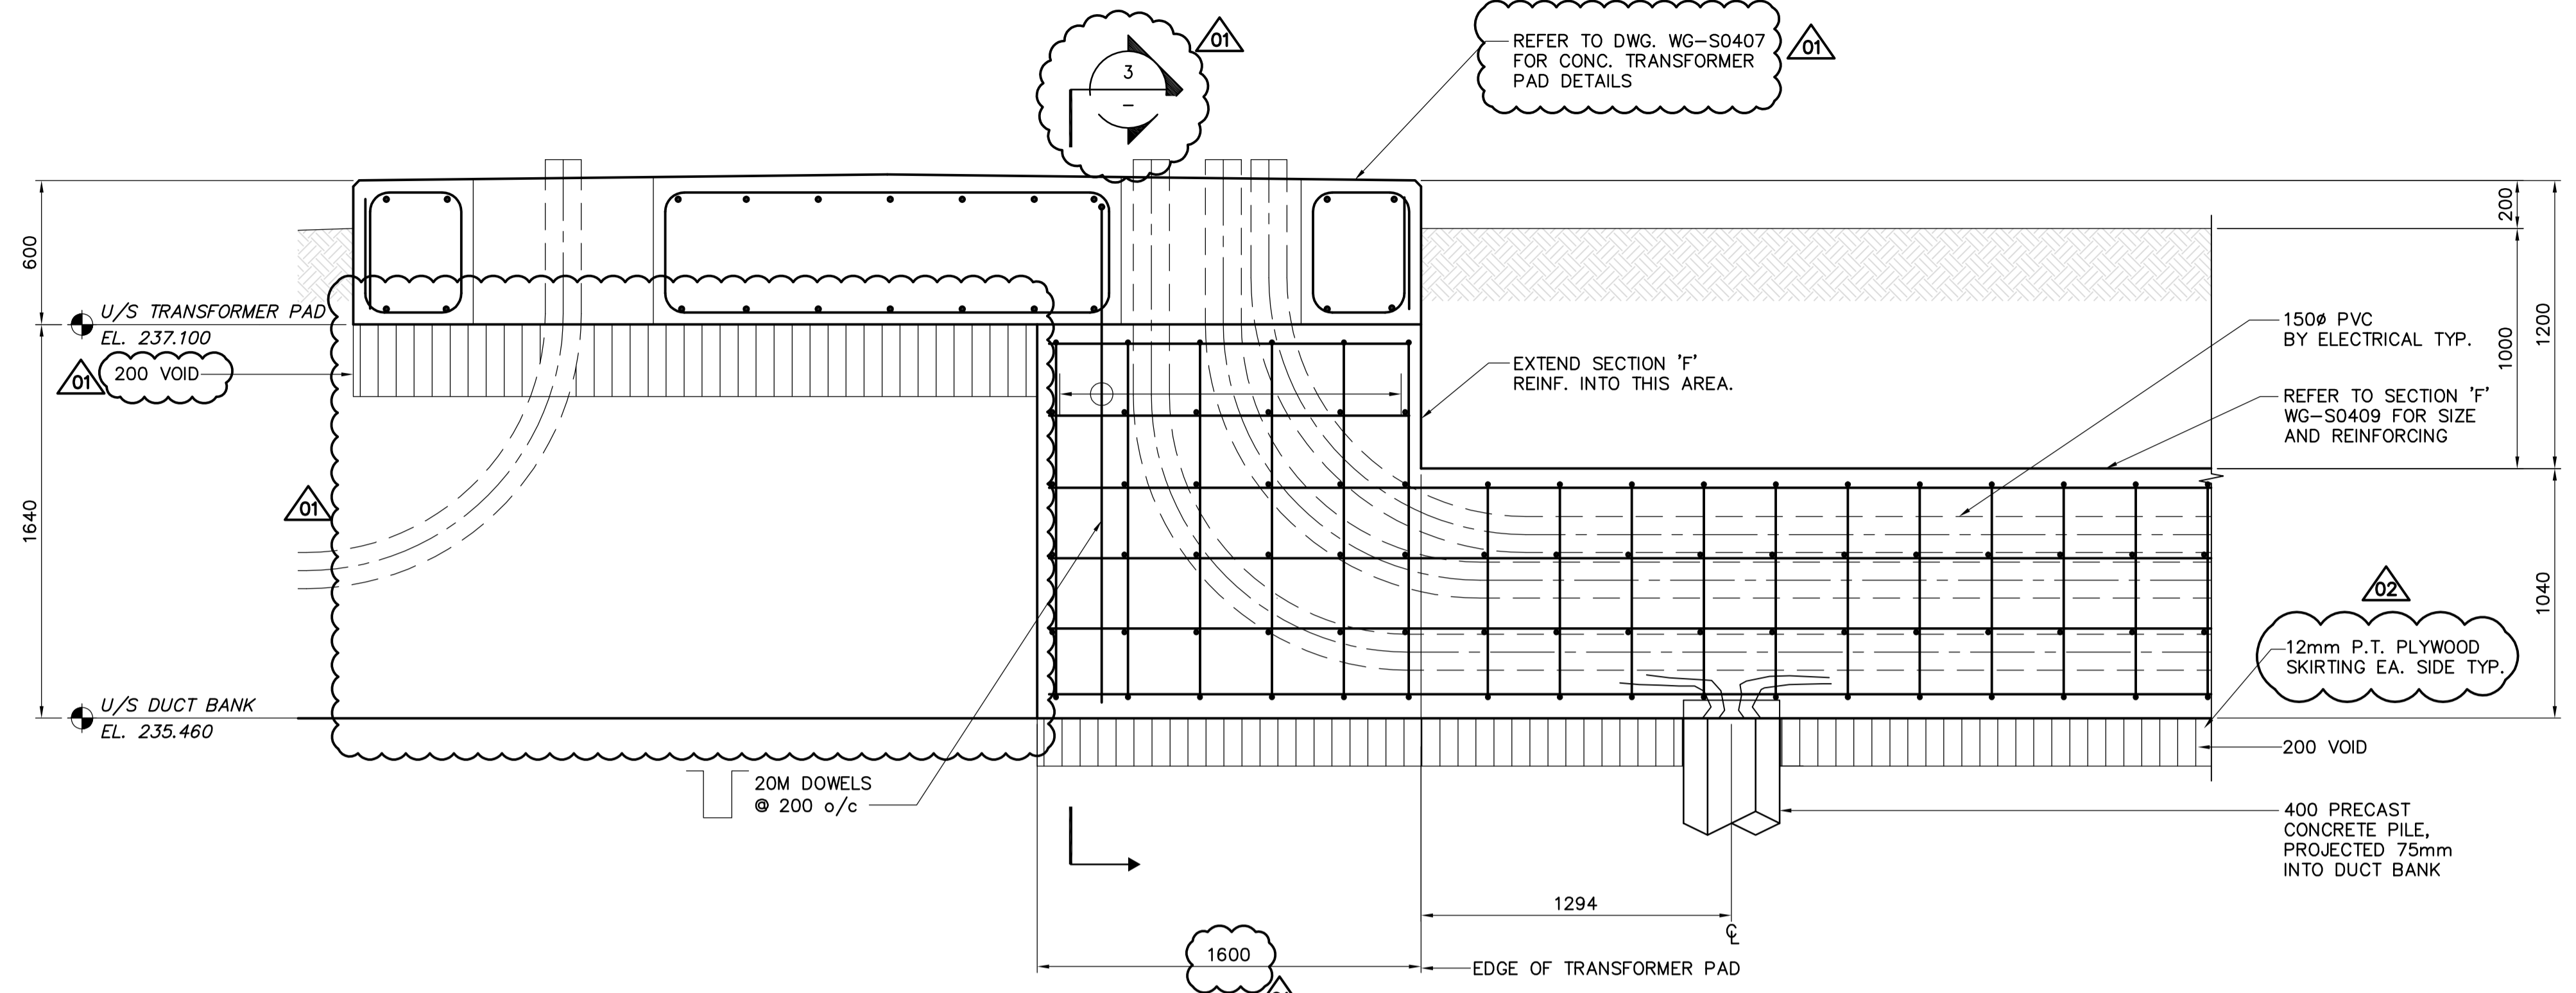


1 SECTION
WG-S0451 1:20

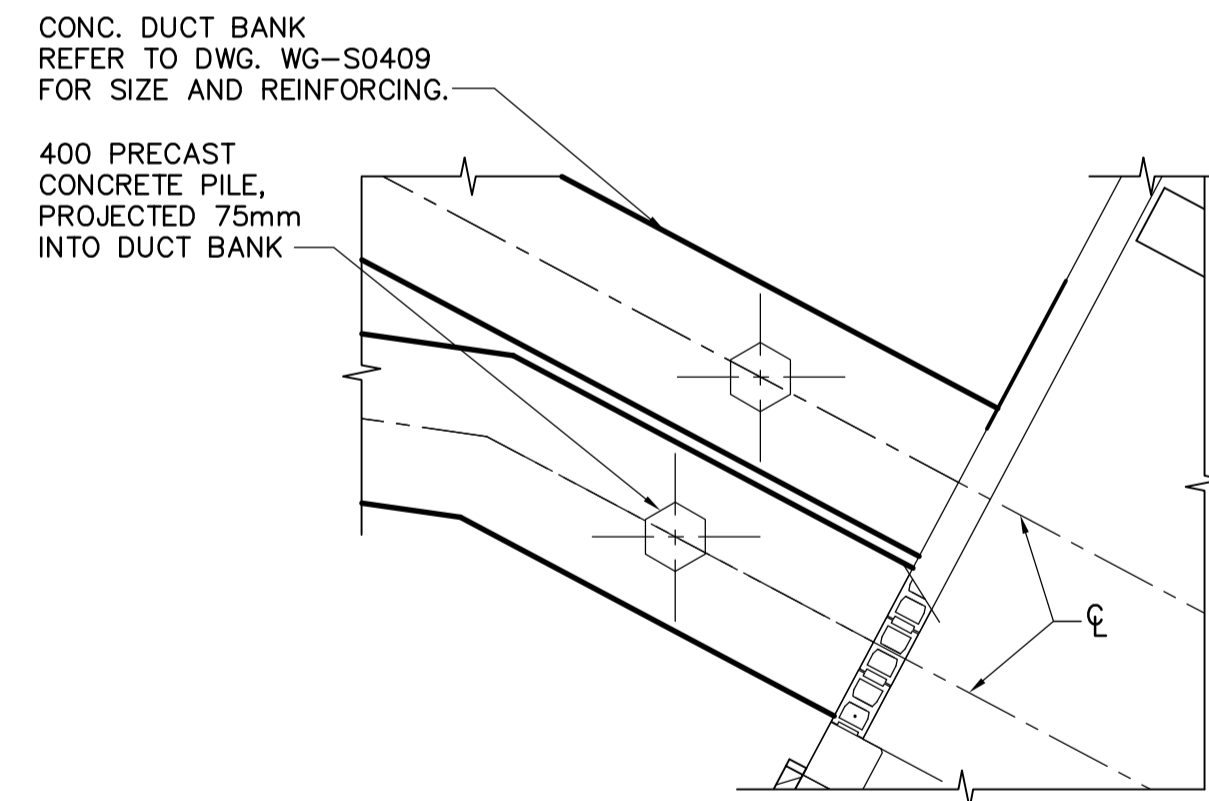

B PLAN DETAIL
WG-S0451 20:1

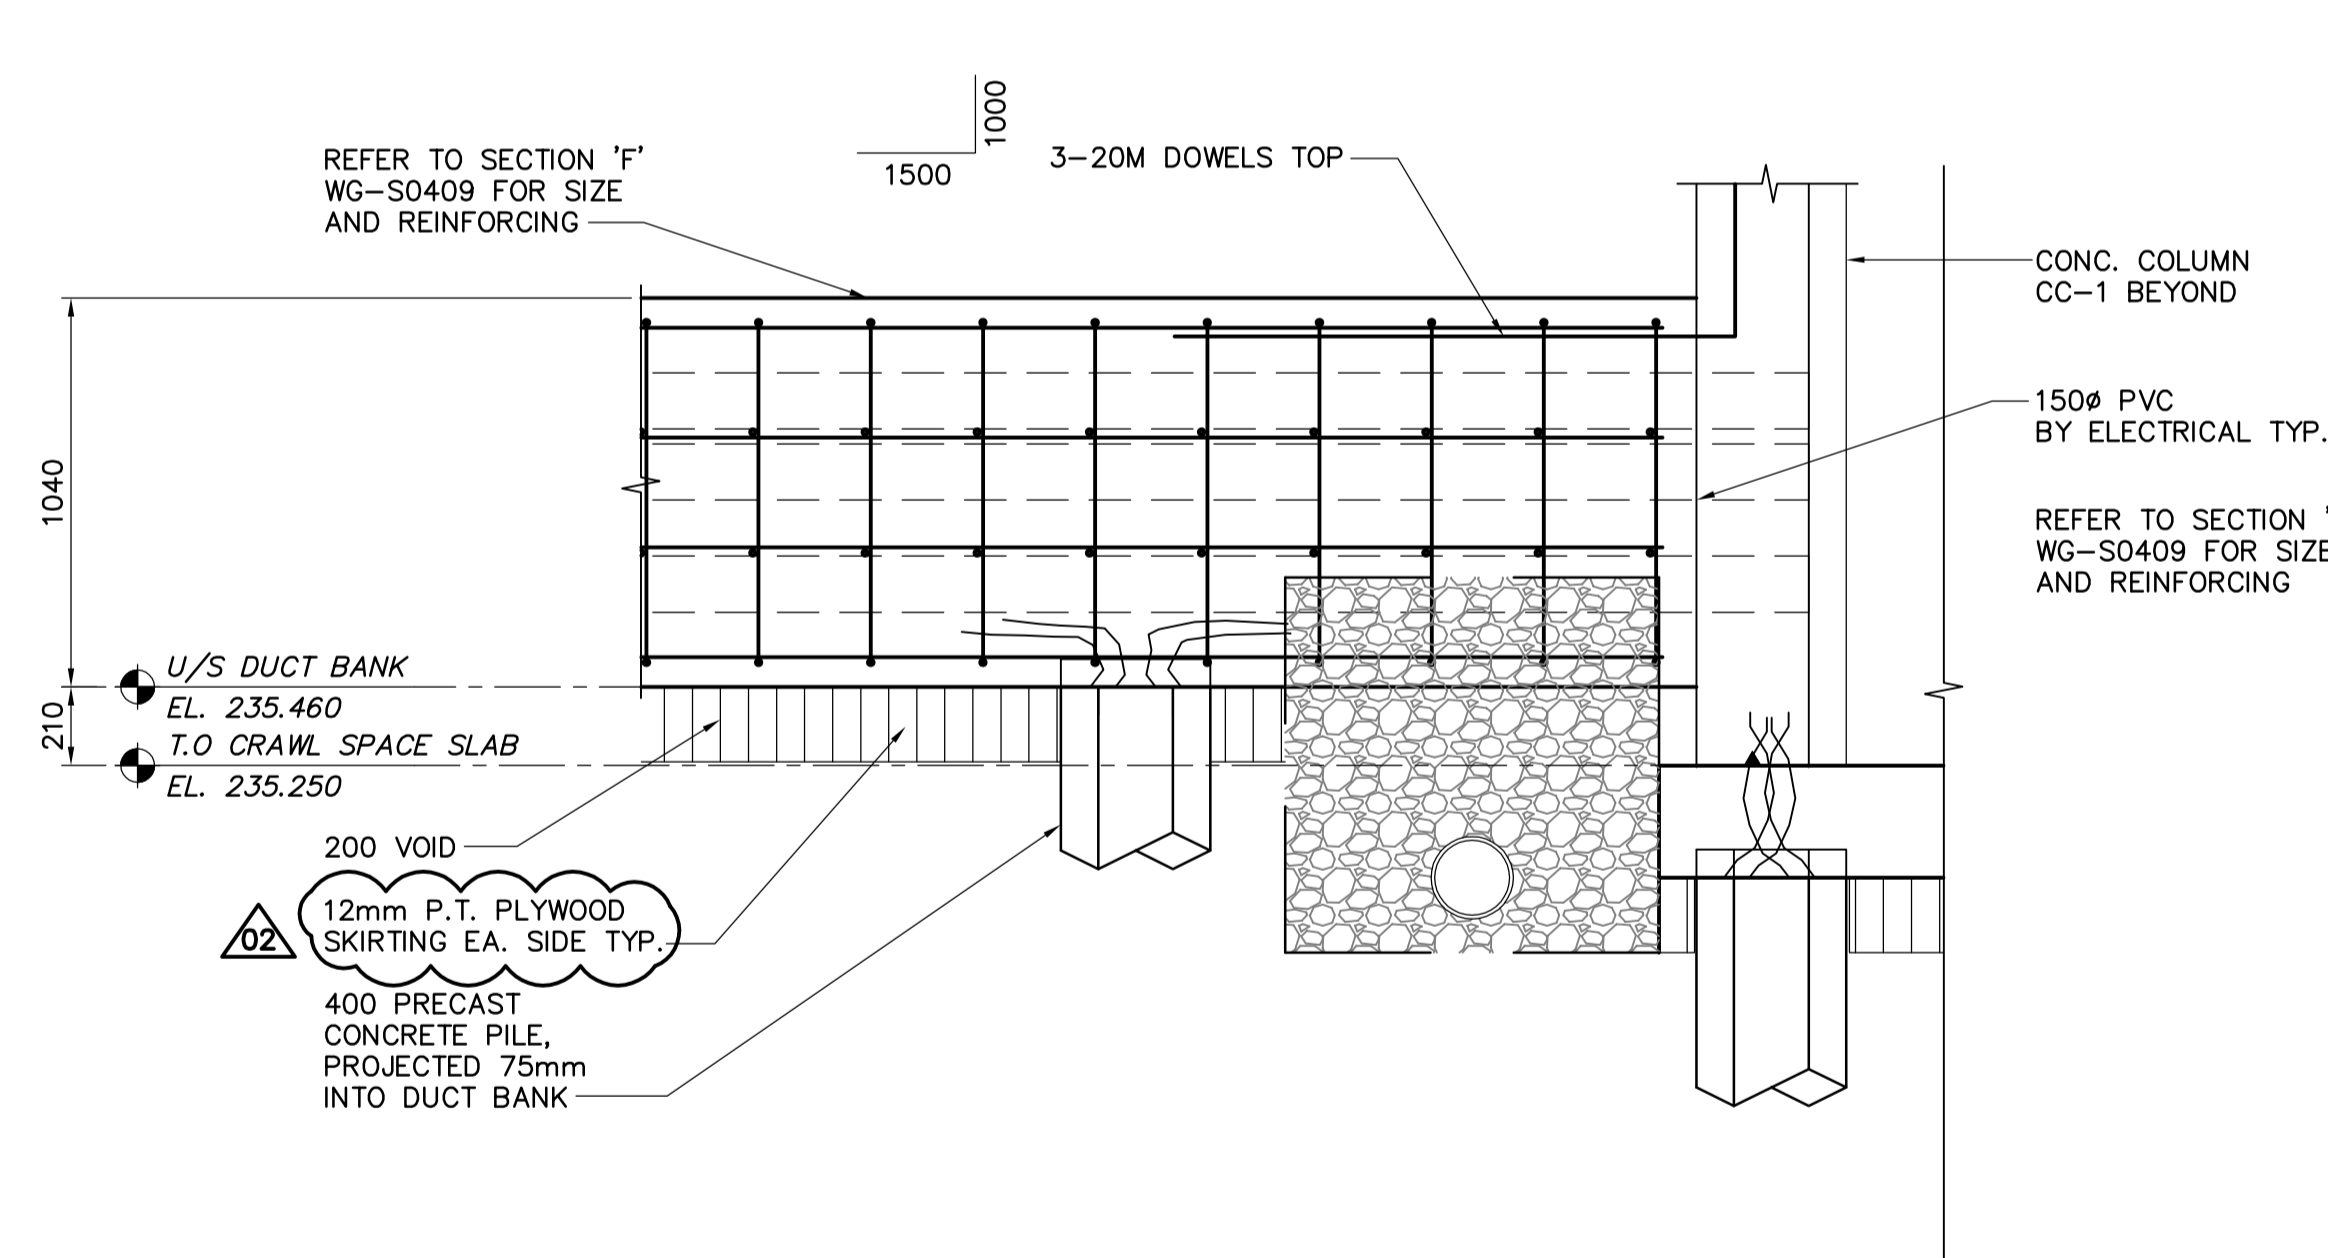

2 SECTION
WG-S0451 1:20

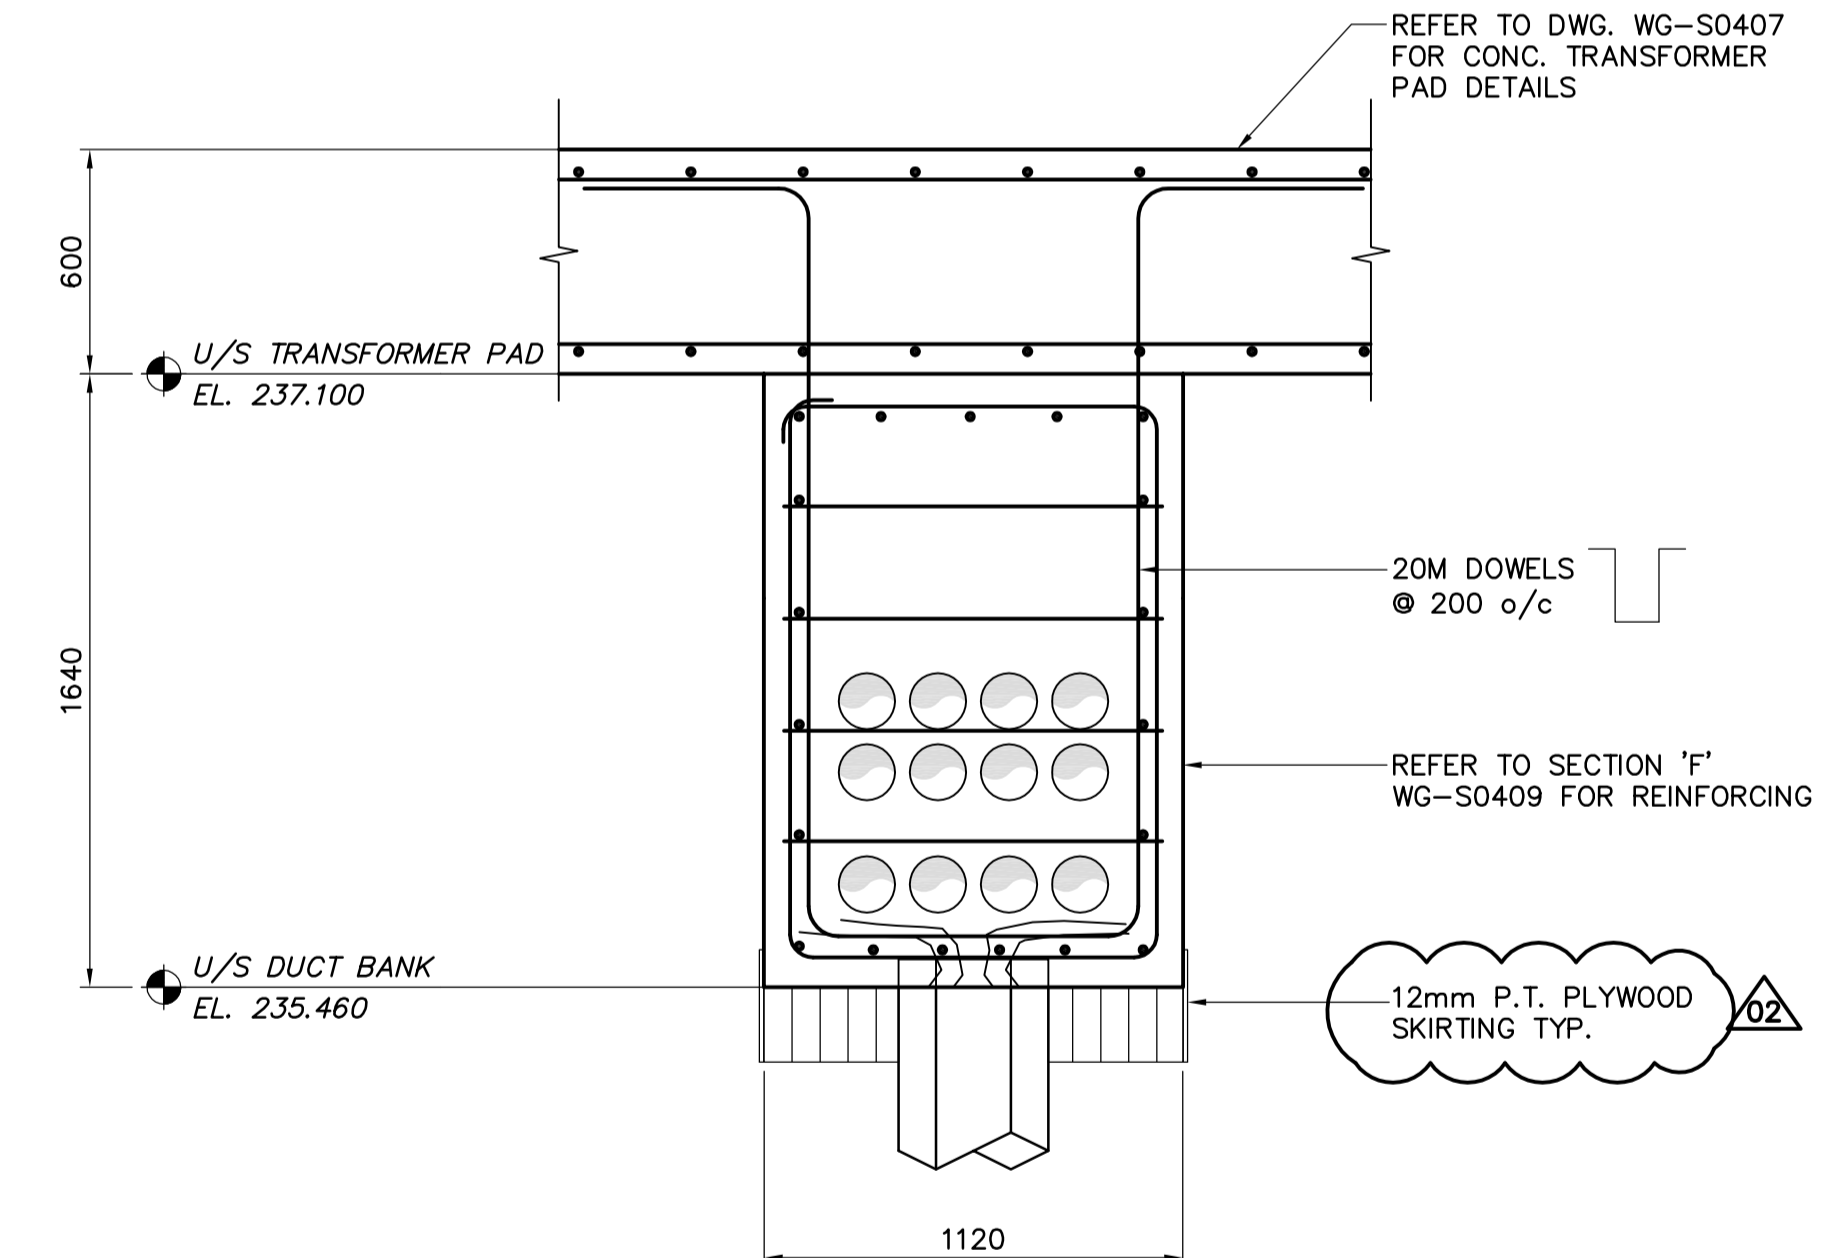

3 SECTION
1:20



B.M. ELEV.					
DESIGNED BY	AP/GGP	CHECKED BY	GGP	DATE	2006/07/04
DRAWN BY	KK	APPROVED BY	AHL	DATE	2006/08/30
SCALE:	AS SHOWN	RELEASED FOR CONSTRUCTION BY:	R. SOROKOWSKI	DATE	2006/08/30
NO. REVISIONS					
02	498-2006 ADDENDUM 8	06/10/23	KK		
01	498-2006 ADDENDUM 6	06/10/16	KK		
00	ISSUED FOR TENDER	06/08/28	KK		

ENGINEER'S SEAL
ORIGINAL SIGNED BY
A. POCHANART
2006/08/30
CONSULTANT DRAWING NO.
WG-S0452

THE CITY OF WINNIPEG
WATER AND WASTE DEPARTMENT
ENGINEERING DIVISION

WATER TREATMENT PLANT
EMERGENCY POWER GENERATOR

STRUCTURAL
DUCT BANK SECTIONS

CITY FILE NUMBER
SHEET OF
CITY DRAWING NUMBER
1-0601G-A-S0452-001-02D