


### KEY NOTES

- 4 NEW 3" FORCE MAIN FROM FROM 2,000 GAL. CONCRETE SEPTIC TANK (2 EA.). PU-1 & 2 LOCATED IN MECH ROOM. SEE DETAIL 2-M1.2.
- 8 INSTALL TANKS APPROX. 10' FROM EDGE OF BUILDING AT 7' BURIAL DEPTH, COMPLETE WITH CONCRETE ACCESS EXTENSION AND HEAVY DUTY STEEL LIDS AT GRADE LEVEL. LIDS TO HAVE HEAVY DUTY HASP SUITABLE FOR SECURING WITH PADLOCK.
- 9 REDUNDANT LINE TO PUMP-OUT TANK. CAP IN MECHANICAL ROOM ALLOWING SUFFICIENT PIPING FOR FUTURE CONNECTION TO THE PUMPS.

**1**  
RDM1 SITE CONNECTIONS PART PLAN  
SCALE: 1/32"=1'-0"

### KEY NOTES

- 2 SELF-PRIMING END-SUCTION PUMPS ON CONCRETE PUMP PADS C/W STRAINER, UNION CONNECTIONS, SHUT-OFF VALVES.
- 12 TO SEPTIC TANK. SEE DETAIL 2-M1.2.
- 13 REDUNDANT LINE TO PUMP-OUT TANK. CAP IN MECHANICAL ROOM ALLOWING SUFFICIENT PIPING FOR FUTURE CONNECTION TO THE PUMPS.

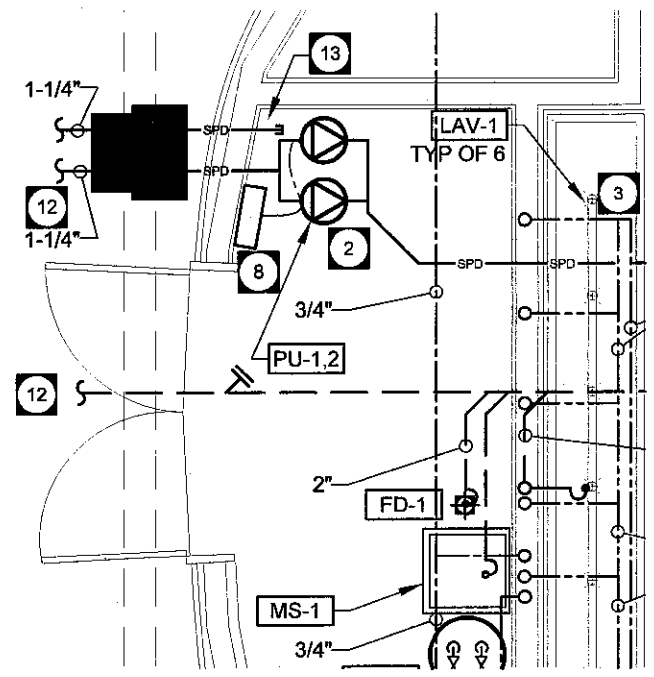


**2**  
RDM1 PLUMBING PART PLAN  
SCALE: 1/4"=1'-0"

**epp siepman engineering inc.**  
mechanical engineers  
303-100 Osborne St. South  
Winnipeg, MB  
R3L 1Y5

p 204.453.1060  
f 204.453.1335  
ese@eppsiepman.com

Assiniboine Park  
Duckpond Shelter Renovation  
Plumbing Part Plans  
Septic Tank Revisions

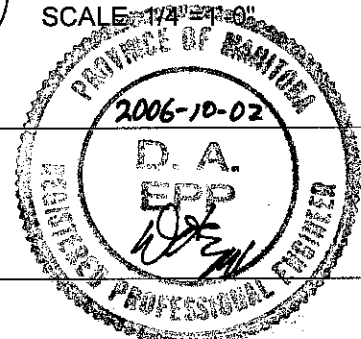

DATE: 06.09.29  
SCALE: AS NOTED

0631 **ese** RDM-1