SHEET: COW-A1 (05/2005)

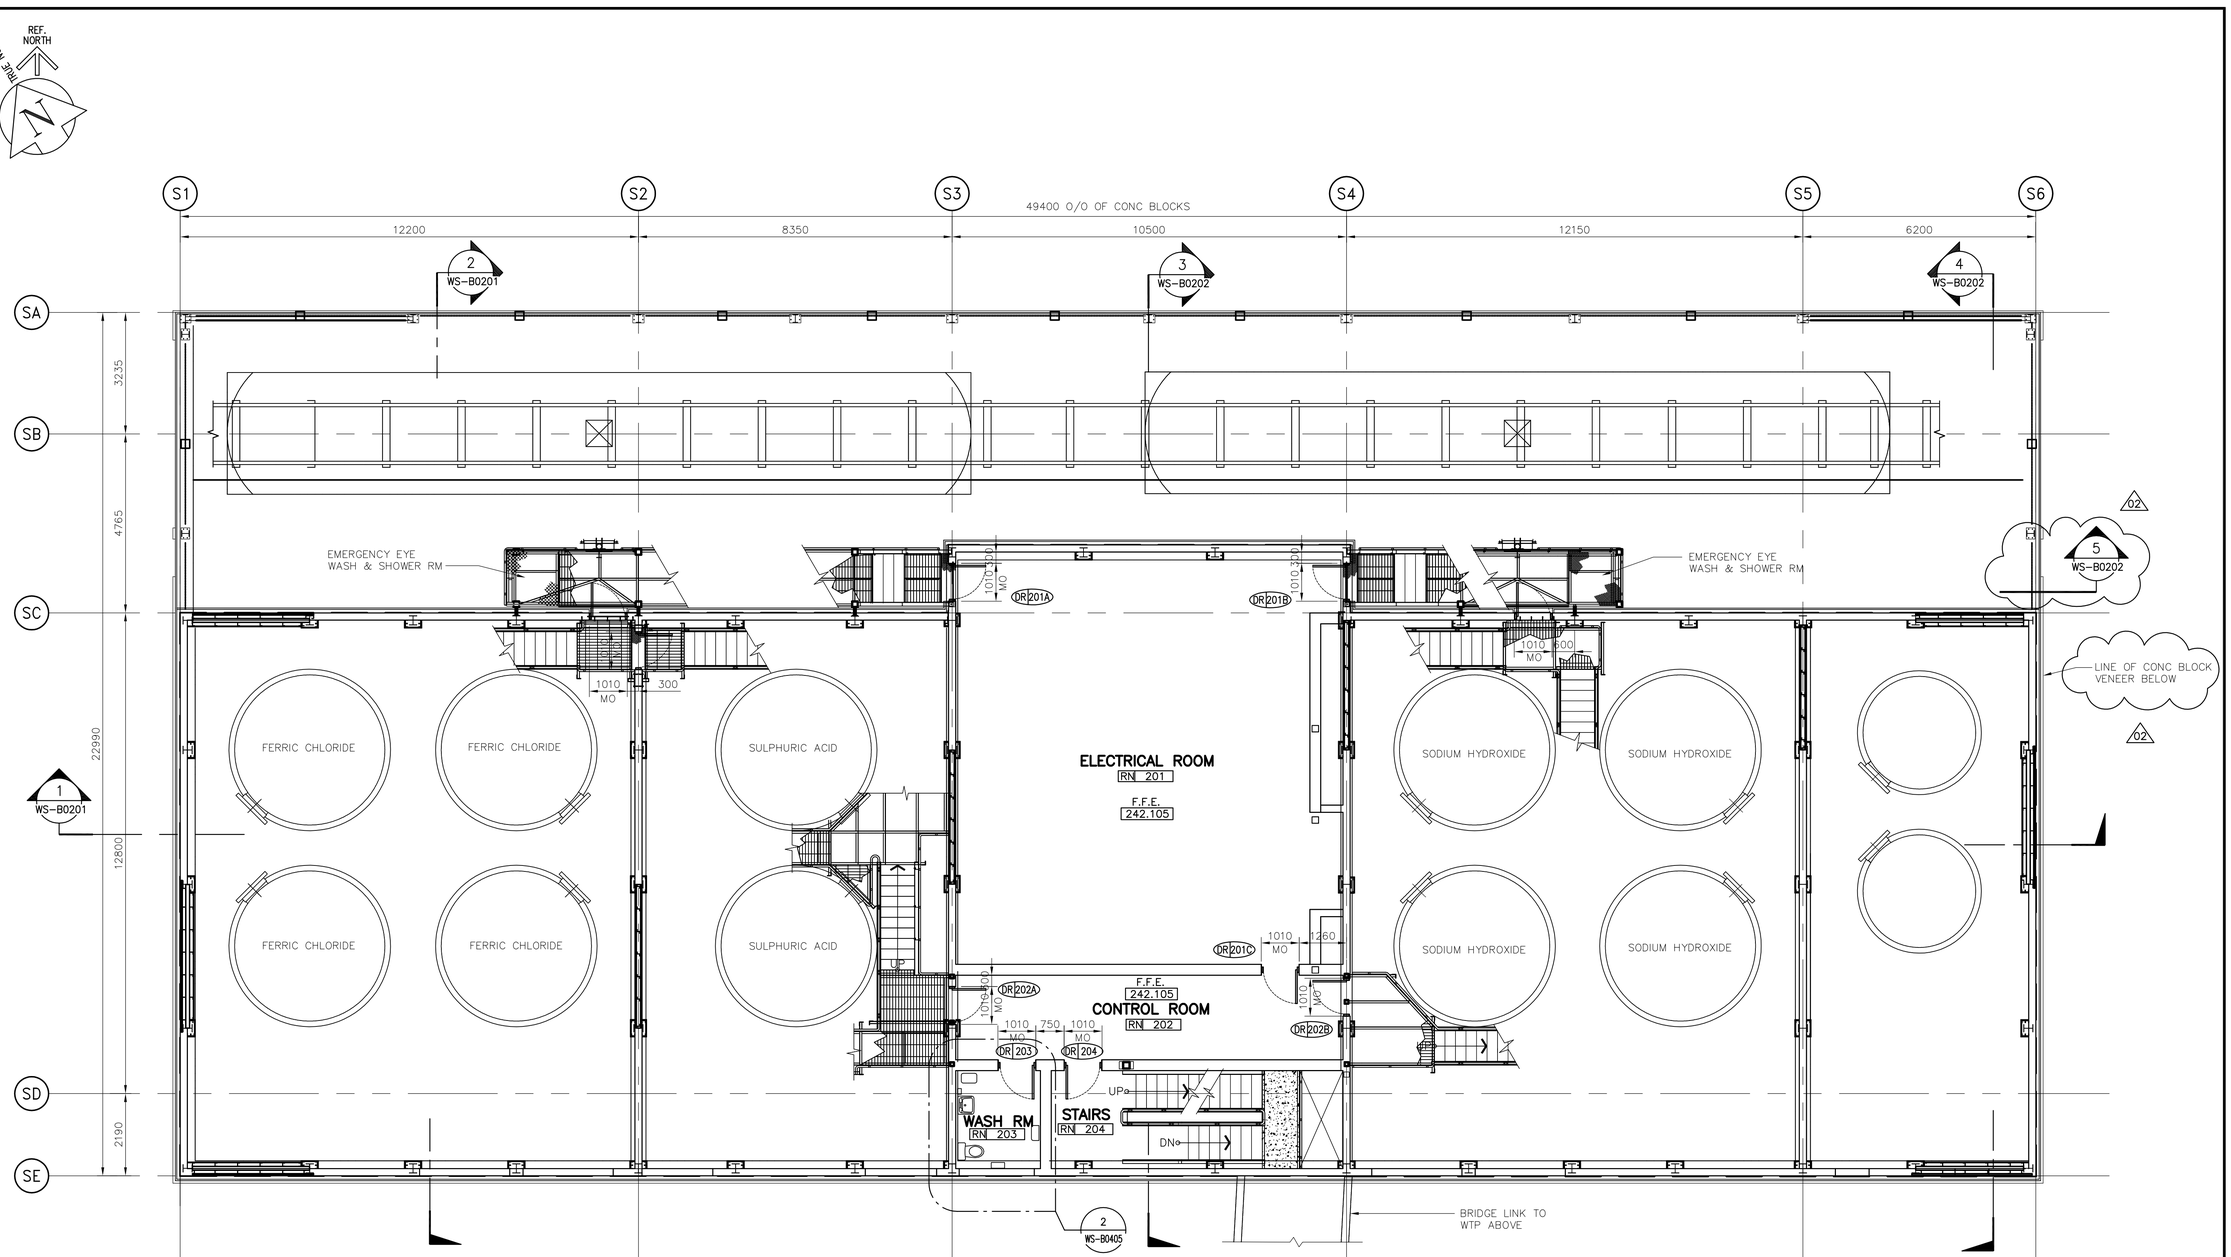

1 WS-B0115 SECOND FLOOR PLAN
1:75

PROVINCE OF MANITOBA
NEIL COOPER ARCHITECT INC.
No.090
APPROVED ARCHITECTURAL CORPORATION

B.M.
ELEV.

NO.	REVISIONS	DATE	BY
02	792-2006 ADDENDUM 5	07/04/11	AL
01	792-2006 ADDENDUM 3	07/03/30	AL
00	ISSUED FOR TENDER	07/01/31	AL

CH2MHILL
Fredericksen Cooper ARCHITECTS
EarthTech A Tyco International Ltd. Company

DESIGNED BY	NC	CHECKED BY	LK
DRAWN BY	AL	APPROVED BY	AHL
SCALE:	AS SHOWN	RELEASED FOR CONSTRUCTION BY:	R. SOROKOWSKI
DATE	2006/09/01	DATE	2007/01/31

ENGINEER'S SEAL
ORIGINAL SIGNED BY
NEIL COOPER
2007/01/31

CONSULTANT DRAWING NO.
WS-B0115

Winnipeg
THE CITY OF WINNIPEG
WATER AND WASTE DEPARTMENT
ENGINEERING DIVISION

WATER TREATMENT PLANT
BULK CHEMICAL BUILDING
SODIUM HYPOCHLORITE AND CHEMICAL STORAGE BUILDING
ARCHITECTURAL
SECOND FLOOR PLAN

CITY FILE NUMBER
SHEET OF
CITY DRAWING NUMBER
1-0601S-A-B0115-001-02D

Last Save: 2007-04-11 3:22 PM

E:\NC\JOBDATA\2004\04018 WINNIPEG WATER TREATMENT\02A-CAD\BULK CHEMICAL BUILDING\CONT DWGS\ARCH DWGS\792-2006 ADDENDUM 5\DN_WS-B0115_FC.DWG