SHEET: COW-A1 (05/2005)

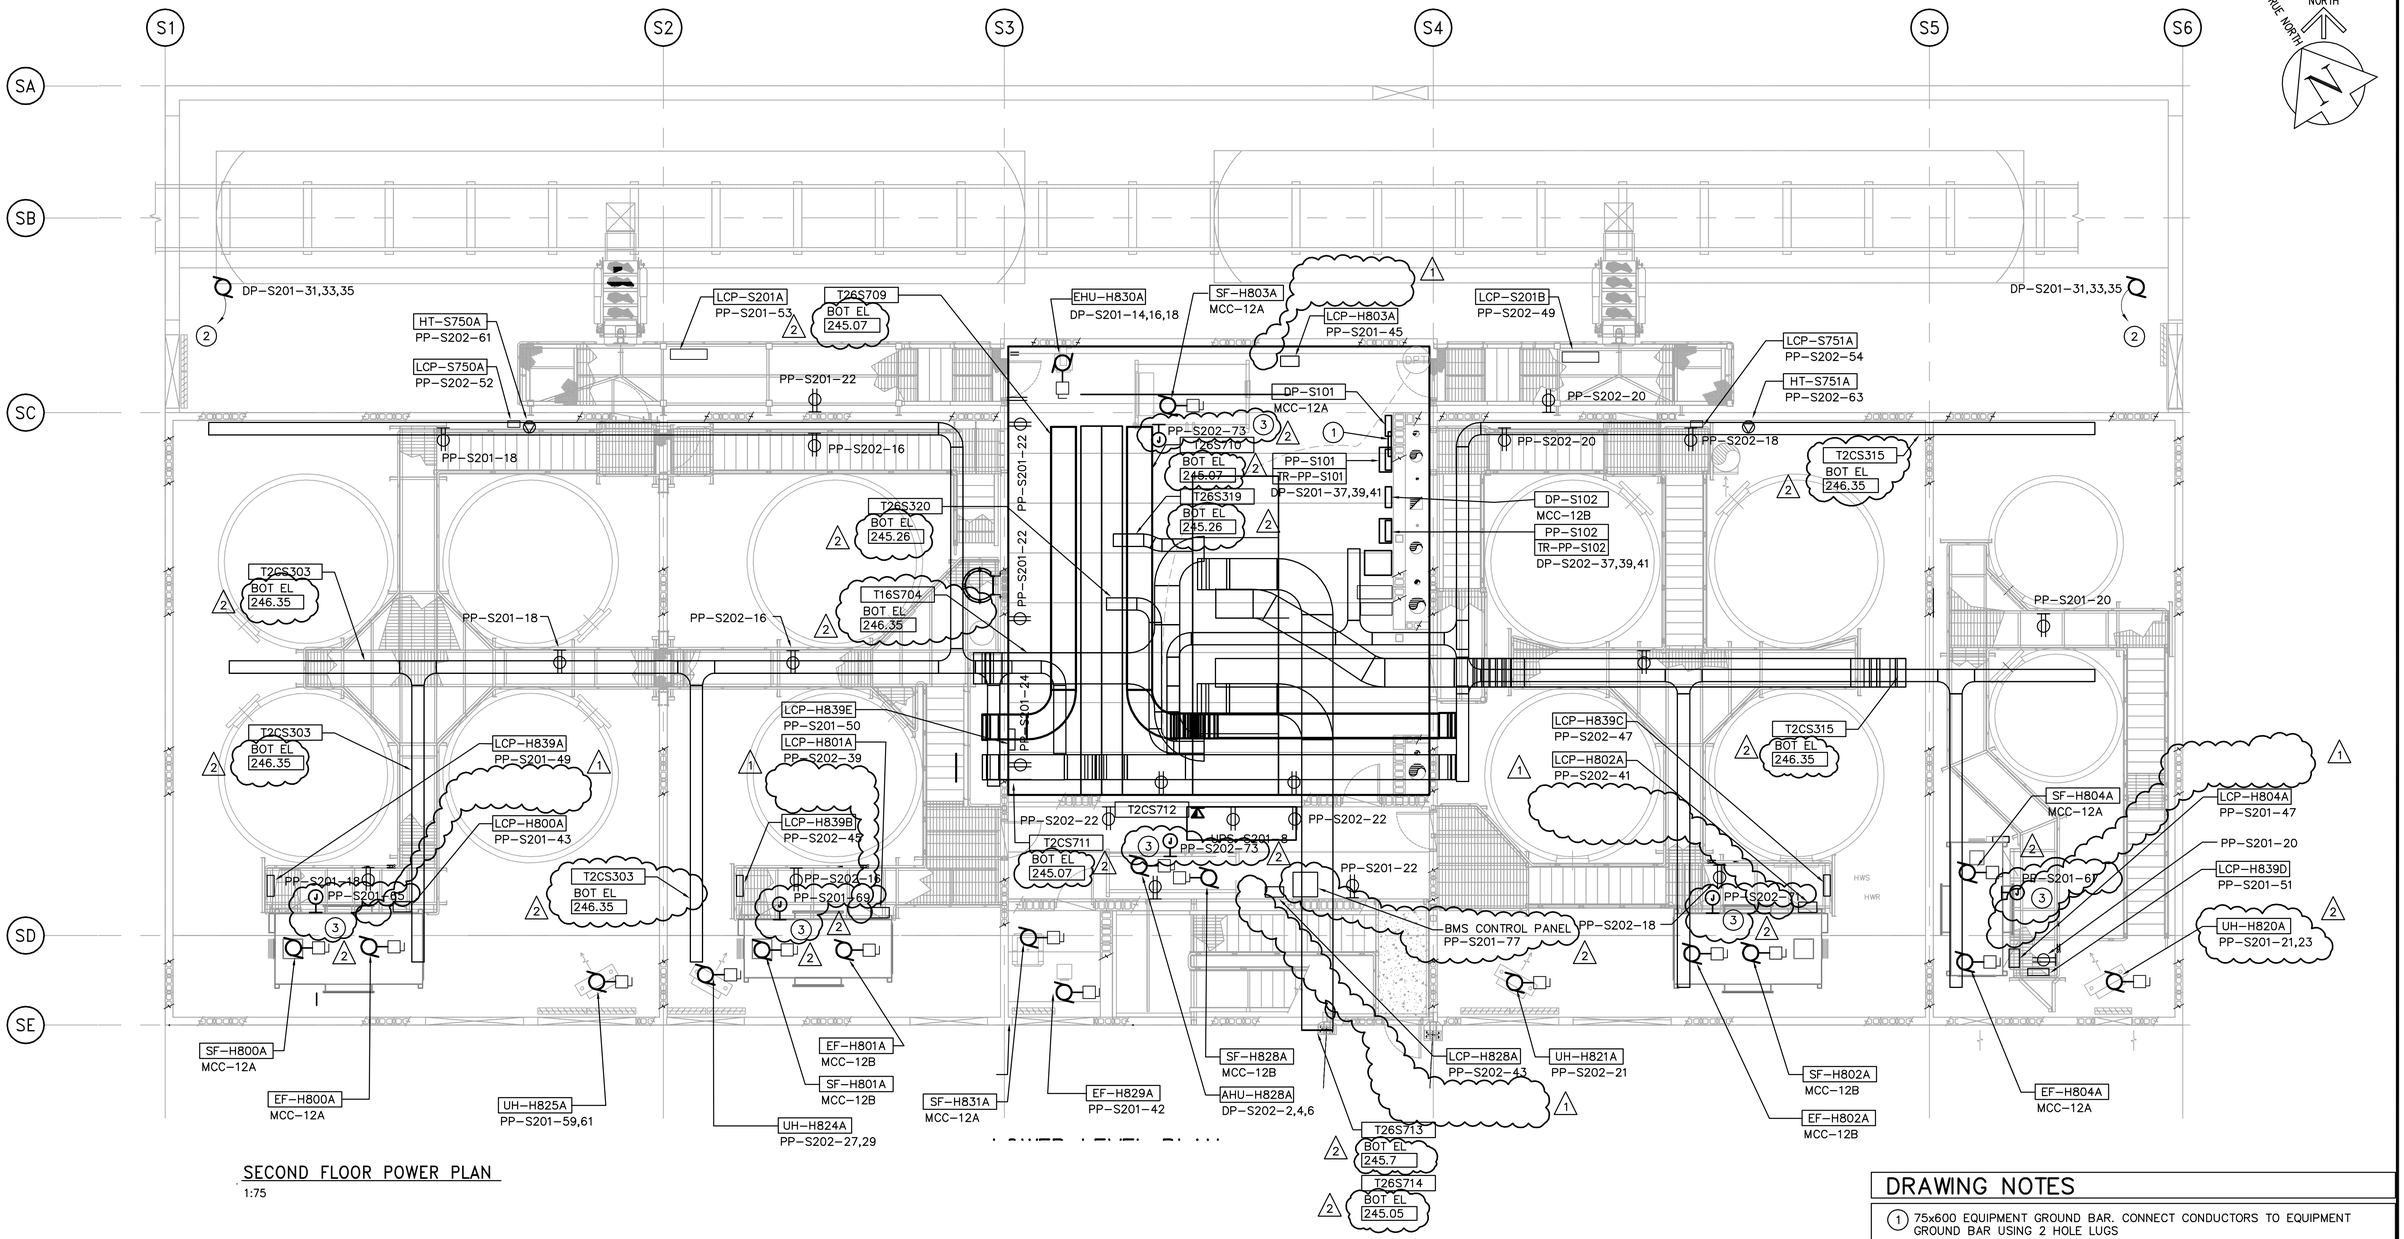

SECOND FLOOR POWER PLAN

1:75

DRAWING NOTES

1. 75x600 EQUIPMENT GROUND BAR. CONNECT CONDUCTORS TO EQUIPMENT GROUND BAR USING 2 HOLE LUGS
2. CONTROL WIRING FROM OVERHEAD DOOR OPENER TO MOTOR
3. SUPPLY AND INSTALL ONE 15A-1P CIRCUIT FOR LIGHTING AS SHOWN ON DRAWING FOR EACH AIR HANDLING UNIT AND MAKEUP AIR UNIT. FINAL CONNECTION TO BE MADE AT JUNCTION BOX PROVIDED ON UNIT.

GENERAL NOTES

1. COORDINATE WITH OTHER TRADES SO AS TO PREVENT CONFLICTS.
2. ALL DUCTWORK SHALL BE SUPPORTED AND SUSPENDED AS PER SPECIFICATIONS AND LOCAL CODES (SEE DETAILS).

SCALE 1:75 METRES 0 1.5 3.0 4.5 6.0 7.5

SCALE 1:1 MILLIMETRES 0 20 40 60 80 100

APEGM
Certificate of Authorization
Earth Tech Canada Inc.
No. 730 Expiry: April 30, 2007

B.M. ELEV.

NO.	REVISIONS	DATE	BY
02	792-2006 ADDENDUM 5	07/04/11	ERC
01	792-2006 ADDENDUM 4	07/04/10	ERC
00	ISSUED FOR TENDER	07/01/31	ERC

CH2MHILL
Frederickson Cooper ARCHITECTS
EarthTech A Tyco International Ltd. Company

DESIGNED BY	BLM	CHECKED BY	PS
DRAWN BY	ERC	APPROVED BY	AHL
SCALE:	1:75	RELEASED FOR CONSTRUCTION BY:	R. SOROKOWSKI
DATE	2007/01/30	DATE	2007/01/31

ENGINEER'S SEAL
ORIGINAL SIGNED BY
P. STRYK
2007/01/31

CONSULTANT DRAWING NO.
WS-E0122

Winnipeg
THE CITY OF WINNIPEG
WATER AND WASTE DEPARTMENT
ENGINEERING DIVISION

WATER TREATMENT PLANT
BULK CHEMICAL STORAGE
SODIUM HYPOCHLORITE AND CHEMICAL STORAGE BUILDING

ELECTRICAL
SECOND FLOOR POWER PLAN

CITY FILE NUMBER
SHEET OF
CITY DRAWING NUMBER
1-0601S-A-E0122-001-02D

Last Save: 2007-04-11 3:38 PM

L:\WORK\79000\79538\02A-CAD\ELE\CONTR\BULK CHEMICAL BUILDING\DN_WS-E0122_ET.DWG