

S1 S2 S3 S4 S5 S6


SA

SB

SC

SD

SE

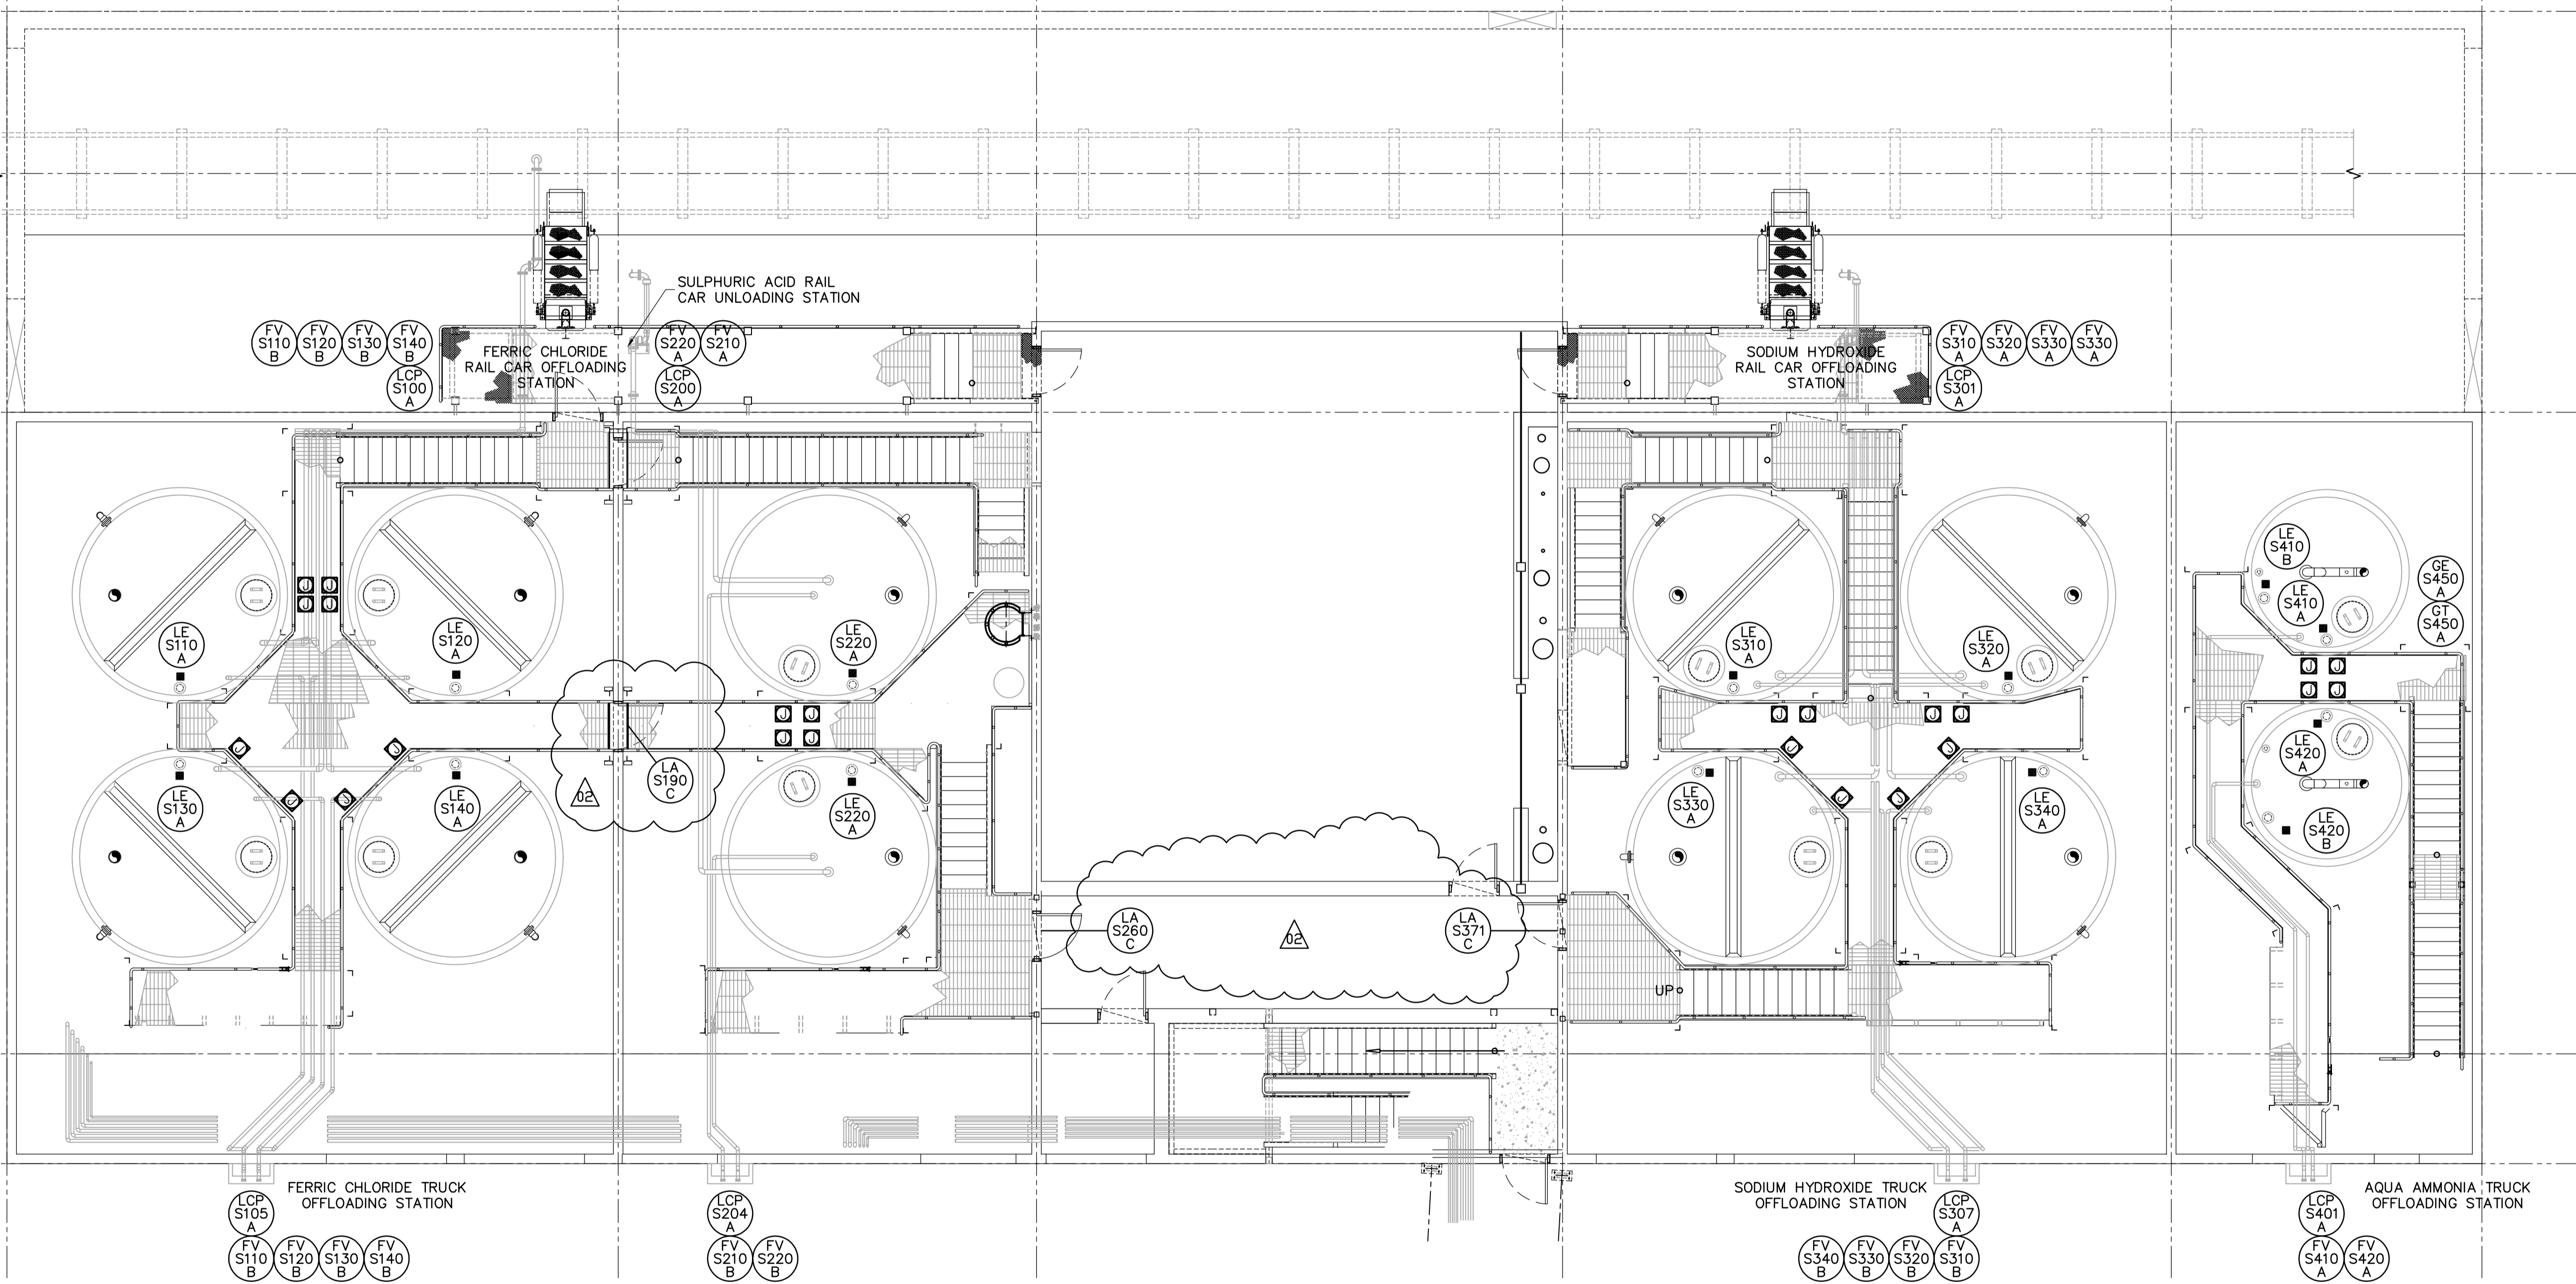

CATWALK PLAN

**LEGEND**  
 JUNCTION BOX

**APEGM**  
 Certificate of Authorization  
 Earth Tech Canada Inc.  
 No. 730 Expiry: April 30, 2007

B.M. ELEV.	<b>CH2MHILL</b> Frederickson Cooper ARCHITECTS		<b>EarthTech</b> A Tyco International Ltd. Company	
	DESIGNED BY: NT/BT	CHECKED BY: SWT	ENGINEER'S SEAL ORIGINAL SIGNED BY: S.W. TORMEY 2007/01/31	
	DRAWN BY: LAE	APPROVED BY: AHL	CONSULTANT DRAWING NO. WS-A0125	
	SCALE: 1:75	RELEASED FOR CONSTRUCTION BY: R. SOROKOWSKI		
02 792-2006 ADDENDUM 9 07/04/23 LAE	DATE	DATE	2006/09/26	DATE 2007/01/31
01 792-2006 ADDENDUM 5 07/04/11 LAE				
00 ISSUED FOR TENDER 07/01/31 LAE				
NO. REVISIONS	DATE	BY	DATE	DATE

**THE CITY OF WINNIPEG**  
 WATER AND WASTE DEPARTMENT  
 ENGINEERING DIVISION

**WATER TREATMENT PLANT**  
**BULK CHEMICAL BUILDING**  
**SODIUM HYPOCHLORITE AND CHEMICAL STORAGE BUILDING**

AUTOMATION / I&C  
 INSTRUMENT LOCATION PLAN  
 UPPER LEVEL

CITY FILE NUMBER  
 SHEET OF  
 CITY DRAWING NUMBER  
 1-0601S-A-A0125-001-02D