



15 SECTION DETAIL @ DAF GALLERY
WB-B0202 1:10

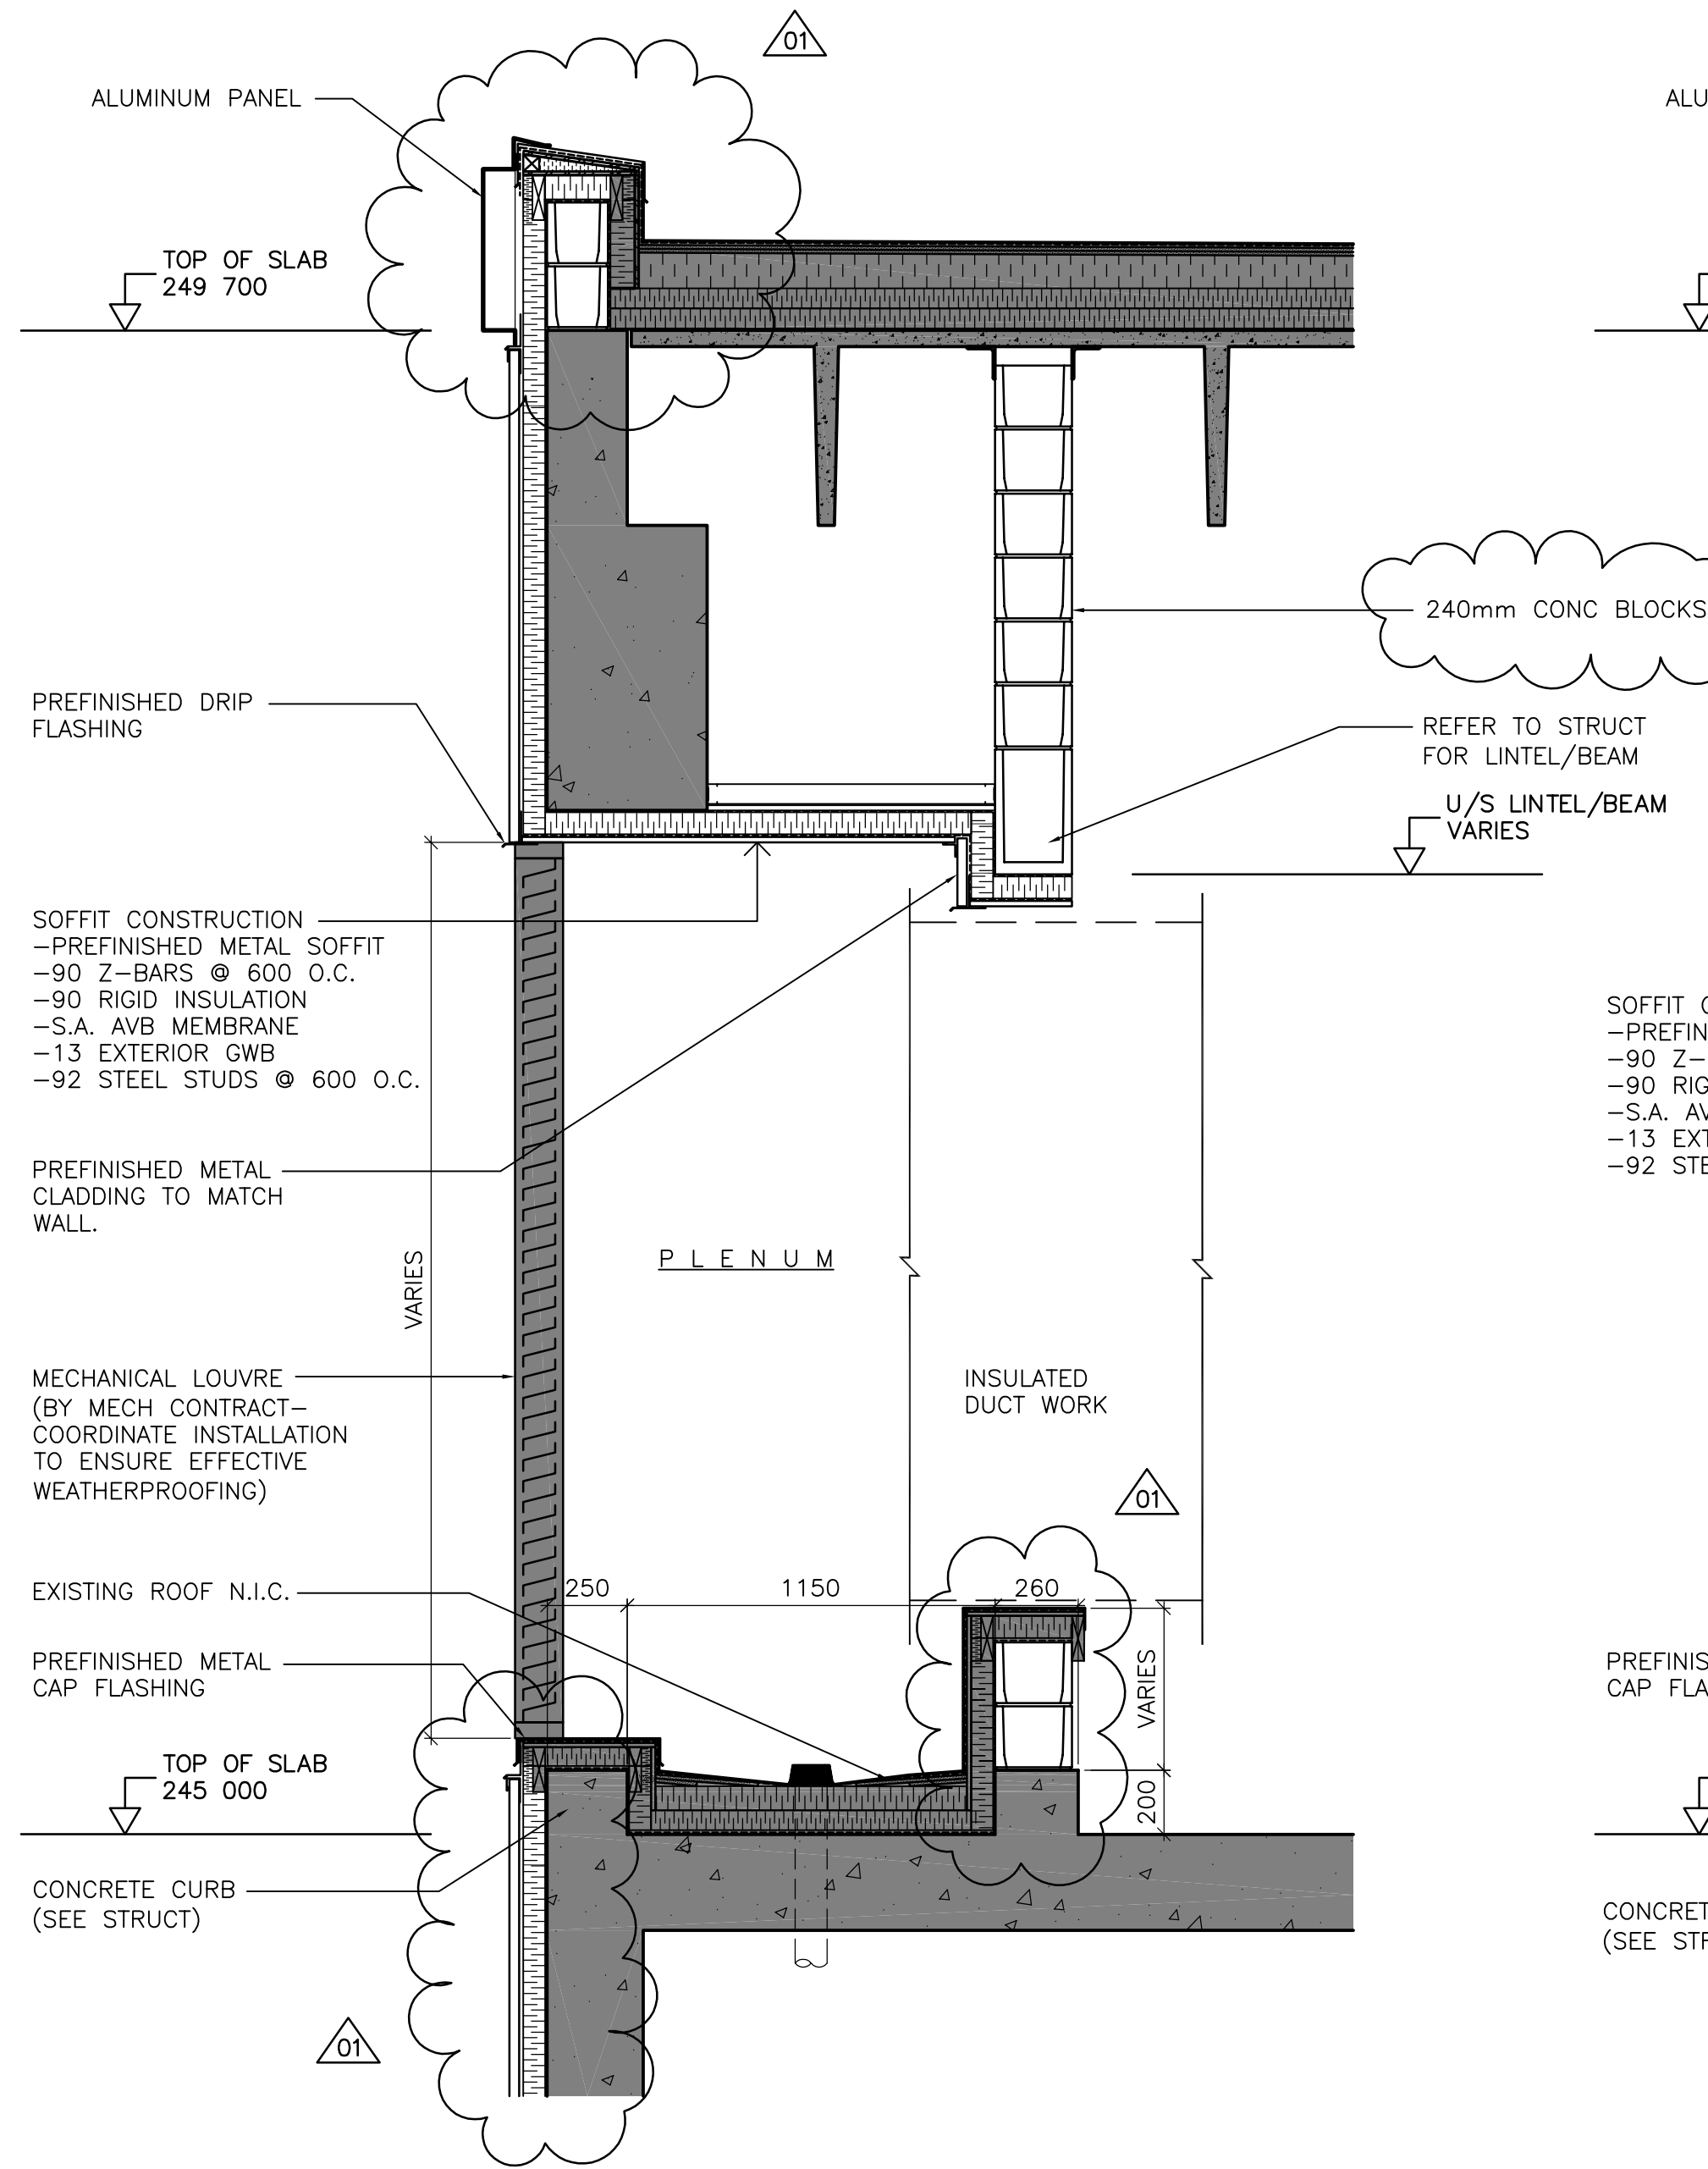

16 SECTION DETAIL @ MECHANICAL PLENUM (TYP)
WB-B0110 1:20

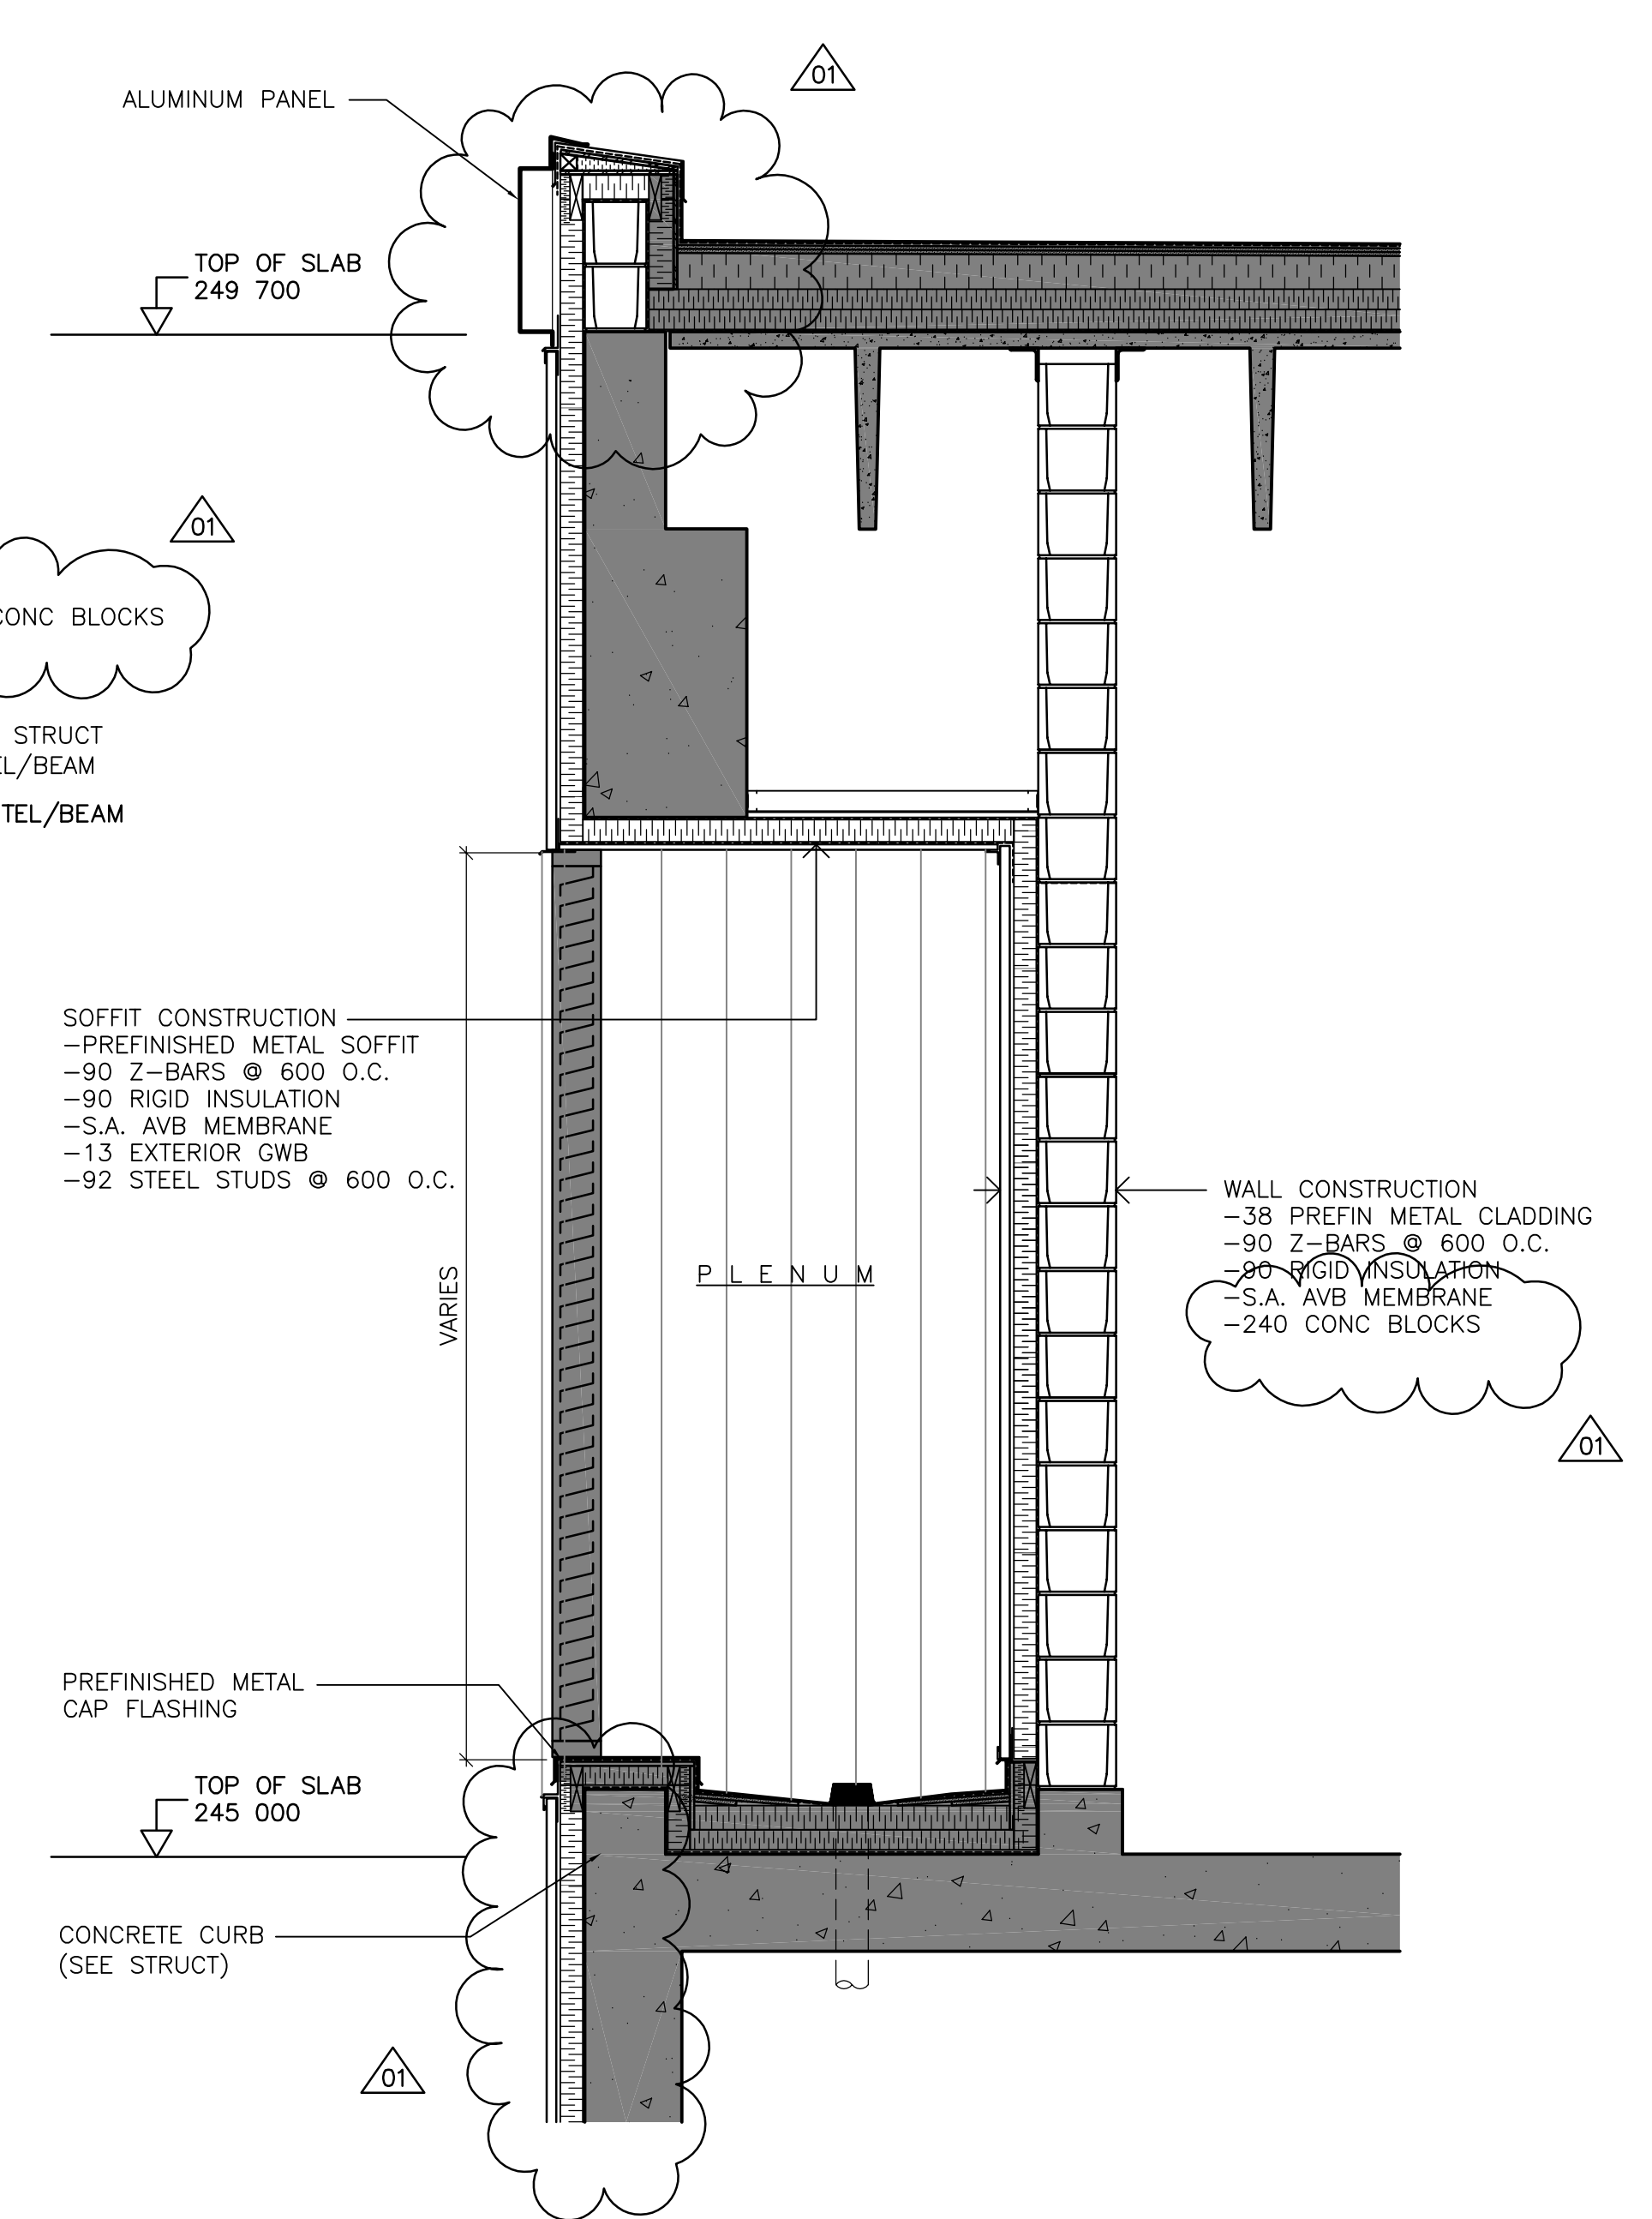

17 SECTION DETAIL @ MECHANICAL PLENUM (TYP)
WB-B0110 1:20



B.M. ELEV.					
01	793-2006 ADDENDUM 1	07/03/29	LK		
00	ISSUED FOR TENDER	07/03/19	LK		
	REVISIONS	DATE	BY	DATE	2006/01/13

 Frederickson Cooper ARCHITECTS		 A Tyco International Ltd. Company	
DESIGNED BY	NC	CHECKED BY	
DRAWN BY	LK	APPROVED BY	AHL
SCALE:	AS NOTED		
RELEASED FOR CONSTRUCTION BY:	R. SOROKOWSKI		
DATE	2006/01/13	DATE	2007/03/19

ENGINEER'S SEAL
ORIGINAL SIGNED BY
NEIL COOPER
2007/03/19
CONSULTANT DRAWING NO.
WB-B0406

 THE CITY OF WINNIPEG WATER AND WASTE DEPARTMENT ENGINEERING DIVISION	
WATER TREATMENT PLANT MAIN BUILDING BUILDING ENVELOPE	
ARCHITECTURAL DETAILS	CITY FILE NUMBER
	SHEET OF
	CITY DRAWING NUMBER
	1-0601B-A-B0406-001-01D