


**PLAN 1**  
 0 1000 2000 3000 mm SCALE 1:100  
 PARTIAL MAIN FLOOR PLAN

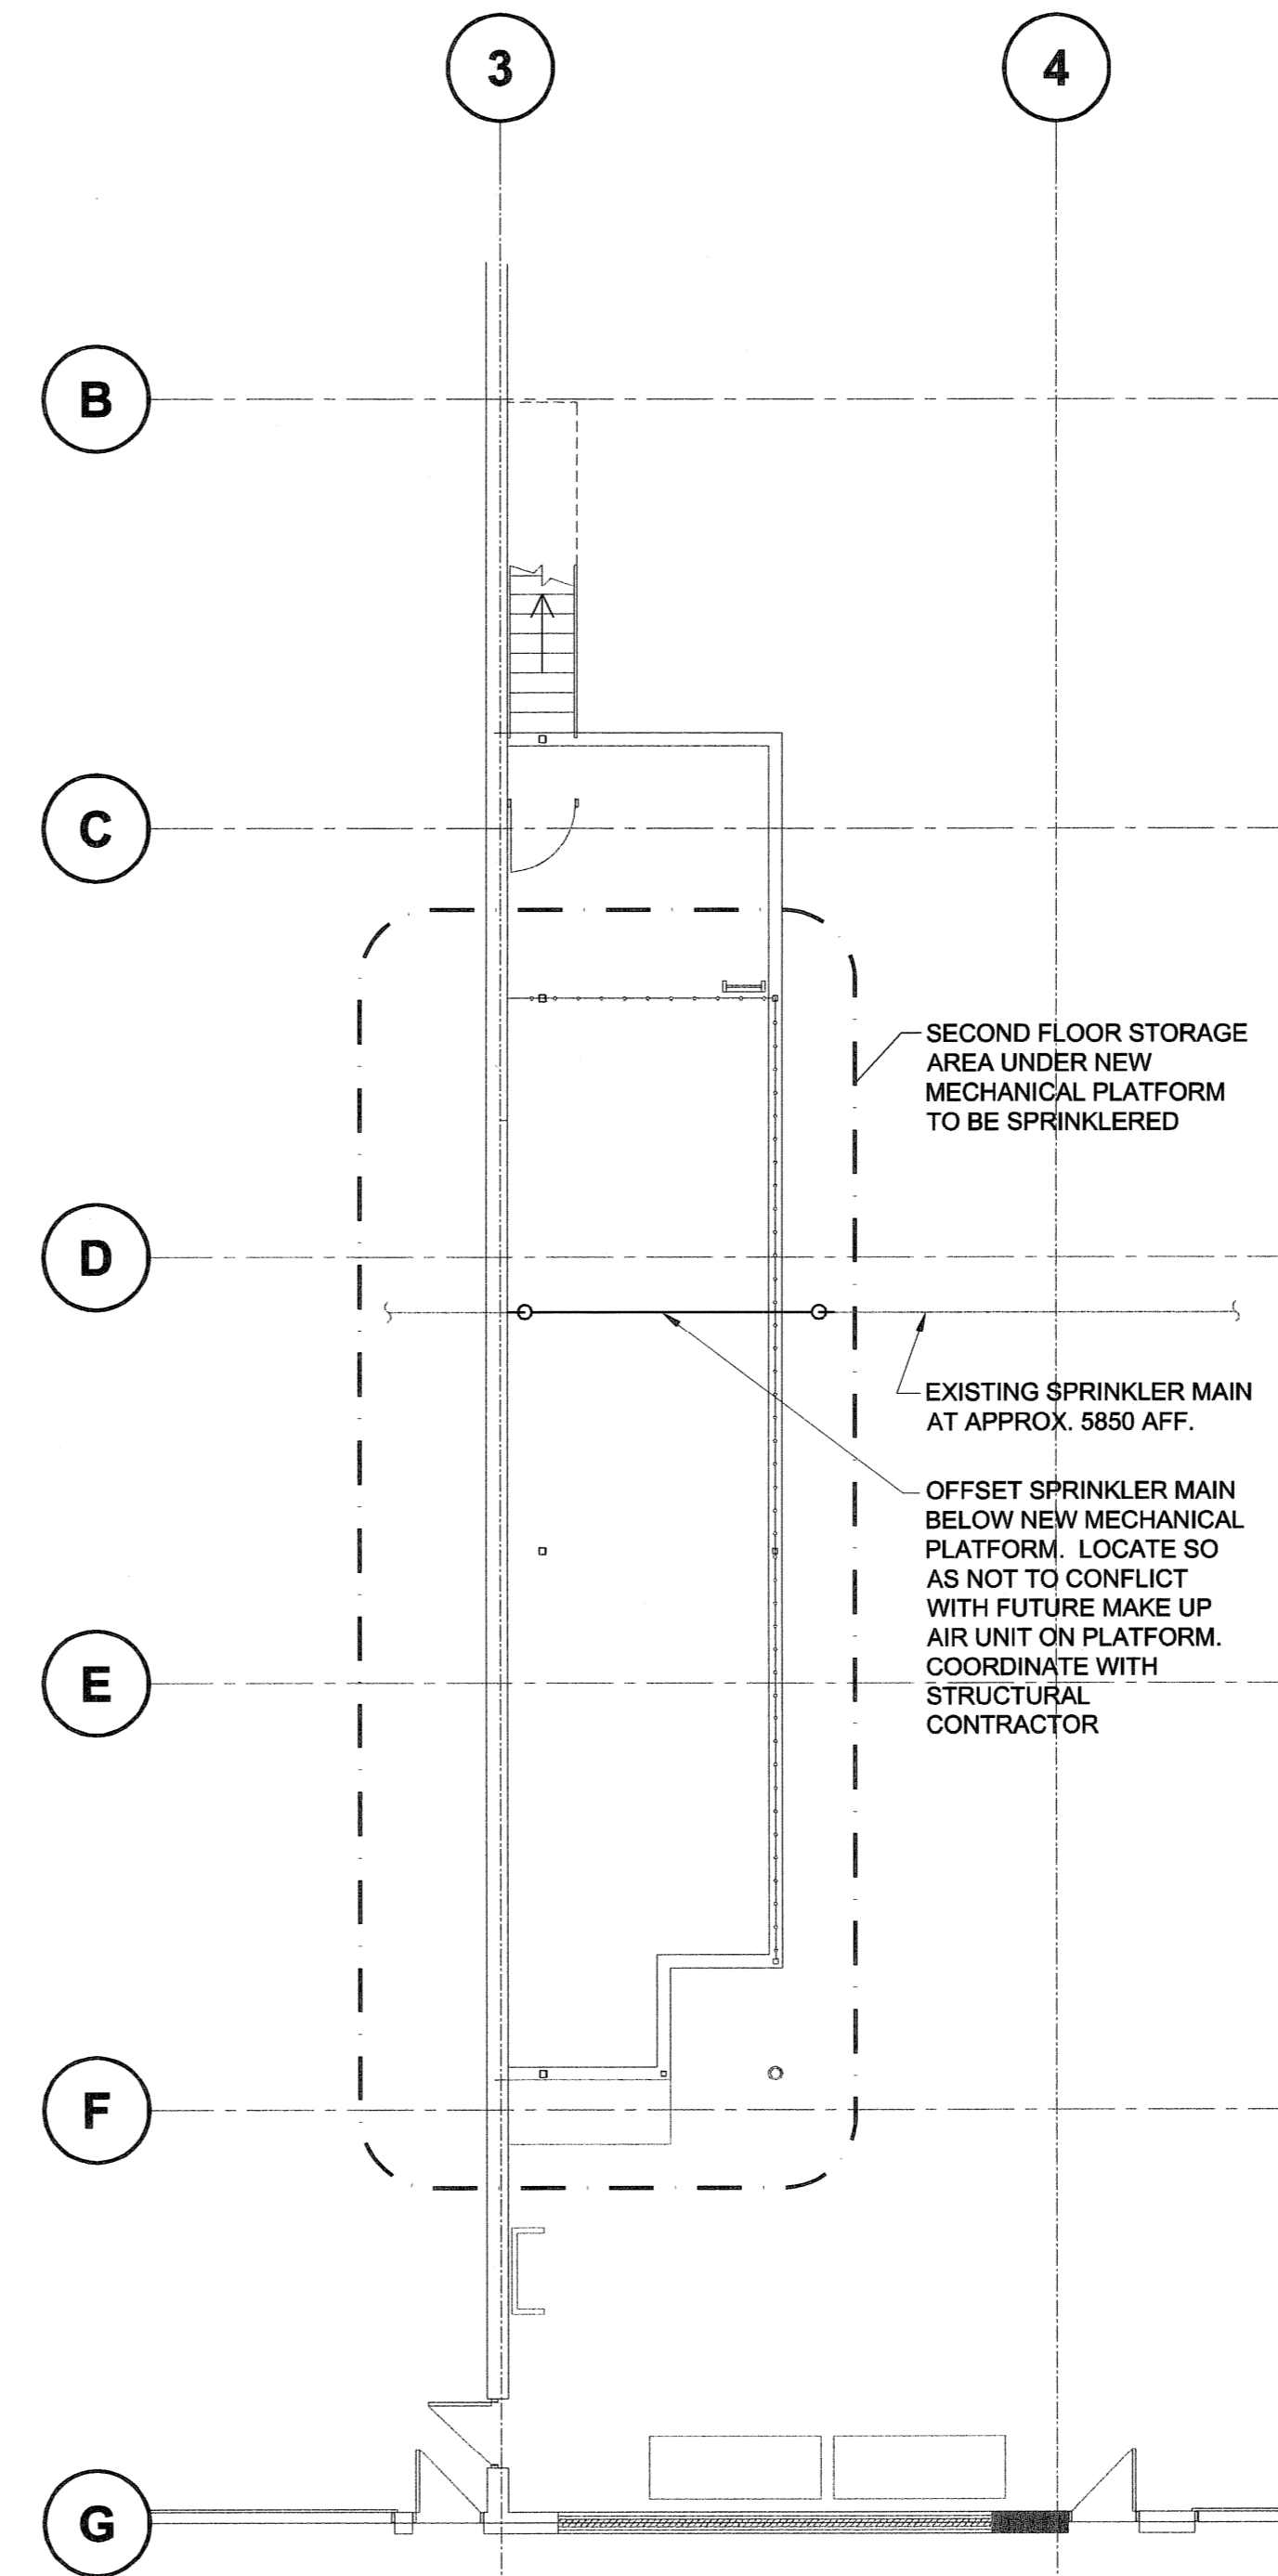

**PLAN 2**  
 0 1000 2000 3000 mm SCALE 1:100  
 STORAGE LEVEL PLAN

- NOTES :
- GENERAL NOTES:
1. THE SPRINKLER SYSTEM SHALL BE DESIGNED AND INSTALLED TO MEET THE REQUIREMENTS OF NFPA-13, STANDARD FOR THE INSTALLATION OF SPRINKLER SYSTEMS, 2007 EDITION.
  2. EXISTING GARAGE AREA IS SPRINKLERED.
  3. ADD NEW HEADS TO PROTECT STORAGE LEVEL AND MAIN FLOOR ROOM.
  4. RELOCATE OR ADJUST EXISTING HEADS AS REQUIRED TO SUIT EXISTING AIR MAKE UP UNIT ON NEW MECHANICAL PLATFORM.
  5. ALL SPACES AND ROOMS SHALL BE DESIGNED AS ORDINARY HAZARD GROUP 1 IN ACCORDANCE WITH NFPA-13 OR AS INDICATED.
  6. COORDINATE SPRINKLER HEAD LOCATIONS WITH ARCHITECTURAL DRAWINGS. COORDINATE SPRINKLER HEAD LOCATIONS WITH NEW LIGHTING, EXISTING LIGHTING, BULKHEADS, DIFFUSERS AND GRILLES IN NEW AND EXISTING CEILINGS.
  7. ALL SPRINKLER LINE PENETRATIONS THROUGH ALL WALLS ARE TO BE FIRESTOPPED.
  8. PROVIDE HEADS GUARDS ON ALL EXPOSED HEADS.

UMA | AECOM

© 2007 UMA ENGINEERING LTD. ALL RIGHTS RESERVED.

A	ISSUED FOR ADDENDUM No. 3	ALS	07/11/21
NO.	REVISION/DESCRIPTION	BY	DATE



DRAWN BY	ALS	CHECKED BY	-	APPROVED	-
DATE	2007.11.20	USER APPROVAL			

CITY OF WINNIPEG  
 PLANNING, PROPERTY &  
 DEVELOPMENT DEPARTMENT  
 CIVIC ACCOMMODATIONS DIVISION  
 300 - 65 GARRY ST. R3C 4K4

PROJECT  
 CONSTRUCTION OF OFFICE/GARAGE  
 RENOVATIONS AND STORAGE BUILDING  
 AT 1539 WAVERLEY STREET  
 1539 Waverley Street, Winnipeg, MB.

SHEET TITLE  
 MECHANICAL  
 NEW CONSTRUCTION - FIRE PROTECTION  
 GARAGE

DRN	CHK	DES	ENG	IDR
UMA REVIEW				

**APEGN**  
 Certificate of Authorization  
 UMA Engineering Ltd. (MB)  
 No. 256 Date: Nov 20 07

SCALE	PROJECT NO.	SHEET NO.
AS NOTED	0265-395-02	GAR - M1.3