


UMA FILE NAME: F863-001-01_E-2006_RX.dwg PLOT: 07/08/22 2:38:02 PM ADDRESS: 999 Sargent St. Winnipeg, Manitoba PROJECT No: F863-001-01 DESCRIPTION: ROOF PLAN HVAC DATE: 2007.02.21 FILE NAME: F863-001-01_A-2004_RX.dwg

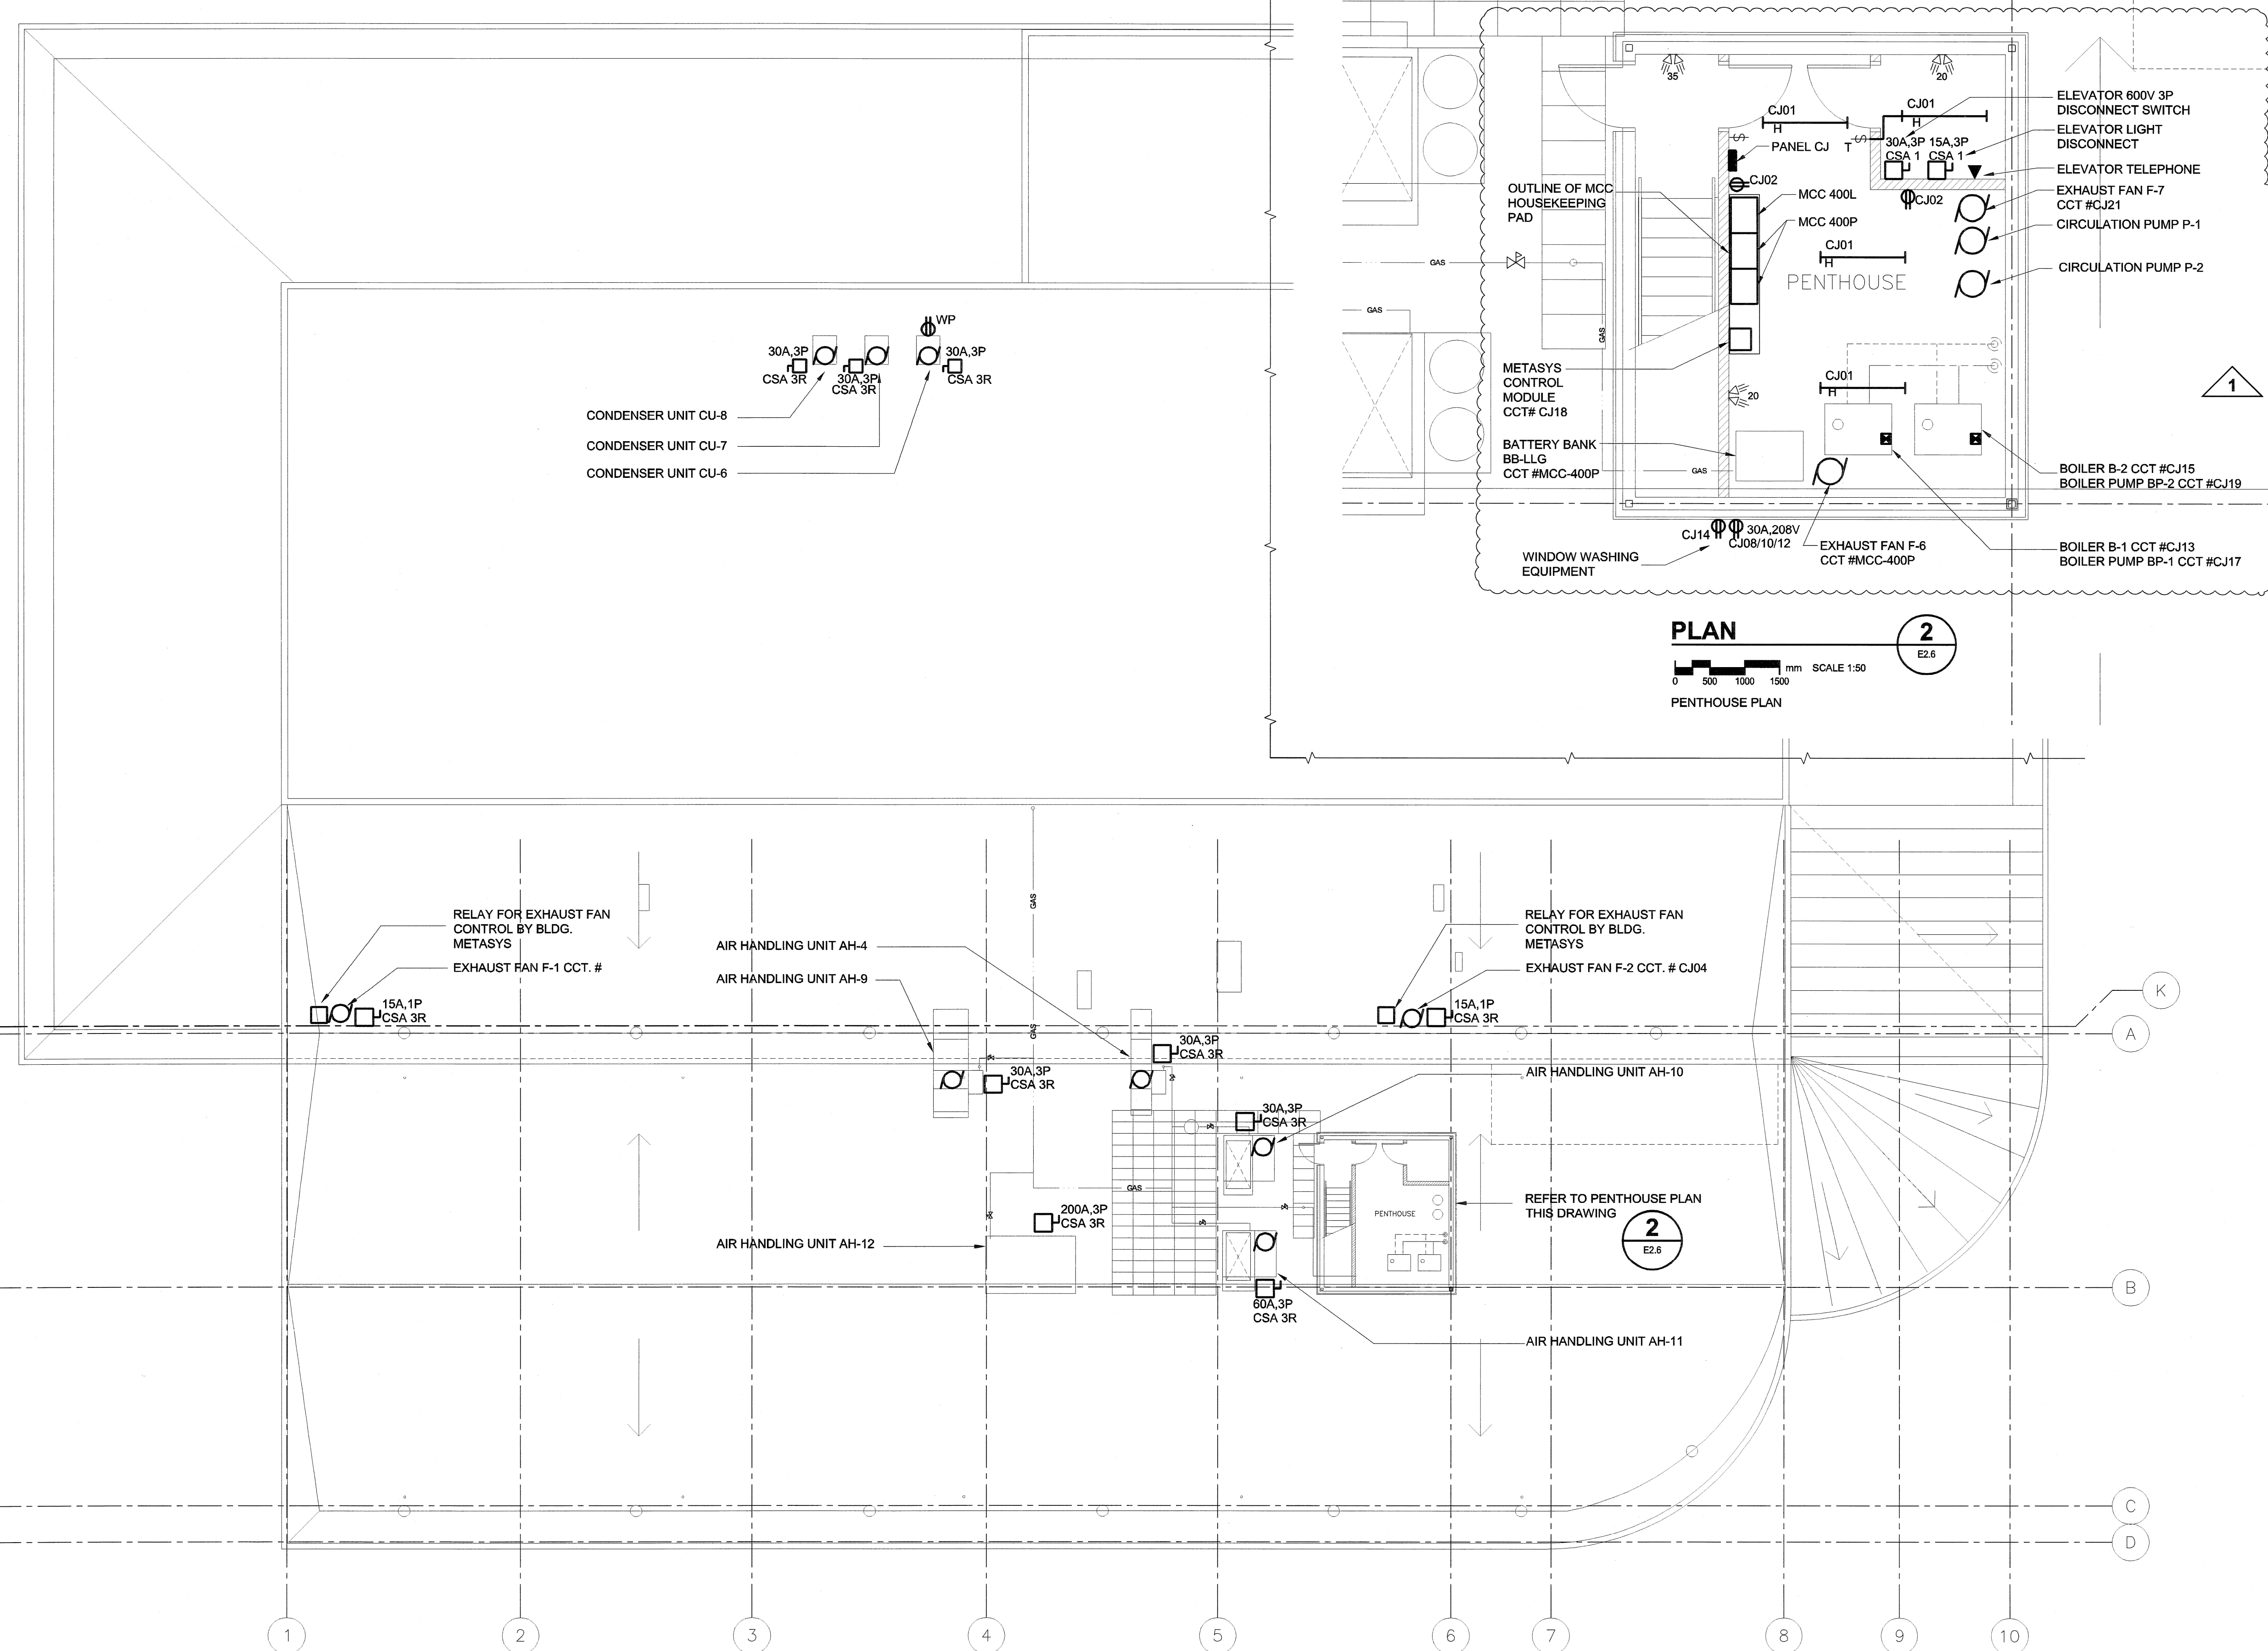

PLAN 1
 SCALE 1:150
 ROOF PLAN HVAC NEW CONSTRUCTION

PLAN 2
 SCALE 1:50
 PENTHOUSE PLAN

UMA | AECOM
 © 2007 UMA ENGINEERING LTD. ALL RIGHTS RESERVED.

APEGM
 Certificate of Authorization
 UMA Engineering Ltd. (MB)
 No. 256 Date: Aug 21, 2007

| | | | | |
|-----|-----|-----|-----|-----|
| DRN | CHK | DES | ENG | IDR |
| | | | | |

UMA | AECOM REVIEW

| | | | |
|---|------------------------|----|----------|
| 1 | ISSUED FOR ADDENDUM #2 | QL | 07/08/21 |
| 0 | ISSUED FOR TENDER | QL | 07/07/23 |

NO. REVISION/DESCRIPTION BY DATE

SEALS

PROVINCE OF MANITOBA
 S. SMART
 Member
 20996
 Aug 21, 2007
 REGISTERED PROFESSIONAL ENGINEER

DRAWN BY: SKK CHECKED BY: USER APPROVAL APPROVED
 DATE: 2007.07.17

CITY OF WINNIPEG
 PLANNING, PROPERTY & DEVELOPMENT DEPARTMENT
 CIVIC ACCOMMODATIONS DIVISION
 300 - 65 GARRY ST. R3C 4K4

PROJECT
 Construction of Cindy Klassen
 Recreation Complex Facility
 Enhancement Project
 999 Sargent St. Winnipeg, Manitoba

SHEET TITLE
 Electrical
 Roof and Penthouse Plan
 New Construction

| | | |
|----------|-------------|-----------|
| SCALE | PROJECT NO. | SHEET NO. |
| AS SHOWN | 2005-059 | E2.6 |

DRAWING SHEET SIZE: A1 (841mm x 594mm) PLOT 1:1