


MAIN FLOOR PLAN - MECHANICAL DEMOLITION
 SCALE: 1/8"=1'-0"

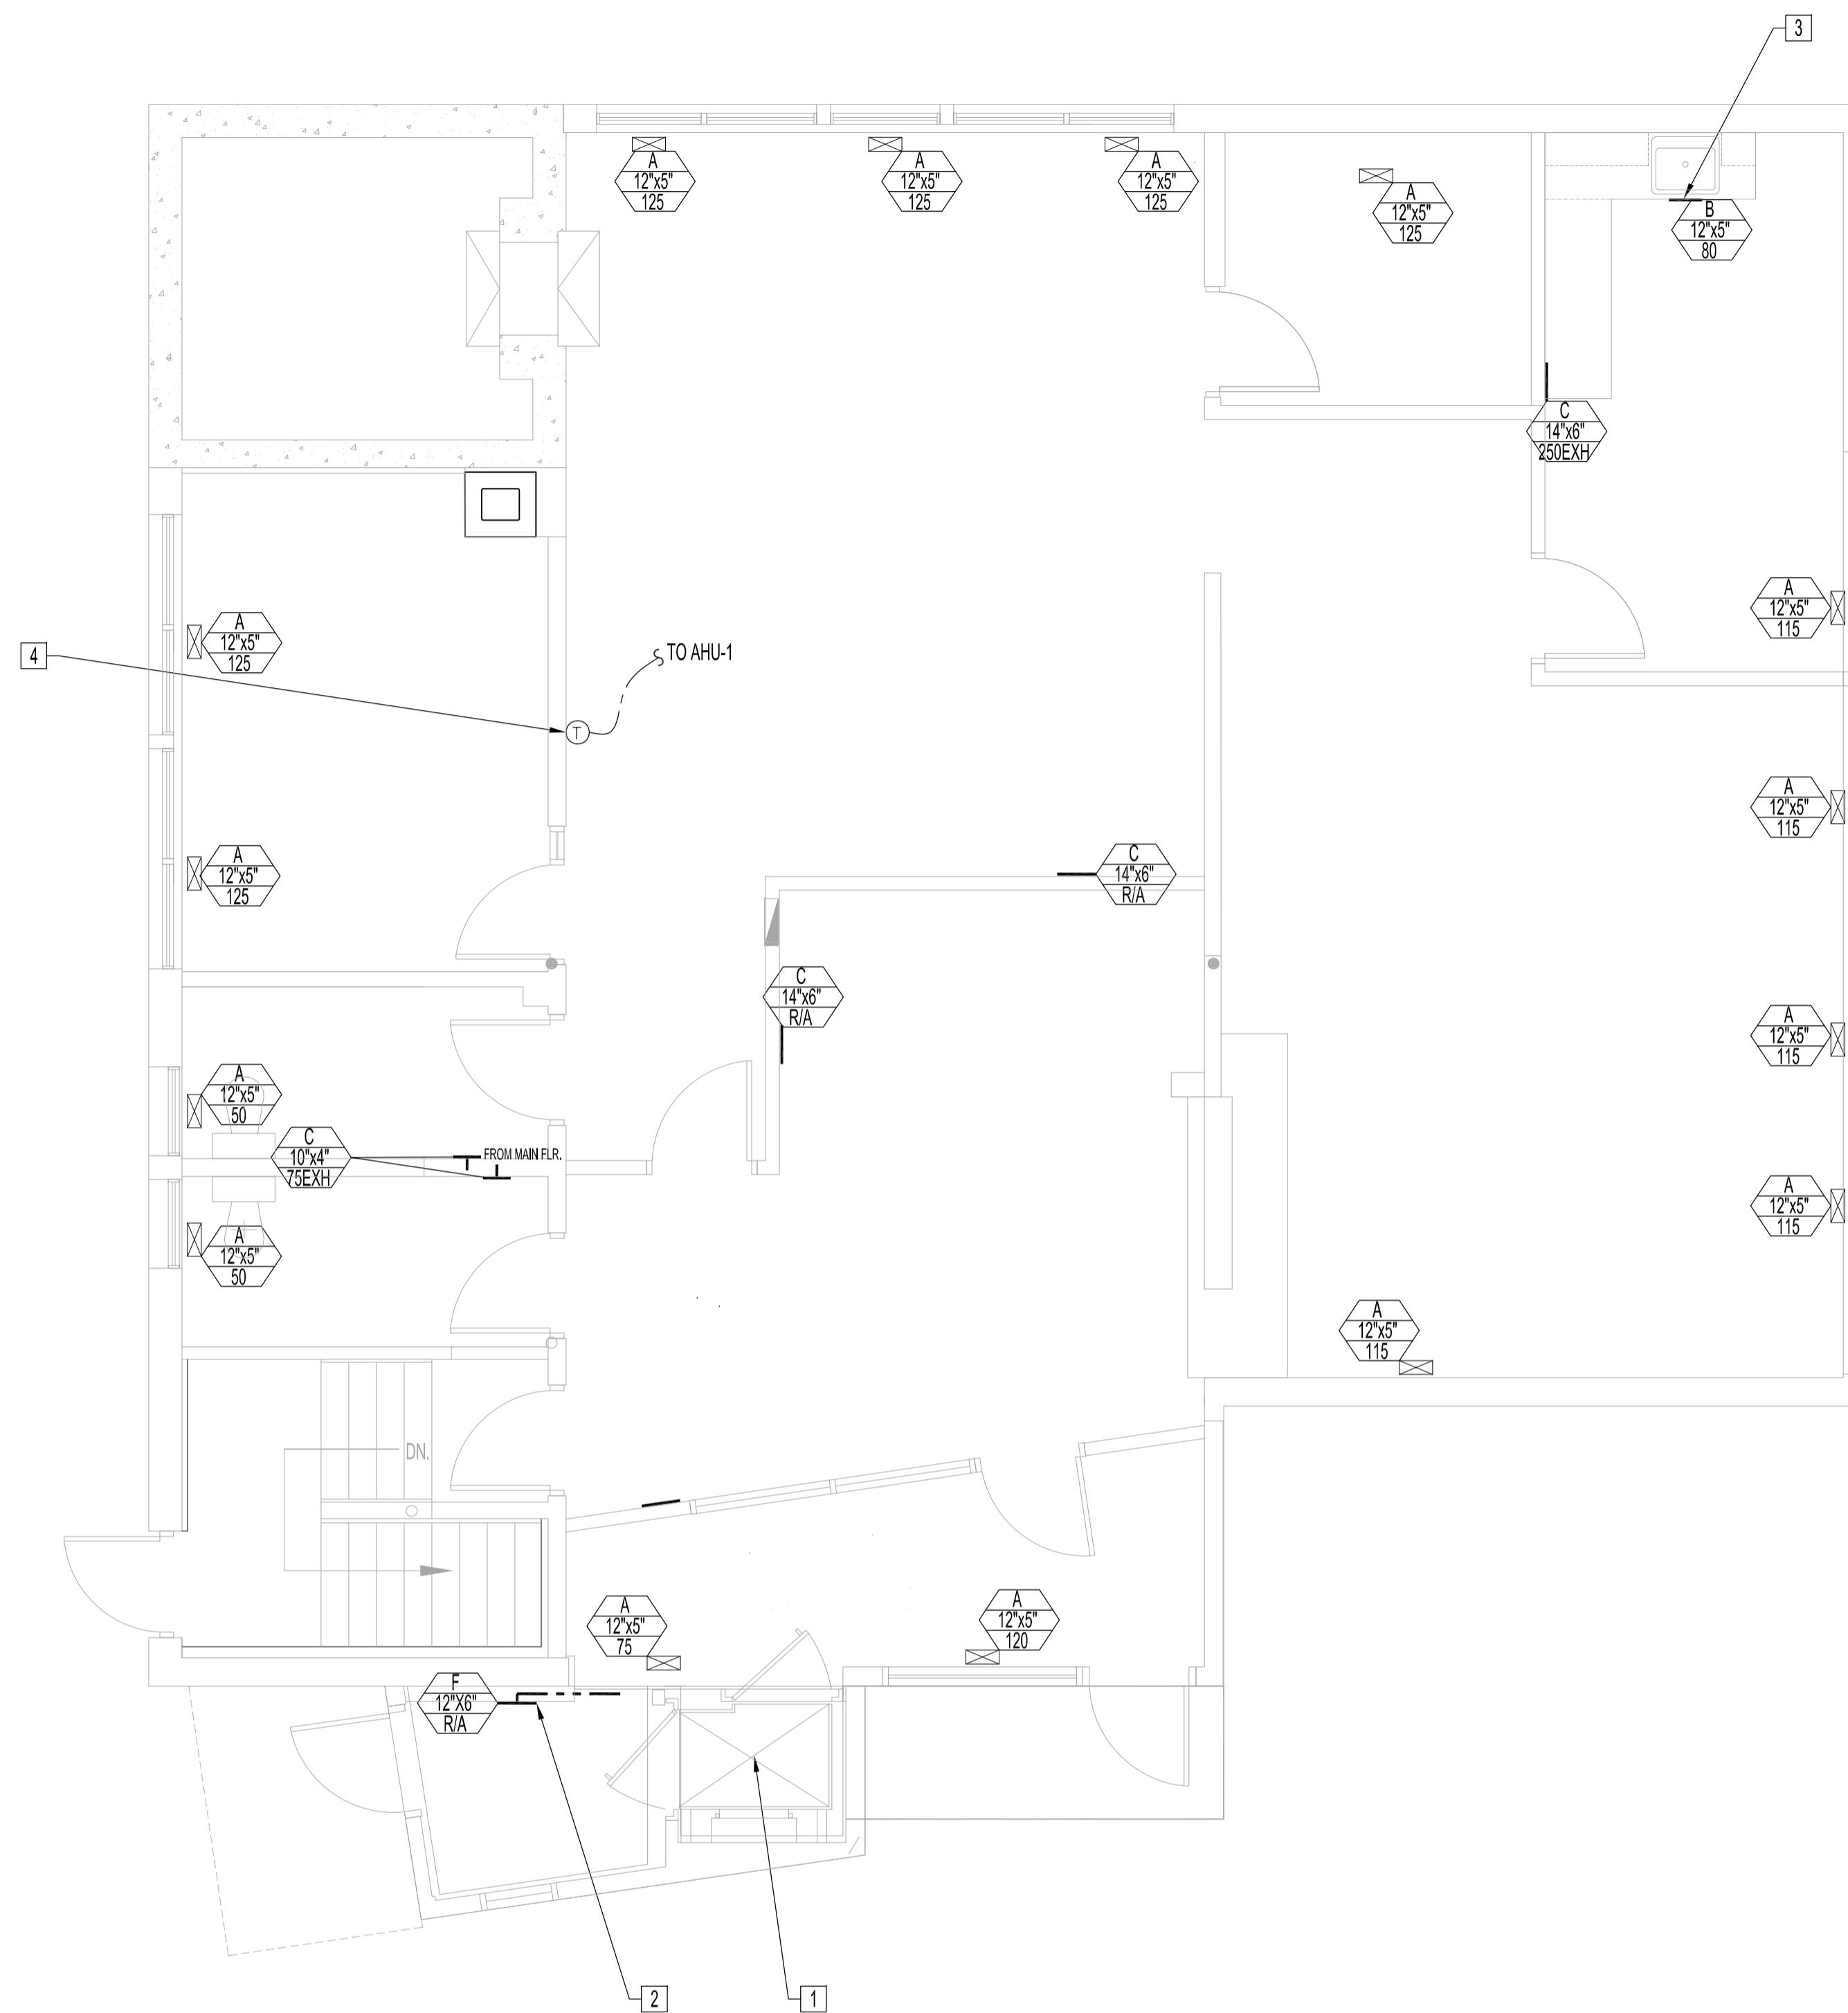

MAIN FLOOR PLAN- MECHANICAL RENOVATION
 SCALE: 1/4"=1'-0"

MECHANICAL DEMOLITION NOTES

- 1 REMOVE AND DISCARD COMPLETE EXISTING , SUPPLY AND RETURN DUCTWORK, DIFFUSERS, GRILLES, THERMOSTATS AND ALL ASSOCIATED MECHANICAL COMPONENTS FROM MAIN FLOOR.

MECHANICAL RENOVATION NOTES

SUPPLY & INSTALL, UNLESS OTHERWISE NOTED.

- 1 SUPPLY & INSTALL VERTICAL PLATFORM LIFT, SAVARIA MODEL V1504-STD, AS PER MANUFACTURER INSTALLATION INSTRUCTIONS, SEE NOTES ON DRAWING M1 & DRAWING E2 & E3.
- 2 RETURN AIR GRILLE ON WALL AT 12 FEET FROM FINISH LIFT VESTIBLE FLOOR. SEE DRAWING M2 MECH. RENOVATION NOTE 11 FOR DUCT ROUTE & SIZE.
- 3 SUPPLY AIR DIFFUSER AT KICKPLATE, SEE ARCHITECTURAL DRAWING.
- 4 THERMOSTAT AT 48" ABOVE FINISH FLOOR.

NOTES :

SEE NOTES ON DRAWING M1.

ORIGINAL STAMPED BY: DOUG PALEY, P. ENG.
 DATE: 2007.11.15

1 SEE ADDENDUM 4, BID OPPORTUNITY 629-2007, REVISED GRILLE DTA 2007.11.15 LOCATIONS, DUE TO CHANGE OF FIRE SEPARATION REQUIREMENTS.

NO.	REVISION/DESCRIPTION	BY	DATE
SEALS			

DRAWN BY	RCP/DTA	CHECKED BY	APPROVED
DATE	2007.10.11	USER	APPROVAL

CITY OF WINNIPEG
 PLANNING, PROPERTY &
 DEVELOPMENT DEPARTMENT
 CIVIC ACCOMMODATIONS DIVISION
 300 - 65 GARRY ST. R3C 4K4

PROJECT

COMMUNITY POLICE SERVICE CENTRE

1400 HENDERSON HWY.

SHEET TITLE

MAIN FLOOR PLAN
 MECHANICAL
 DEMOLITION & RENOVATION

SCALE	PROJECT NO.	SHEET NO.
AS SHOWN	2004-023	M3R1