


- 8 TYPICAL
- 9 LIGHT FIXTURE TYPE N IN VEST 136 TO BE CEILING MOUNTED IN SPACE BETWEEN BACK TO BACK CHANNELS AND TO SHINE DOWN INTO BRONX PARK LOGO.
- 10 INSTALL TYPE 'N' LIGHT FIXTURE ON HORIZONTAL WINDOW MULLION AT VERTICAL CROSS. MAKE ALL PROVISIONS TO COORDINATE CABLE INSTALLATION AND PROVIDE NECESSARY SUPPORT FOR FIXTURE INSTALLATION. MOUNTING HEIGHT OF ALL TYPE 'N' FIXTURES ON SOUTH WALL TO CORRESPOND WITH ARCHITECTURAL ELEVATIONS.
- 11 INSTALL ALL REMOTE BALLASTS FOR TYPE 'N' LIGHT FIXTURES IN CEILING SPACE (ABOVE T-BAR).

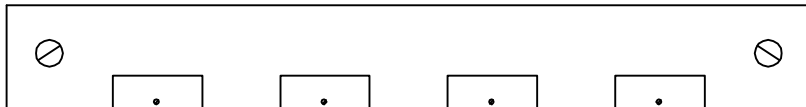

TOWER
ENGINEERING
GROUP

208-897 CORYDON AVE.
WINNIPEG, MB
TEL: (204) 925-1150
FAX: (204) 925-1155

PROJECT TITLE:
**BRONX PARK COMMUNITY CENTRE
WINNIPEG, MB**

DRAWING TITLE:
**ELECTRICAL REVISIONS
DWG E-2.0 PART PLAN**

FILE: ADD-02 JOB # 6150
DATE: FEB. 20/08
DRAWING NO. / REVISION NO.

ER-3