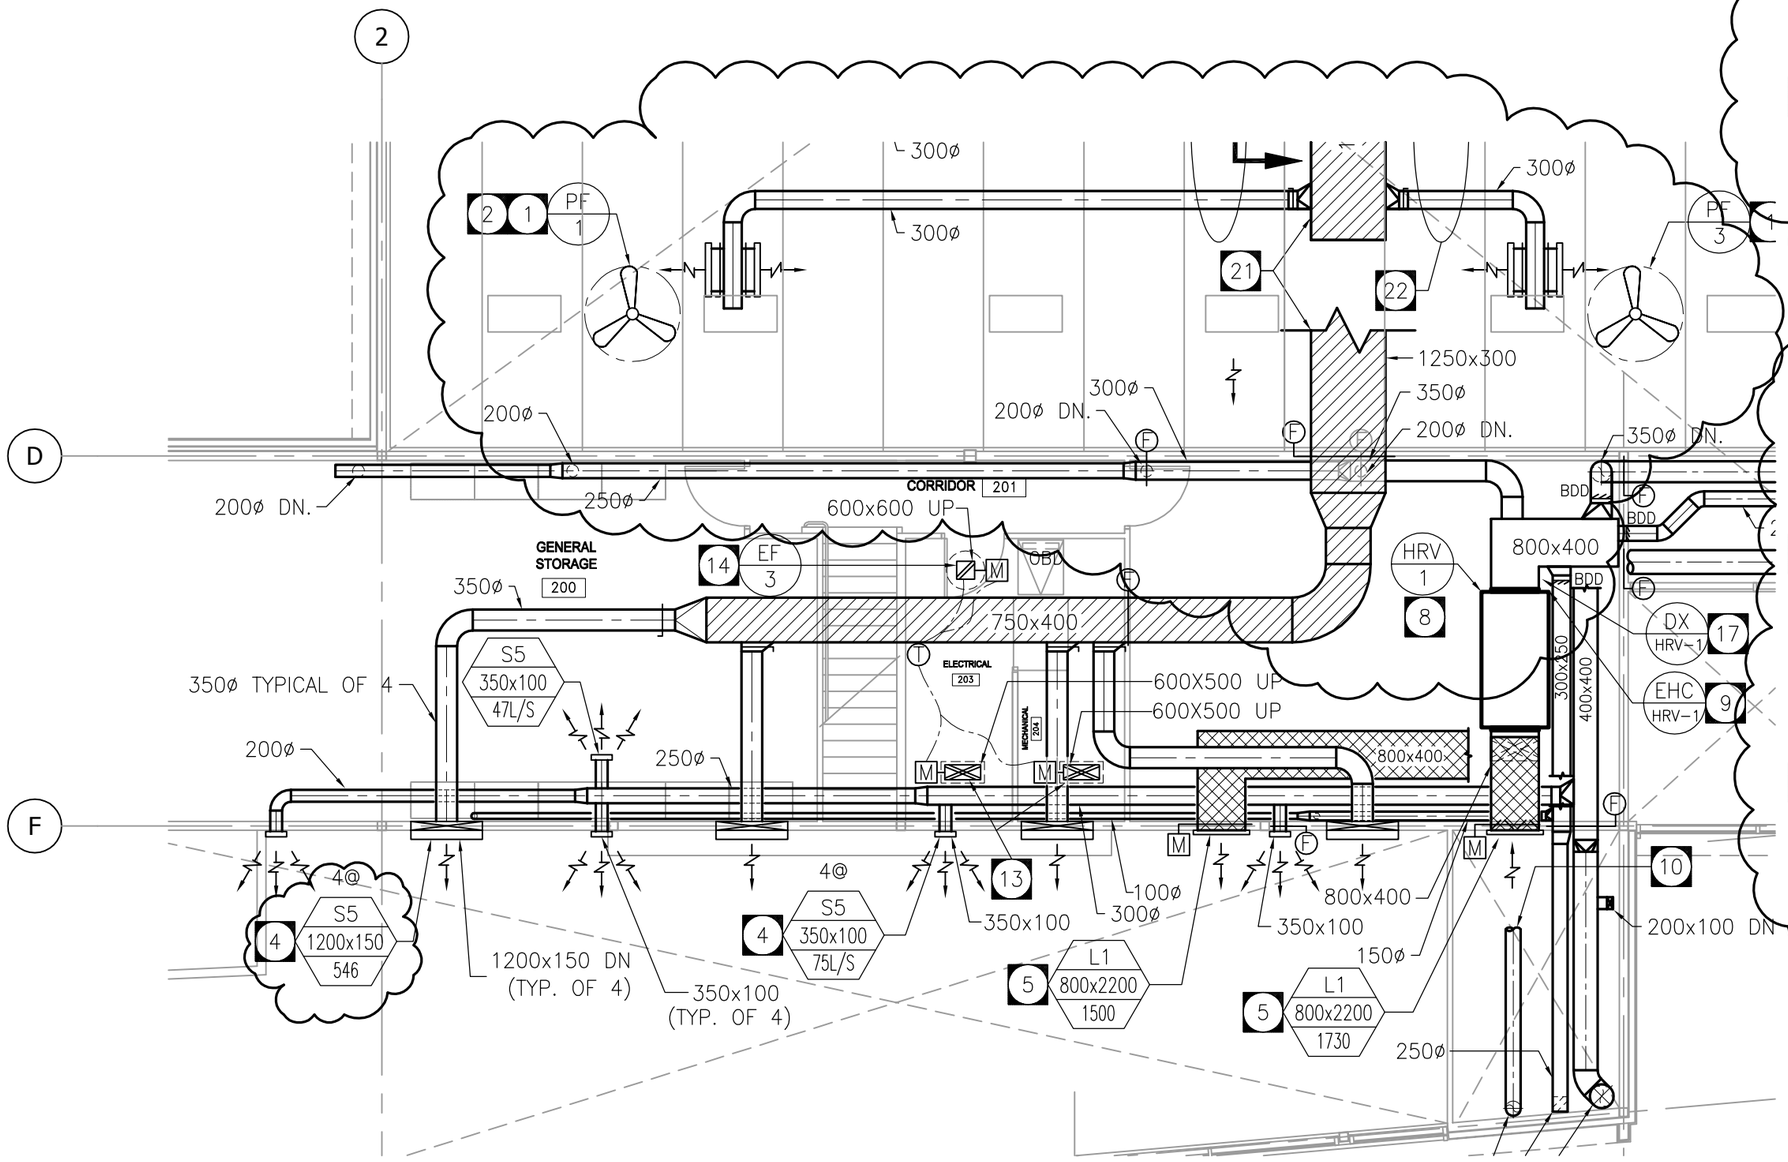

DRAWING NOTES:

6 ~~GAS FIRED AHU-1 COMPLETE WITH SPRING TYPE VIBRATION ISOLATION INSTALLED ON 100mm (4") CONCRETE HOUSEKEEPING PAD. PIPE AHU-1'S COOLING COIL CONDENSATE DRAIN PAN TO THE NEAREST SUITABLE FUNNEL FLOOR DRAIN. FOR GAS FIRED AHU-1 PROVIDE CHIMNEY, COMBUSTION AIR, AND VENTILATION AIR DUCTS TO MEET THE REQUIREMENTS OF THE GAS CODE AND THE AUTHORITIES HAVING JURISDICTION. PROVIDE COMBUSTION AIR AND VENTILATION AIR FROM MUSHROOM STYLE INTAKE HOODS LOCATED ON THE ROOF. TERMINATE DUCTS IN MECHANICAL ROOM AS PER GAS CODE AND THE REQUIREMENTS OF THE AUTHORITIES HAVING JURISDICTION.~~

7 ~~1200mm (48")x450mm (18") OUTSIDE AIR INTAKE DUCT, LOCATED BETWEEN THE JOISTS, UP TO MUSHROOM STYLE INTAKE HOOD ON THE ROOF. REFER TO MUSHROOM STYLE HOOD DETAIL. PAINT HOOD COLOUR AS DIRECTED BY CONTRACT ADMINISTRATOR.~~

11 ~~1200mm (48")x450mm (18") RELIEF AIR DUCT, LOCATED BETWEEN THE JOISTS, UP TO MUSHROOM STYLE RELIEF AIR HOOD ON THE ROOF. REFER TO MUSHROOM STYLE HOOD DETAIL. PAINT HOOD COLOUR AS DIRECTED BY CONTRACT ADMINISTRATOR.~~

DWG M-3.2 PART PLAN - SEPARATE SYSTEM IN LIEU OF AHU-1

SCALE: 1: 100

TOWER ENGINEERING GROUP
208-897 CORYDON AVE.
WINNIPEG, MB.
TEL: (204) 925-1150
FAX: (204) 925-1155

PROJECT TITLE:
BRONX PARK COMMUNITY CENTRE
WINNIPEG, MANITOBA

DRAWING TITLE:
SEPARATE PRICE ITEM 11
M-3.2 PART PLAN-SEPARATE SYSTEM

FILE: 6150-MS-06

DATE: FEB. 14, 2008

DRAWING NO. / REVISION NO.
MS-06