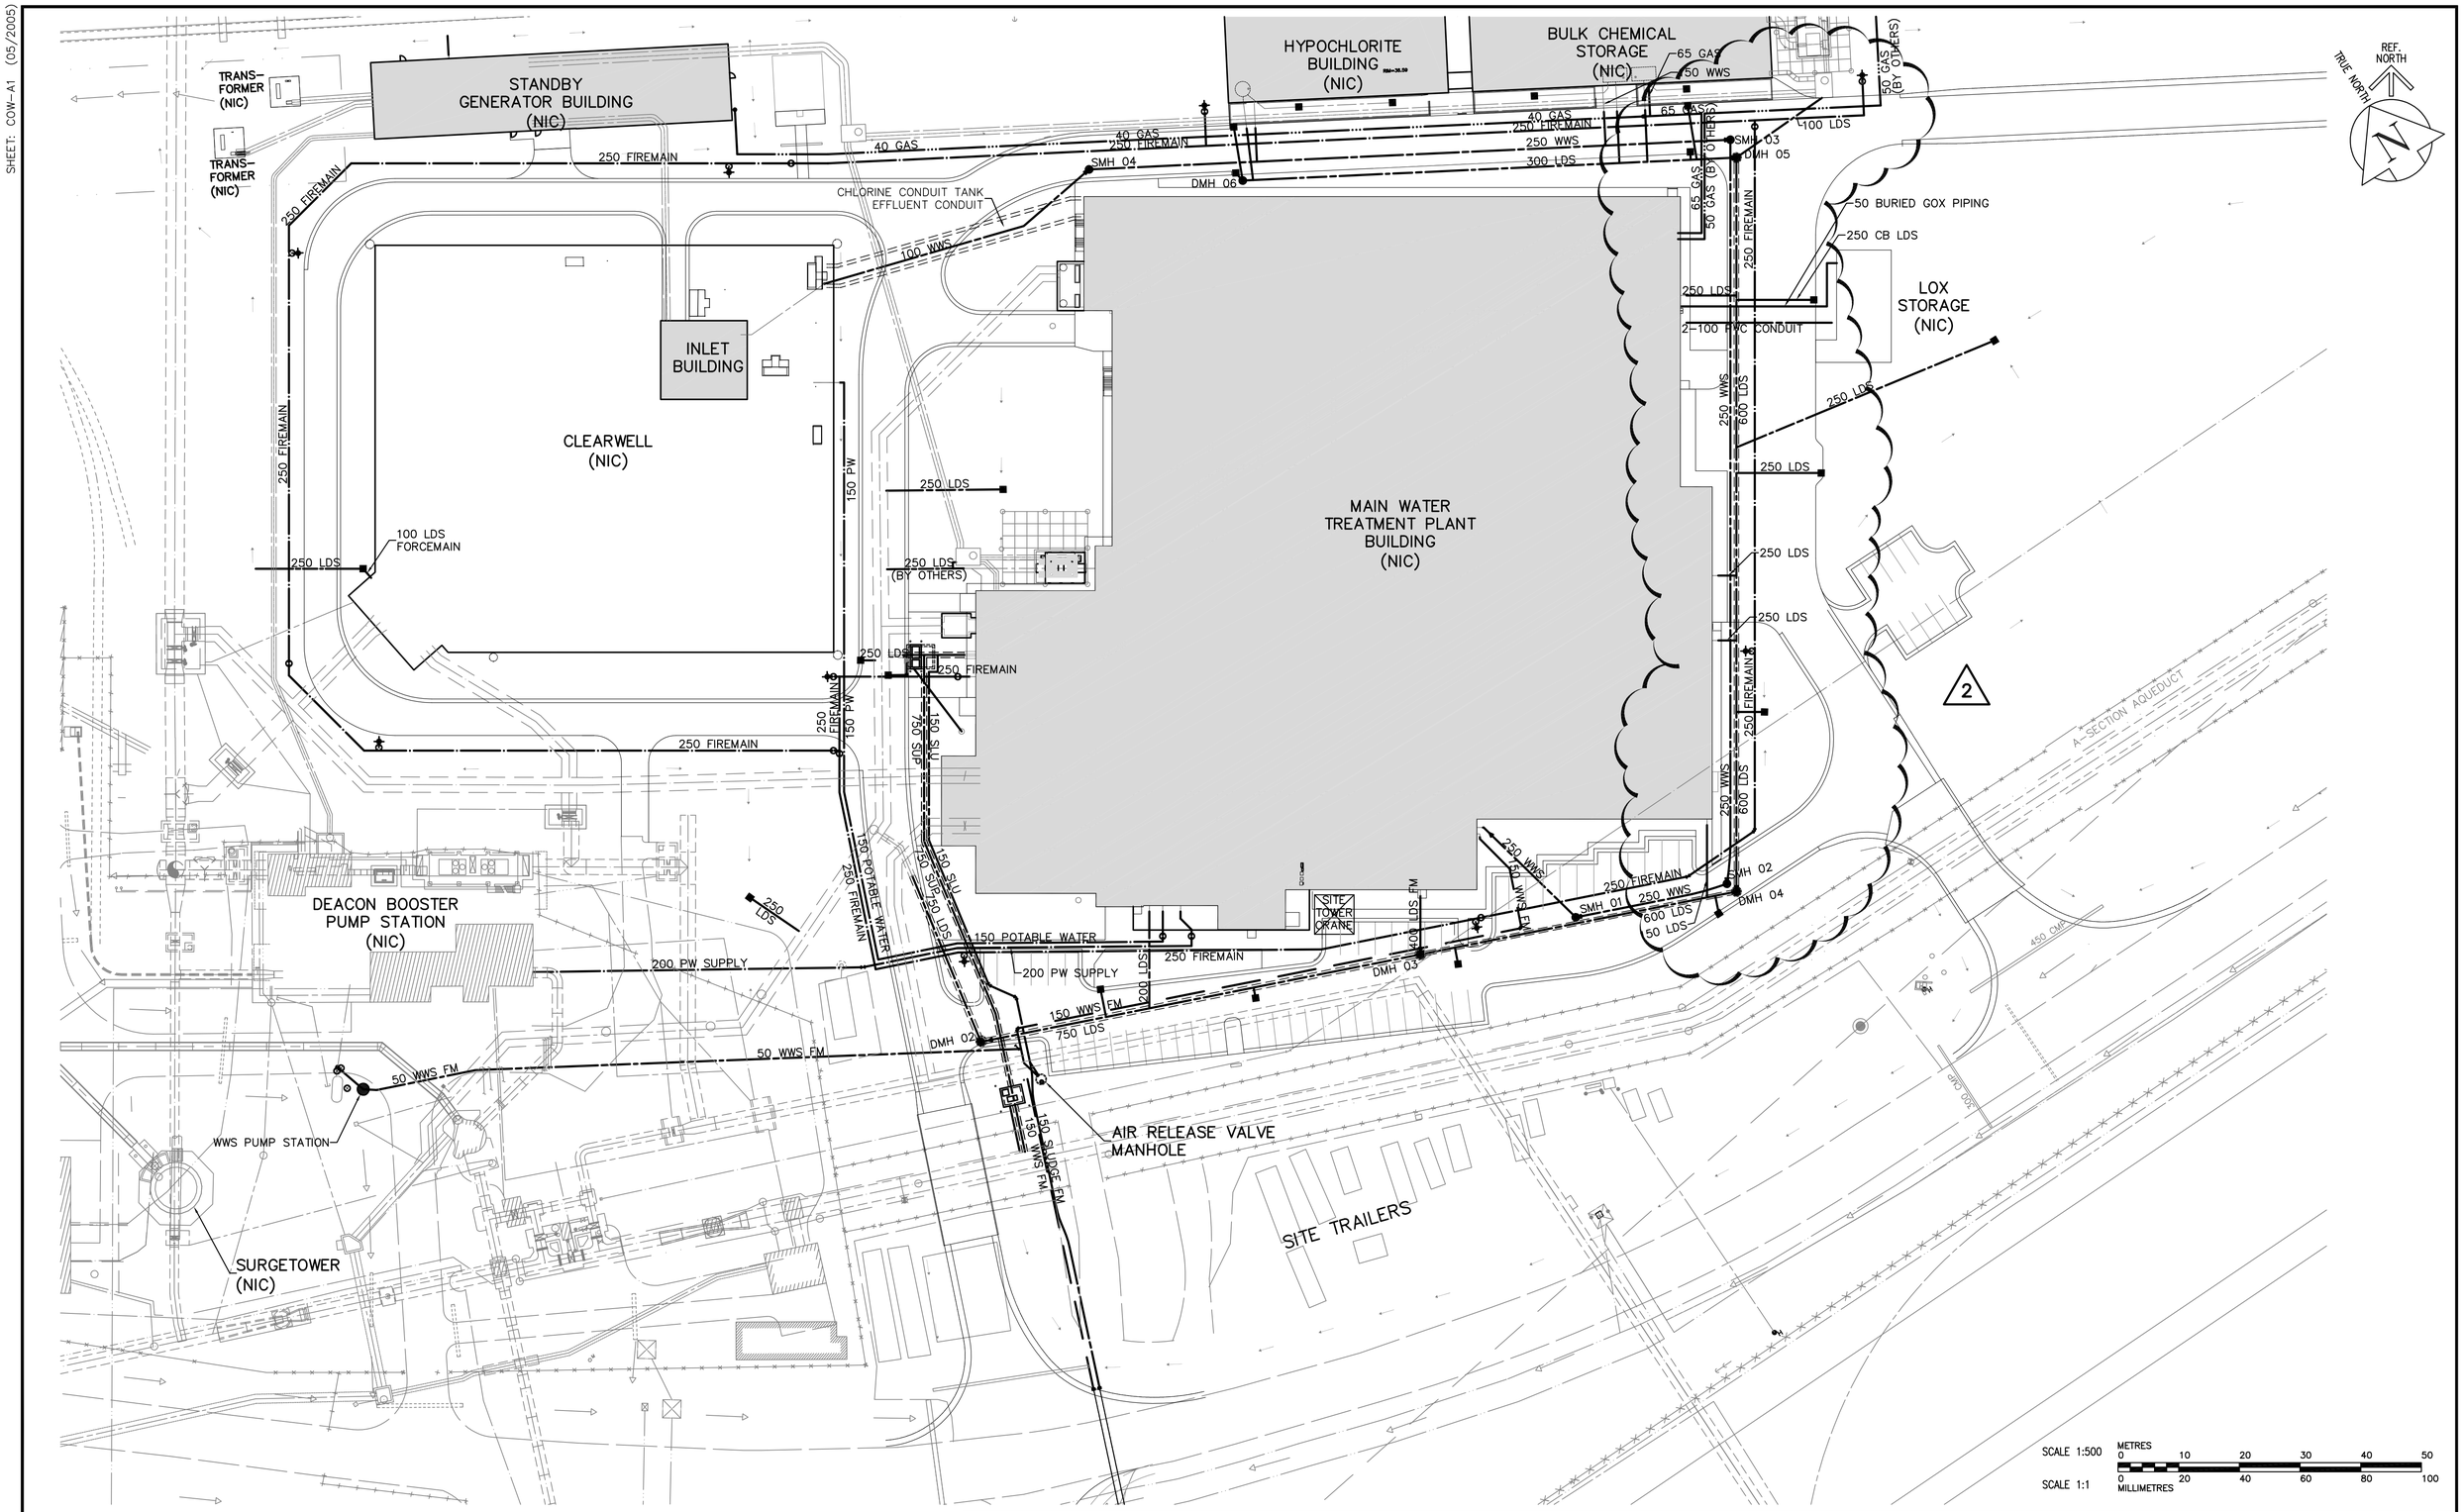

APEGM
Certificate of Authorization
Earth Tech Canada Inc.
No. 730 Expiry: April 30, 2007

B.M.
ELEV.

NO.	REVISIONS	DATE	BY
02	94-2007 ADDENDUM 3	07/06/05	GSK
01	REVISED CONTRACT LIMITS	07/04/05	GSK
00	ISSUED FOR TENDER (94-2007)	07/02/20	GSK

CH2MHILL
Frederickson Cooper ARCHITECTS
EarthTech A Tyco International Ltd. Company

DESIGNED BY	GSK	CHECKED BY	KF
DRAWN BY	JBC	APPROVED BY	AHL
SCALE:	1:500	RELEASED FOR CONSTRUCTION BY:	R. SOROKOWSKI
DATE	2006/11/21	DATE	2007/02/20

ENGINEER'S SEAL
ORIGINAL SIGNED BY
K.W. FITCHETT
2007/02/20

CONSULTANT DRAWING NO.
WH-C0100

Winnipeg
THE CITY OF WINNIPEG
WATER AND WASTE DEPARTMENT
ENGINEERING DIVISION

WATER TREATMENT PLANT
SITE UTILITIES

CIVIL
OVERALL LAYOUT

CITY FILE NUMBER
SHEET OF
CITY DRAWING NUMBER
1-0601H-C-C0100-001-02D

Last Save: 2007-06-05 9:19 PM

L:\WORK\79000\79538\02A-CAD\MUN\CONTR\SITE UTILITIES\DN_WH-C0100_ET.DWG